



\$PLTDRVGS \$MODELNAMES

\$DATES \$TIMES \$USERS\$CLIENTS\$FILELS

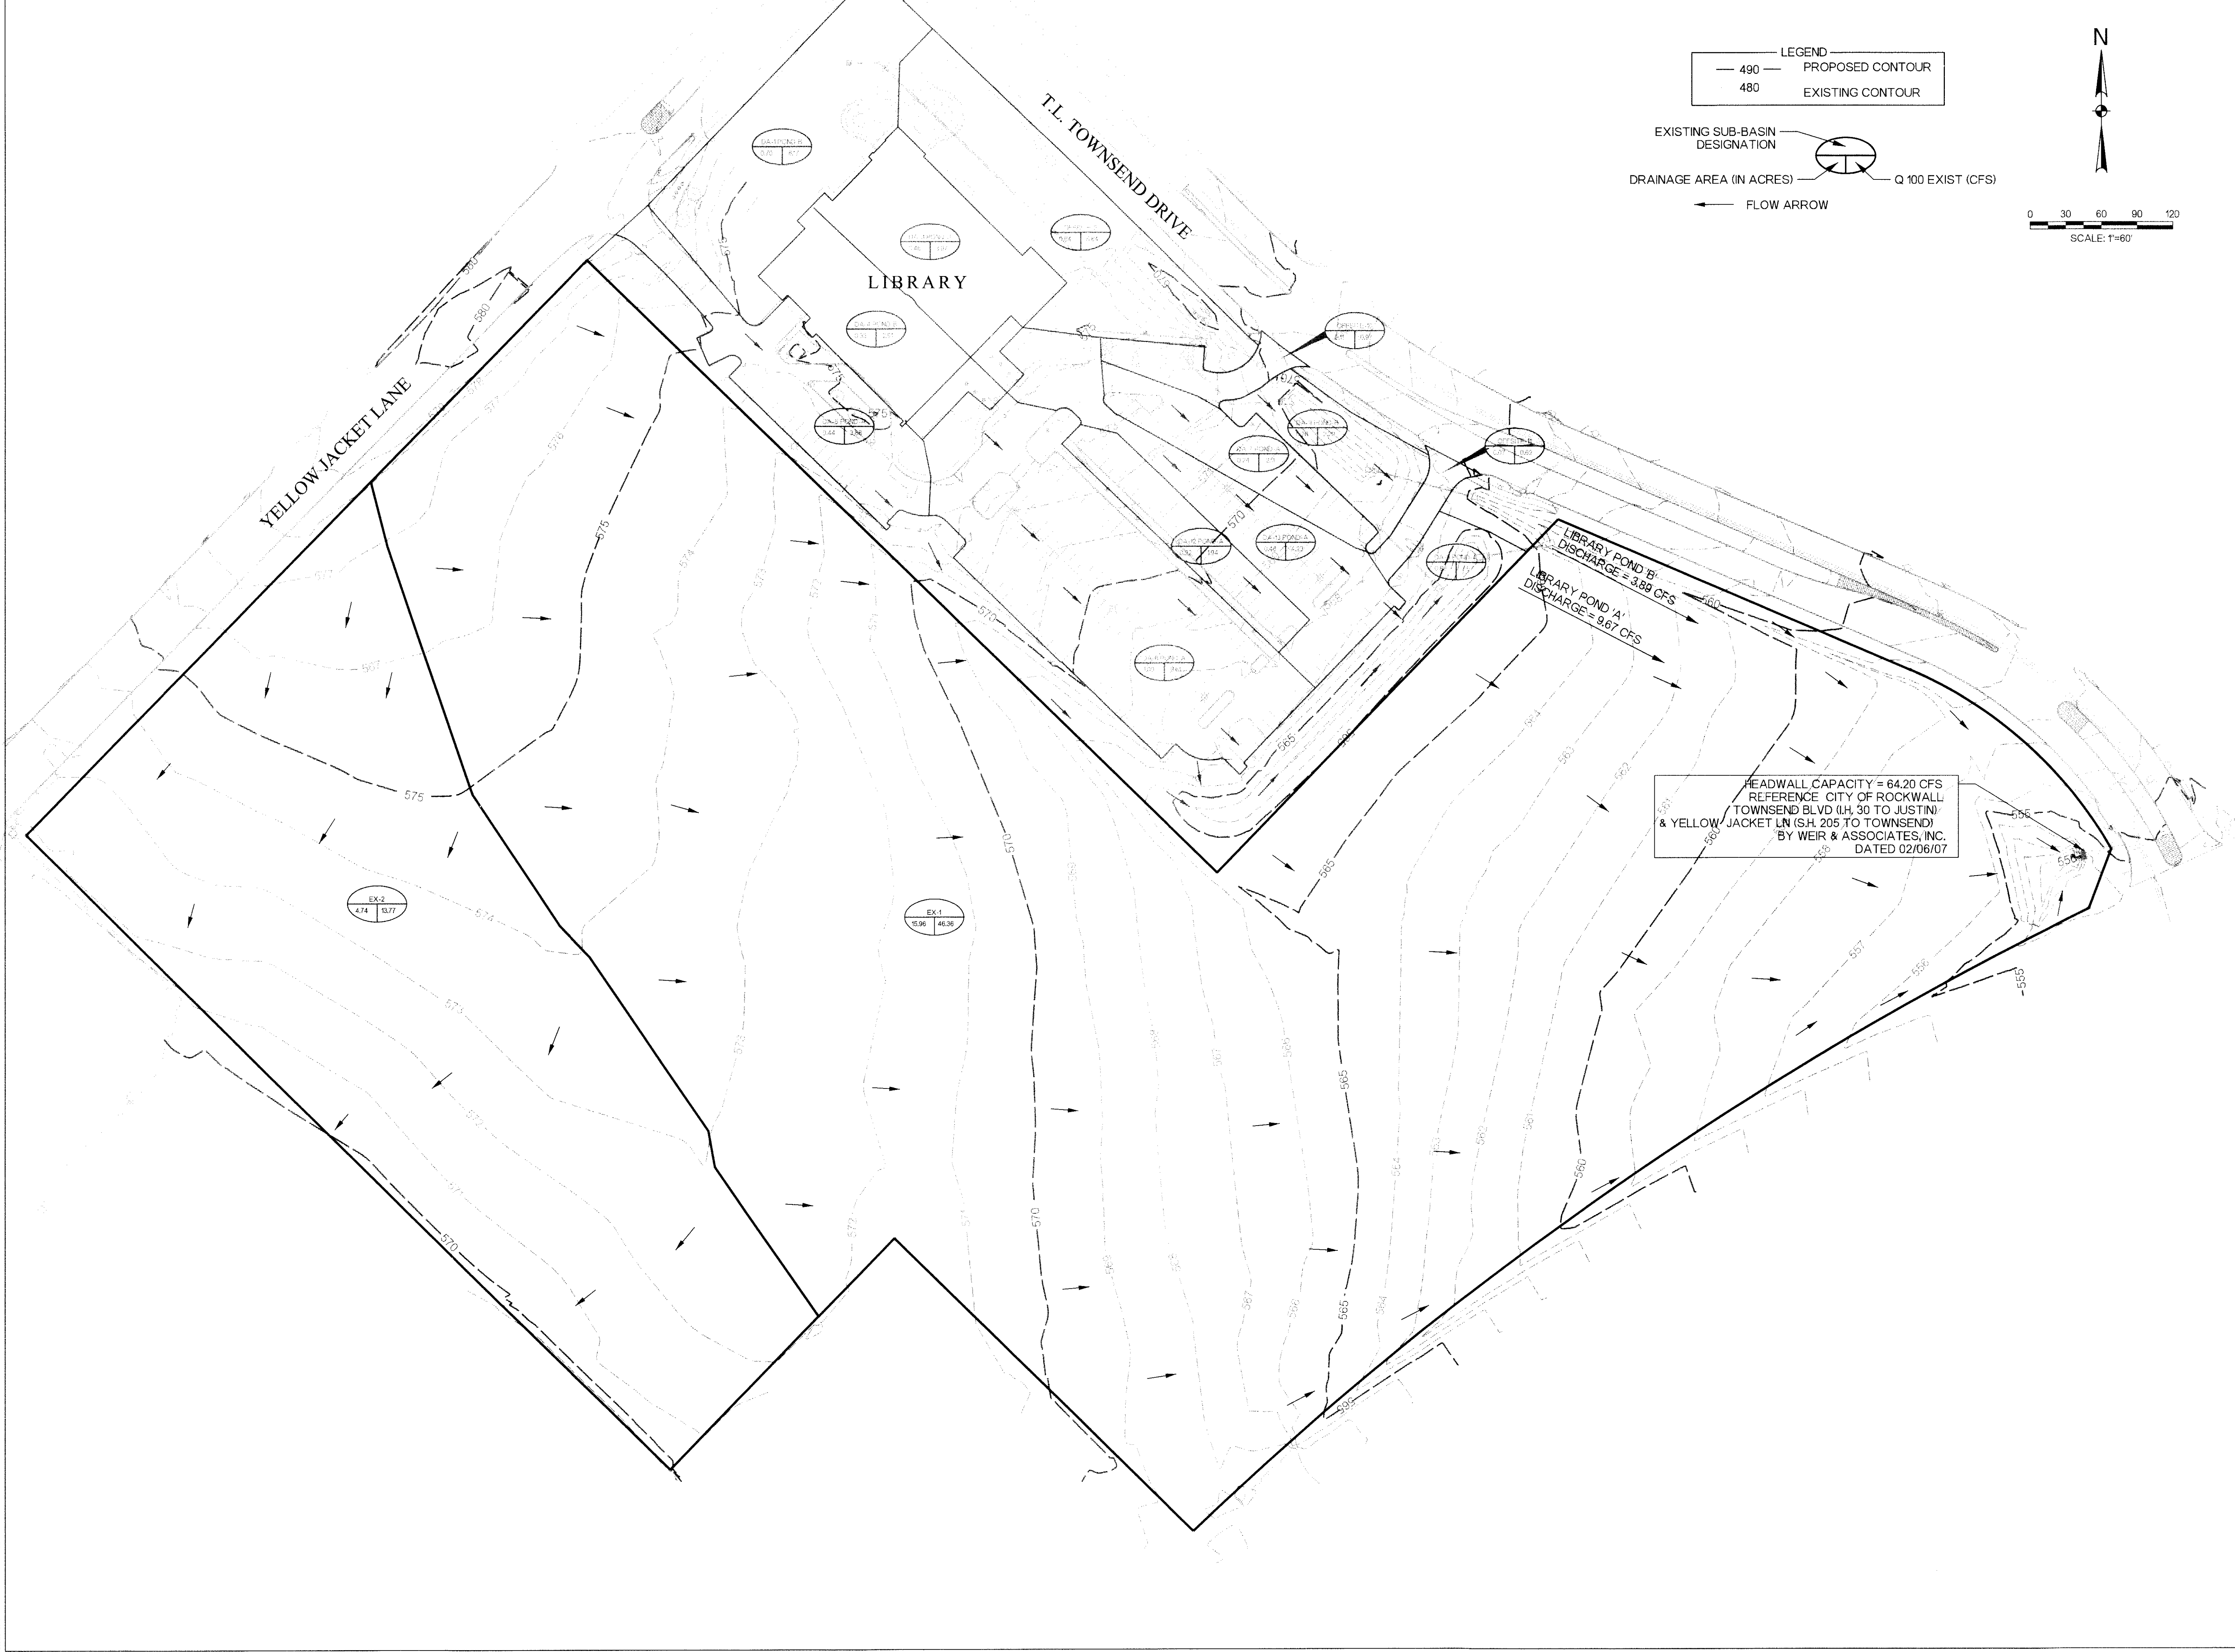

LEGEND  
 — 490 — PROPOSED CONTOUR  
 — 480 — EXISTING CONTOUR

EXISTING SUB-BASIN DESIGNATION  
 DRAINAGE AREA (IN ACRES) Q 100 EXIST (CFS)  
 — FLOW ARROW

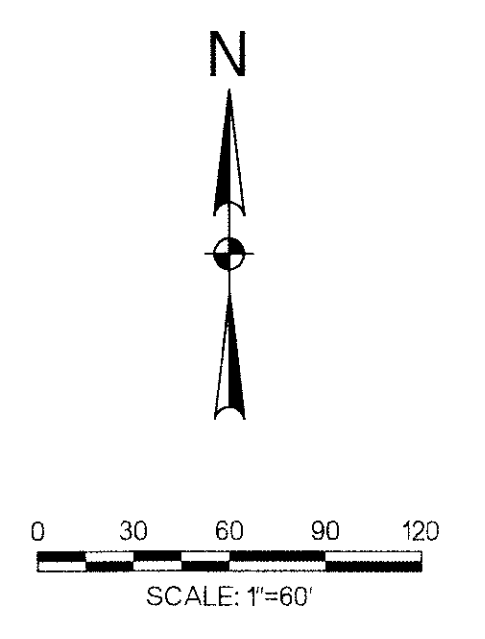

**ROCKWALL COUNTY COURTHOUSE**  
 ROCKWALL COUNTY  
 ROCKWALL, TEXAS

**HALFF**  
 200 N. STATE HIGHWAY 480 SUITE 450  
 ROCKWALL, TEXAS 75087-1487  
 TEL: (972) 241-2270  
 FAX: (972) 241-2270  
 TBPE FIRM # 312

Revision No.	Date	Description

**RECORD DRAWING**  
 APRIL, 2011  
 These Record Documents have been prepared based upon information provided by Manhattan Construction. The Design Professional has not verified the accuracy and / or completeness of this information and shall not be responsible for any errors or omissions which may be incorporated herein as a result.  
 Design Consultant: Half Associates, Inc.  
 RECORD DRAWING SUBMITTAL

*Stephen B. Crawford*  
  
 5-5-10

Project No.	26244
Issued:	APRIL 2011
Drawn By:	BJG
Checked By:	SBC
Scale:	AS NOTED
Sheet Title	EXISTING DRAINAGE CONDITIONS
Sheet Number	C5.01