
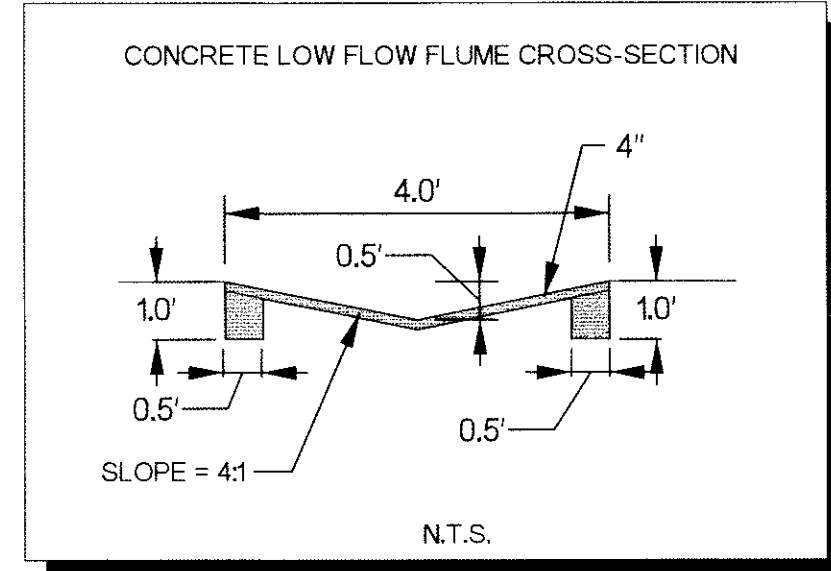



ALL RESPONSIBILITY FOR ADEQUACY OF DESIGN REMAINS WITH THE DESIGN ENGINEER. THE CITY OF ROCKWALL, IN REVIEWING AND RELEASING PLANS FOR CONSTRUCTION, ASSUMES NO RESPONSIBILITY FOR ADEQUACY OR ACCURACY OF DESIGN.

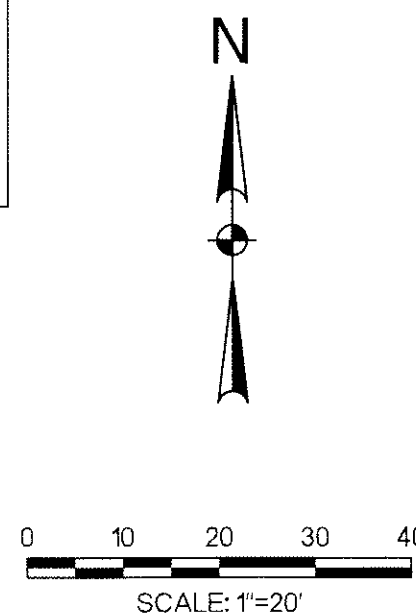

**GRADING LEGEND**

- ← FLOW ARROW
- 2% SLOPE
- 565 — EXISTING CONTOUR
- EX. 579.50 EXISTING SPOT ELEVATION
- 565 — PROP FINISHED GRADE CONTOUR
- 573.70 PROP FINISHED GRADE ELEVATION
- BW=573.73 PROP BOTTOM OF WALL

- NOTES:
1. ALL SPOT GRADES ARE TO TOP OF PAVEMENT UNLESS OTHERWISE NOTED AS TC (TOP OF CURB) OR OTHERWISE.
  2. CROSS SLOPES ON PERIMETER SIDEWALKS SHALL NOT EXCEED 2%.
  3. FINAL GRADING IN LANDSCAPE ISLANDS SHALL BE A MINIMUM OF 6" AND A MAXIMUM OF 10" ABOVE TOP OF CURB.
  4. CONTRACTOR SHALL FIELD VERIFY SPOT ELEVATIONS OF EXISTING DRIVES THAT ARE SHOWN ON THE PLANS. CONTRACTOR SHALL CONTACT ENGINEER IF DISCREPANCIES ARE FOUND.
  5. CONTRACTOR IS TO INSURE POSITIVE DRAINAGE AWAY FROM THE BUILDING. IF POSITIVE DRAINAGE CANNOT BE MAINTAINED OR IF THERE IS A DISCREPANCY WITH EXISTING CONDITIONS THE CONTRACTOR SHALL NOTIFY THE ENGINEER PRIOR TO PAVING.
  6. EXISTING GRADES SHOWN DO NOT REFLECT DIRT STOCKPILES ON SITE.
  7. L.A.G. = LOWEST ADJACENT GRADE IS ELEVATION OF BUILDING AT ADJACENT GROUND OUTSIDE OF BUILDING
  8. ALL FILL TO BE COMPACTED TO A MIN 95% STD. DENSITY USING A SHEEP FOOT ROLLER.
  9. THE SIDE SLOPES AND BOTTOM OF POND SHALL BE STABILIZED WITH EITHER ANCHORED SEEDED CURLEX OR SOD PRIOR TO ANY PAVING.

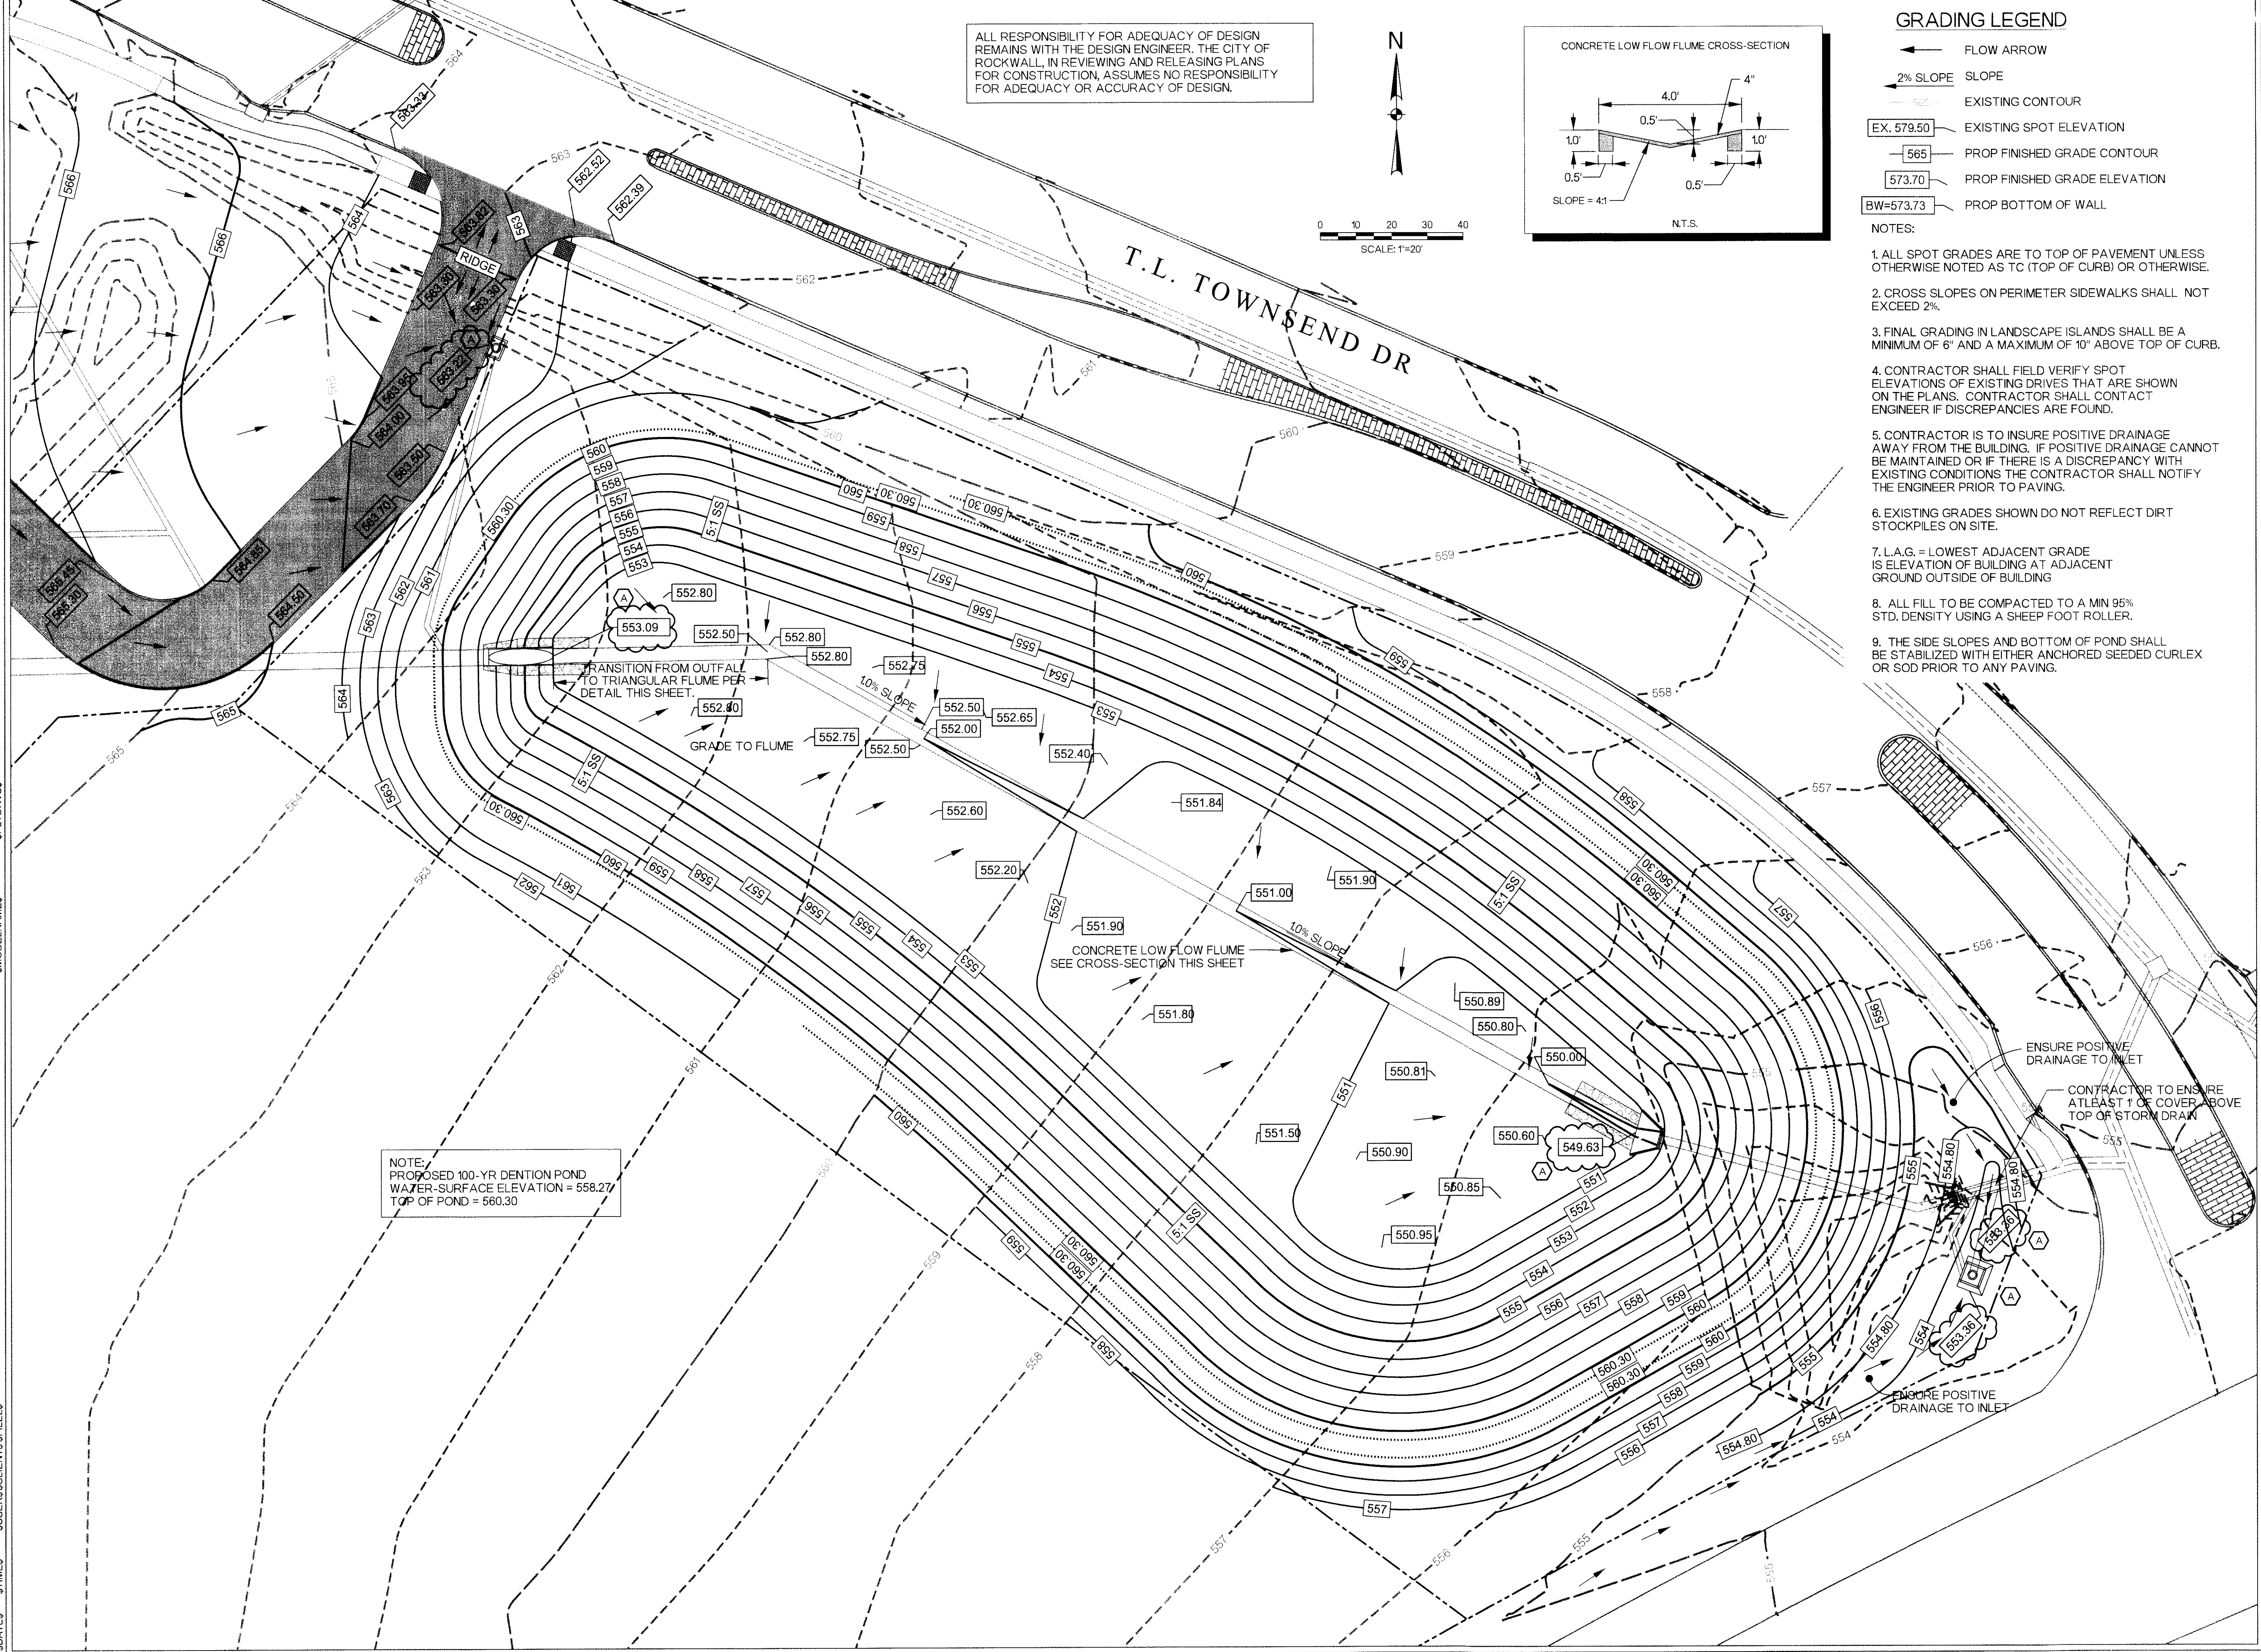

TRANSITION FROM OUTFALL TO TRIANGULAR FLUME PER DETAIL THIS SHEET.

CONCRETE LOW FLOW FLUME SEE CROSS-SECTION THIS SHEET

NOTE:  
PROPOSED 100-YR DETENTION POND  
WATER-SURFACE ELEVATION = 558.27  
TOP OF POND = 560.30

ENSURE POSITIVE DRAINAGE TO INLET  
CONTRACTOR TO ENSURE AT LEAST 1" OF COVER ABOVE TOP OF STORM DRAIN

**ROCKWALL COUNTY**  
**COURTHOUSE**  
 ROCKWALL COUNTY  
 ROCKWALL, TEXAS



Revision No.	Date	Description
1	04/06/2010	CITY COMMENTS
2	04/13/2010	ADD FLOW ARROWS
3	05/05/2010	ADDED NOTE
4	03/28/2011	AS-BUILT ELEVATIONS

**RECORD DRAWING**  
 APRIL 2011  
 These Record Documents have been prepared based upon information provided by Manhattan Construction. The Design Professional has not verified the accuracy and / or completeness of this information and shall not be responsible for any errors or omissions which may be incorporated herein as a result of Design Consultant, Halff Associates, Inc.  
 RECORD DRAWING SUBMITTAL



Project No.: 26244  
 Issued: APRIL 2011  
 Drawn By: BJG  
 Checked By: SBC  
 Scale: AS NOTED  
 Sheet Title

GRADING PLAN  
**C4.06**  
 Sheet Number

SDATES \$TIMES \$SUBSERSCLIENTS \$FILES \$MODELNAMES \$PLTDRVSS