


\$PLTDRVSS

\$MODELNAME\$

\$USERS\$CLIENTS\$FILES\$

\$DATE\$ \$TIME\$

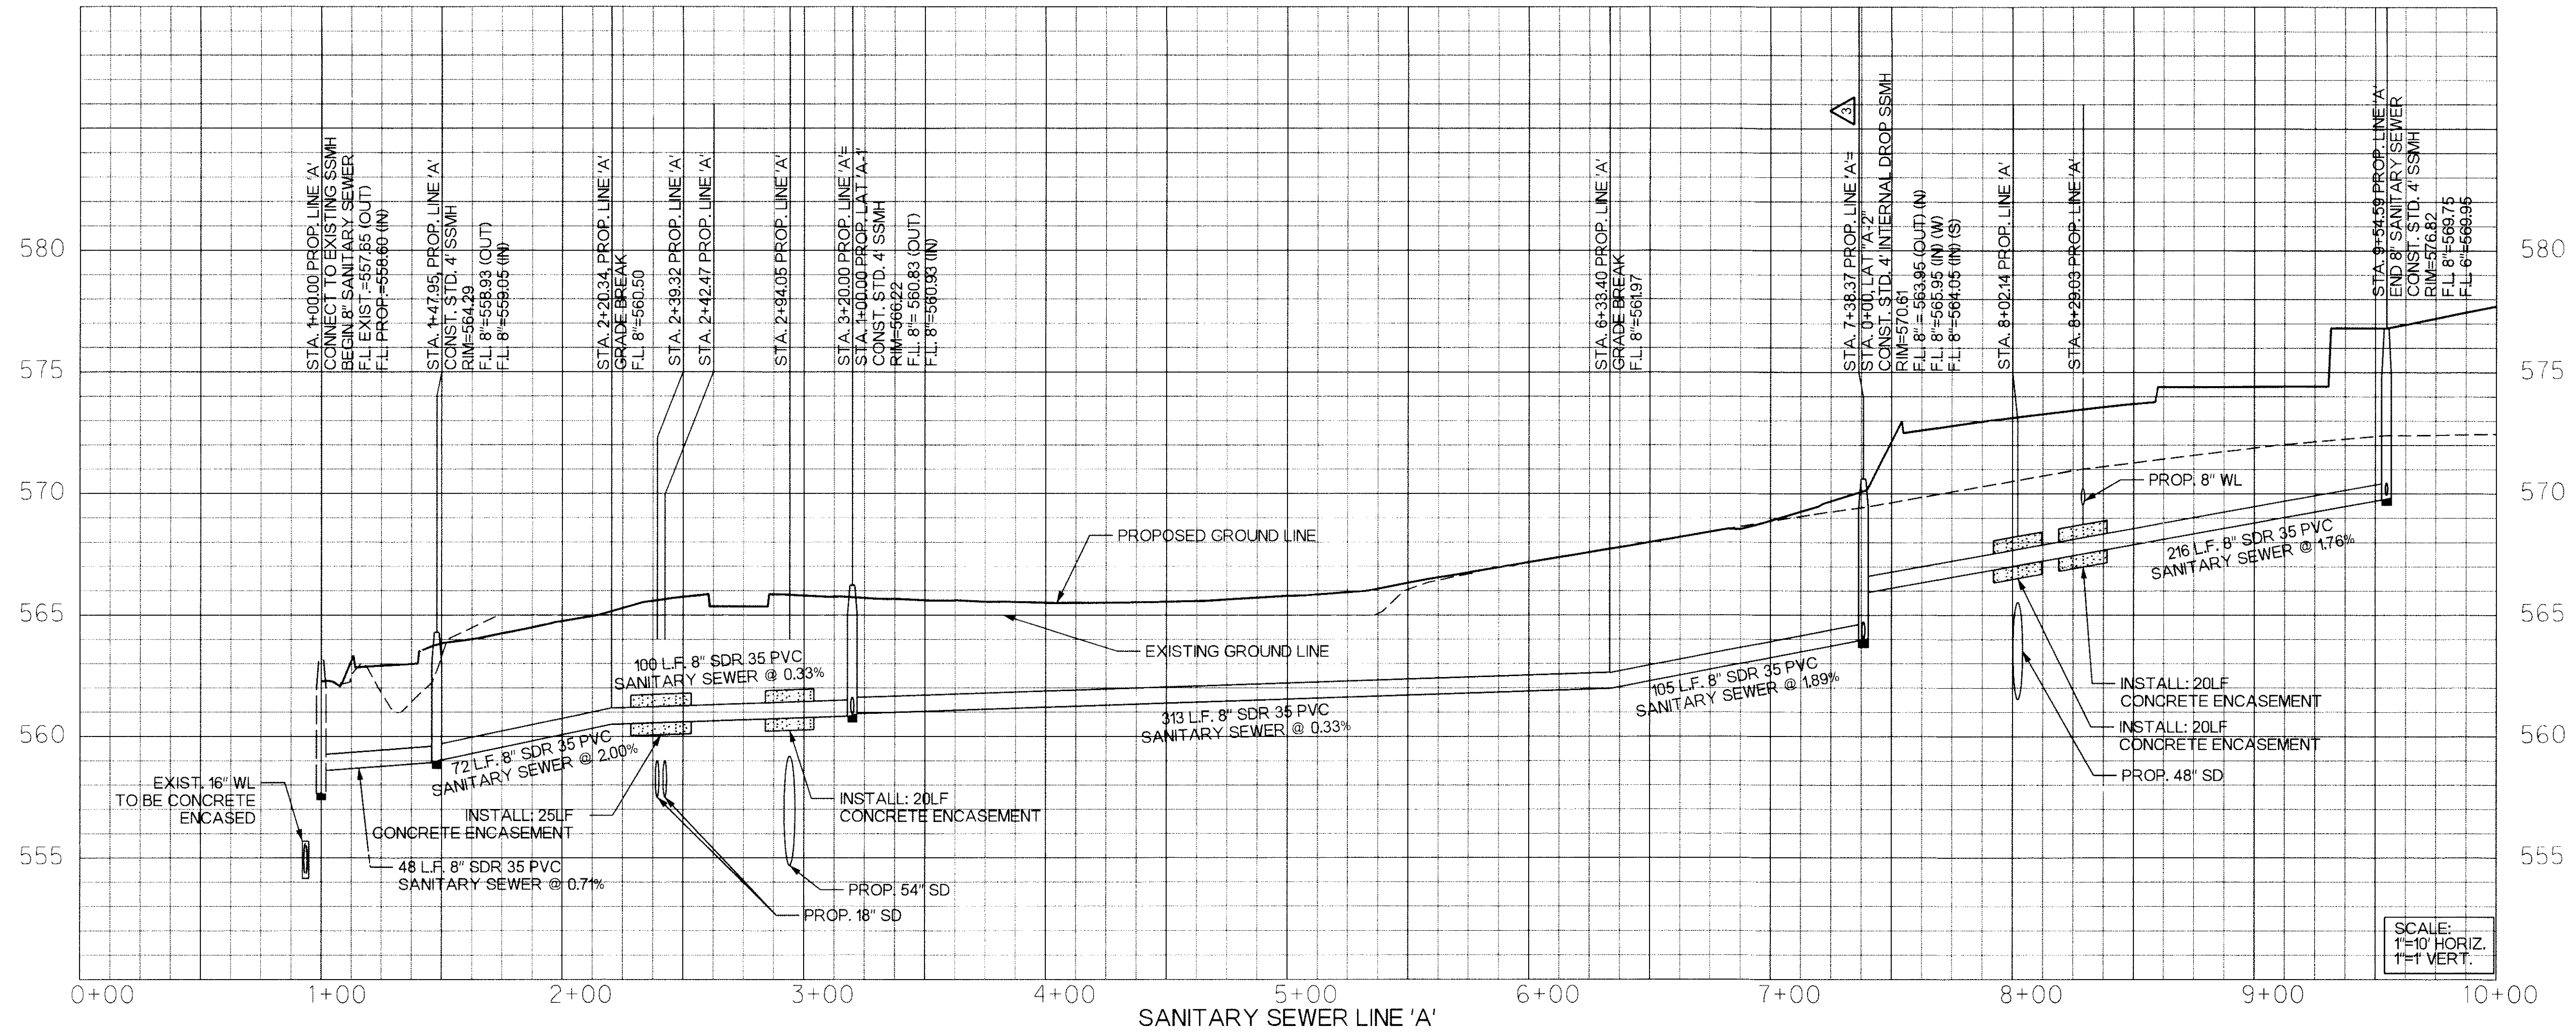


SCALE:
1"=10' HORIZ.
1"=1' VERT.

**ROCKWALL COUNTY
COURTHOUSE**
ROCKWALL COUNTY
ROCKWALL, TEXAS



Revision No.	Date	Description
1	04/05/2010	SITE PLAN REVISIONS
2	05/05/2010	LABEL INTERNAL DROP SSMH

RECORD DRAWING
APRIL, 2011
These Record Documents have been prepared based upon information provided by Manhattan Construction. The Design Professional has not verified the accuracy and / or completeness of this information and shall not be responsible for any errors or omissions which may be incorporated herein as a result of Design Consultant: Halff Associates, Inc.
RECORD DRAWING SUBMITTAL

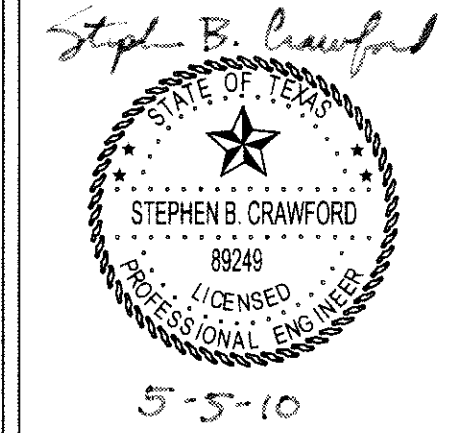

Project No.:	26244
Issued:	APRIL 2011
Drawn By:	BJG
Checked By:	SBC
Scale:	AS NOTED

Sheet Title
SANITARY SEWER PROFILES

C6.02
Sheet Number