



ALL RESPONSIBILITY FOR ADEQUACY OF DESIGN REMAINS WITH THE DESIGN ENGINEER. THE CITY OF ROCKWALL, IN REVIEWING AND RELEASING PLANS FOR CONSTRUCTION, ASSUMES NO RESPONSIBILITY FOR ADEQUACY OR ACCURACY OF DESIGN.



Existing utility locations shown are generally schematic in nature and may not accurately reflect the size and location of each particular utility. Some utility lines and surface locations may not be shown. Contractor shall assume responsibility for actual field location and protection of existing utilities whether shown or not. Contractor shall also assume responsibility for repairs to existing utilities, whether shown or not, damaged by contractor's activities. Differences in horizontal or vertical location of existing utilities shall not be a basis for additional compensation.

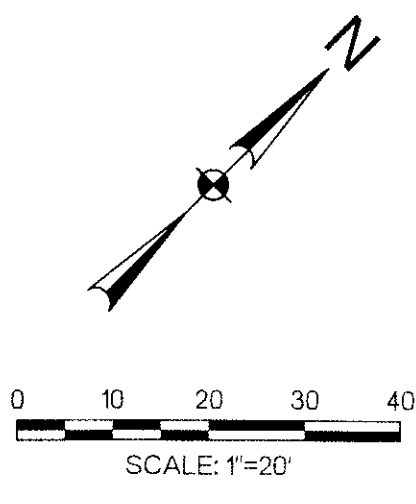

- NOTE:
- CROSS SLOPES ON PERIMETER SIDEWALKS SHALL NOT EXCEED 2%.
 - CONTRACTOR TO MATCH EXISTING GRADE
 - REFER TO LANDSCAPE ARCHITECTURAL PLANS FOR ADDITIONAL HARDSCAPE CONSIDERATIONS AT MAIN DRIVE ENTRANCE AT YELLOW JACKET. IF ANY DISCREPANCIES EXIST, PLEASE NOTIFY ENGINEER.

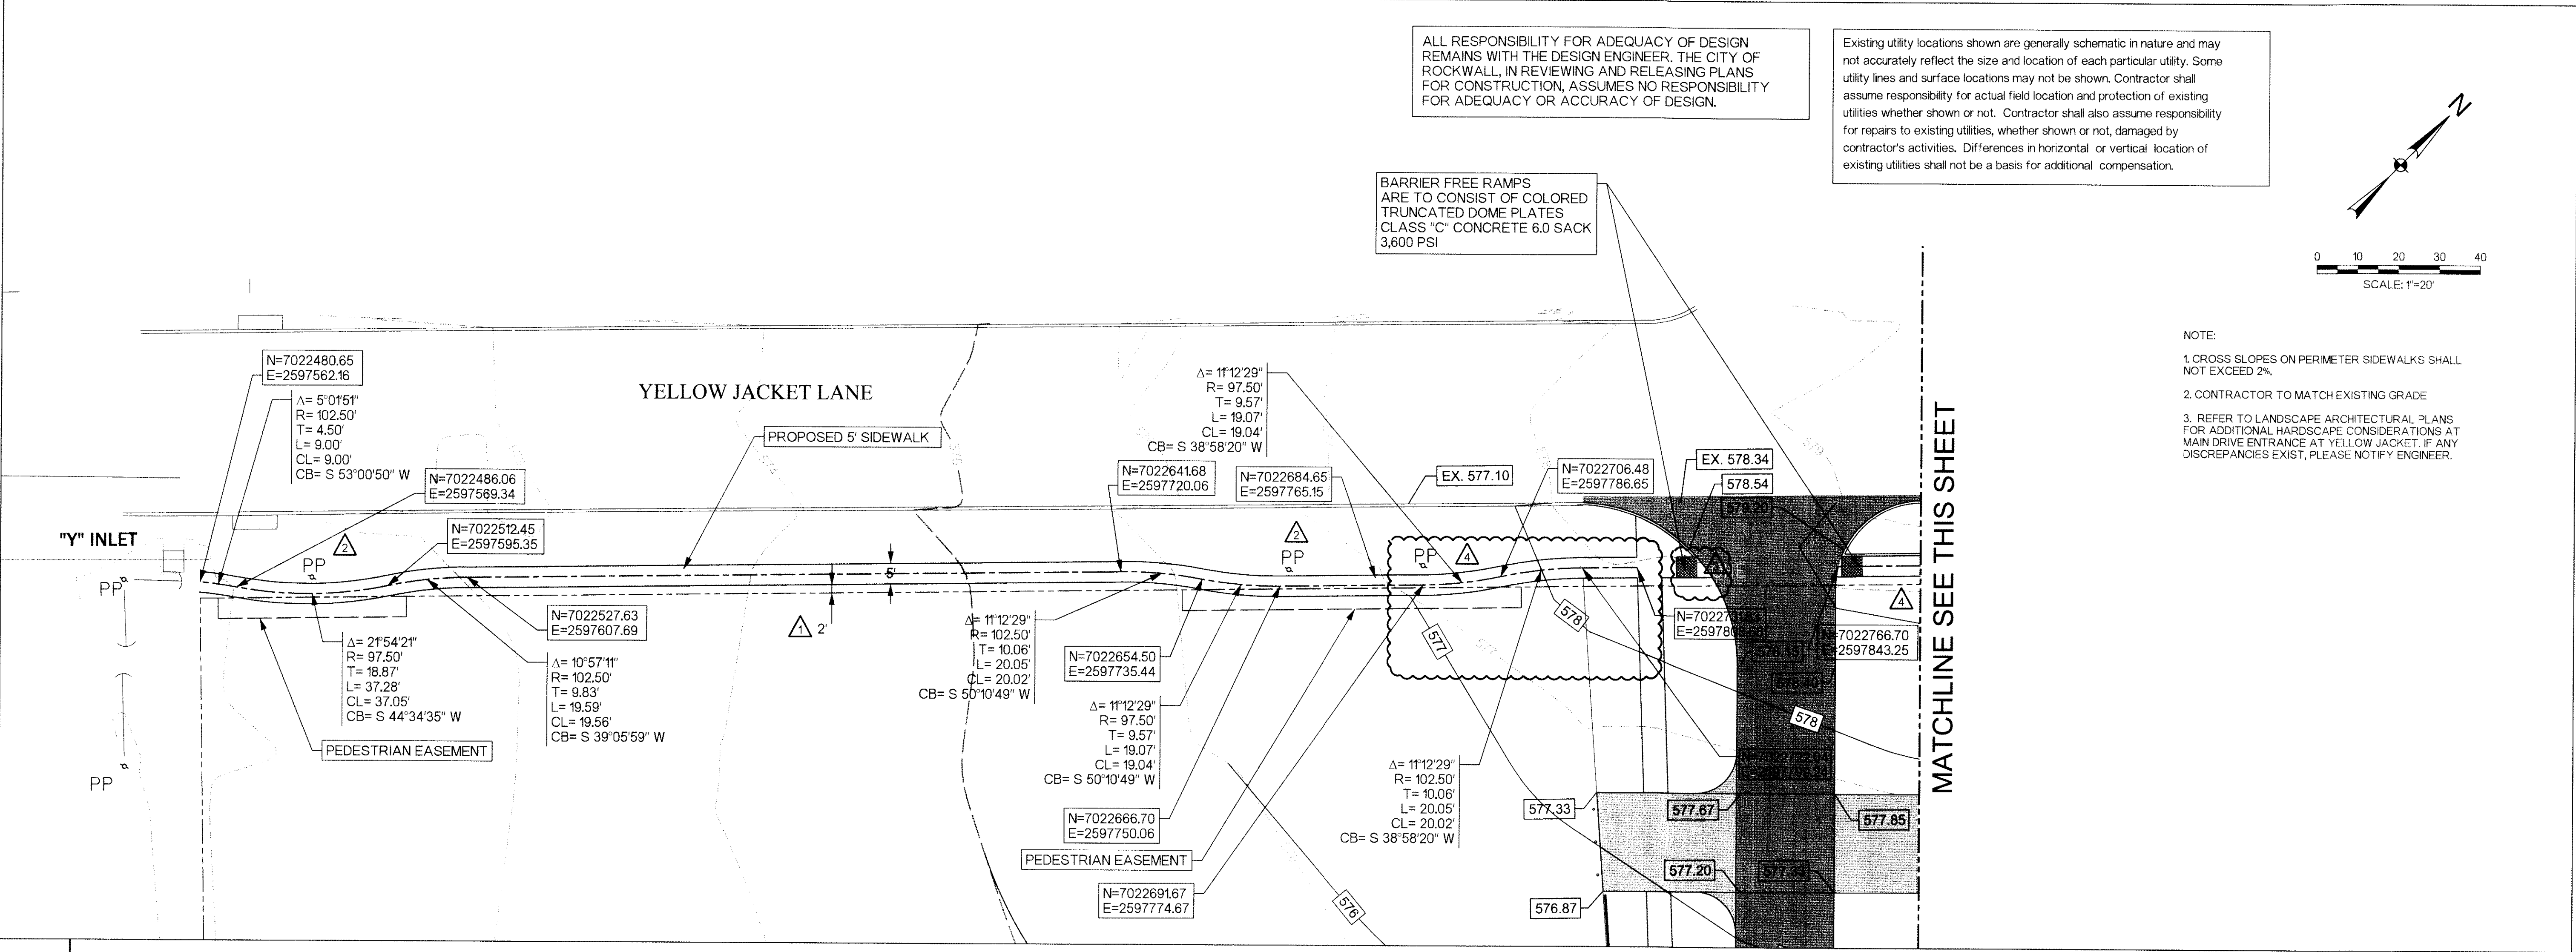

MATCHLINE SEE THIS SHEET

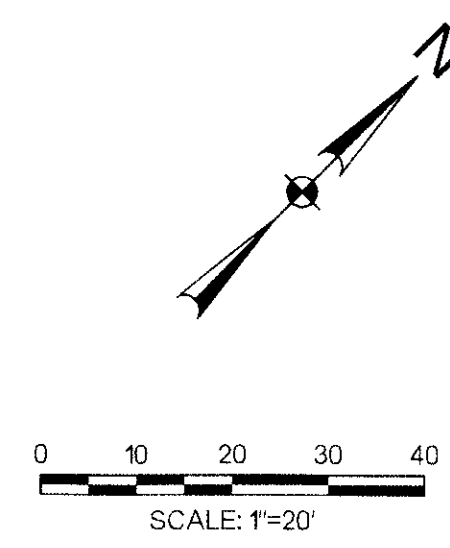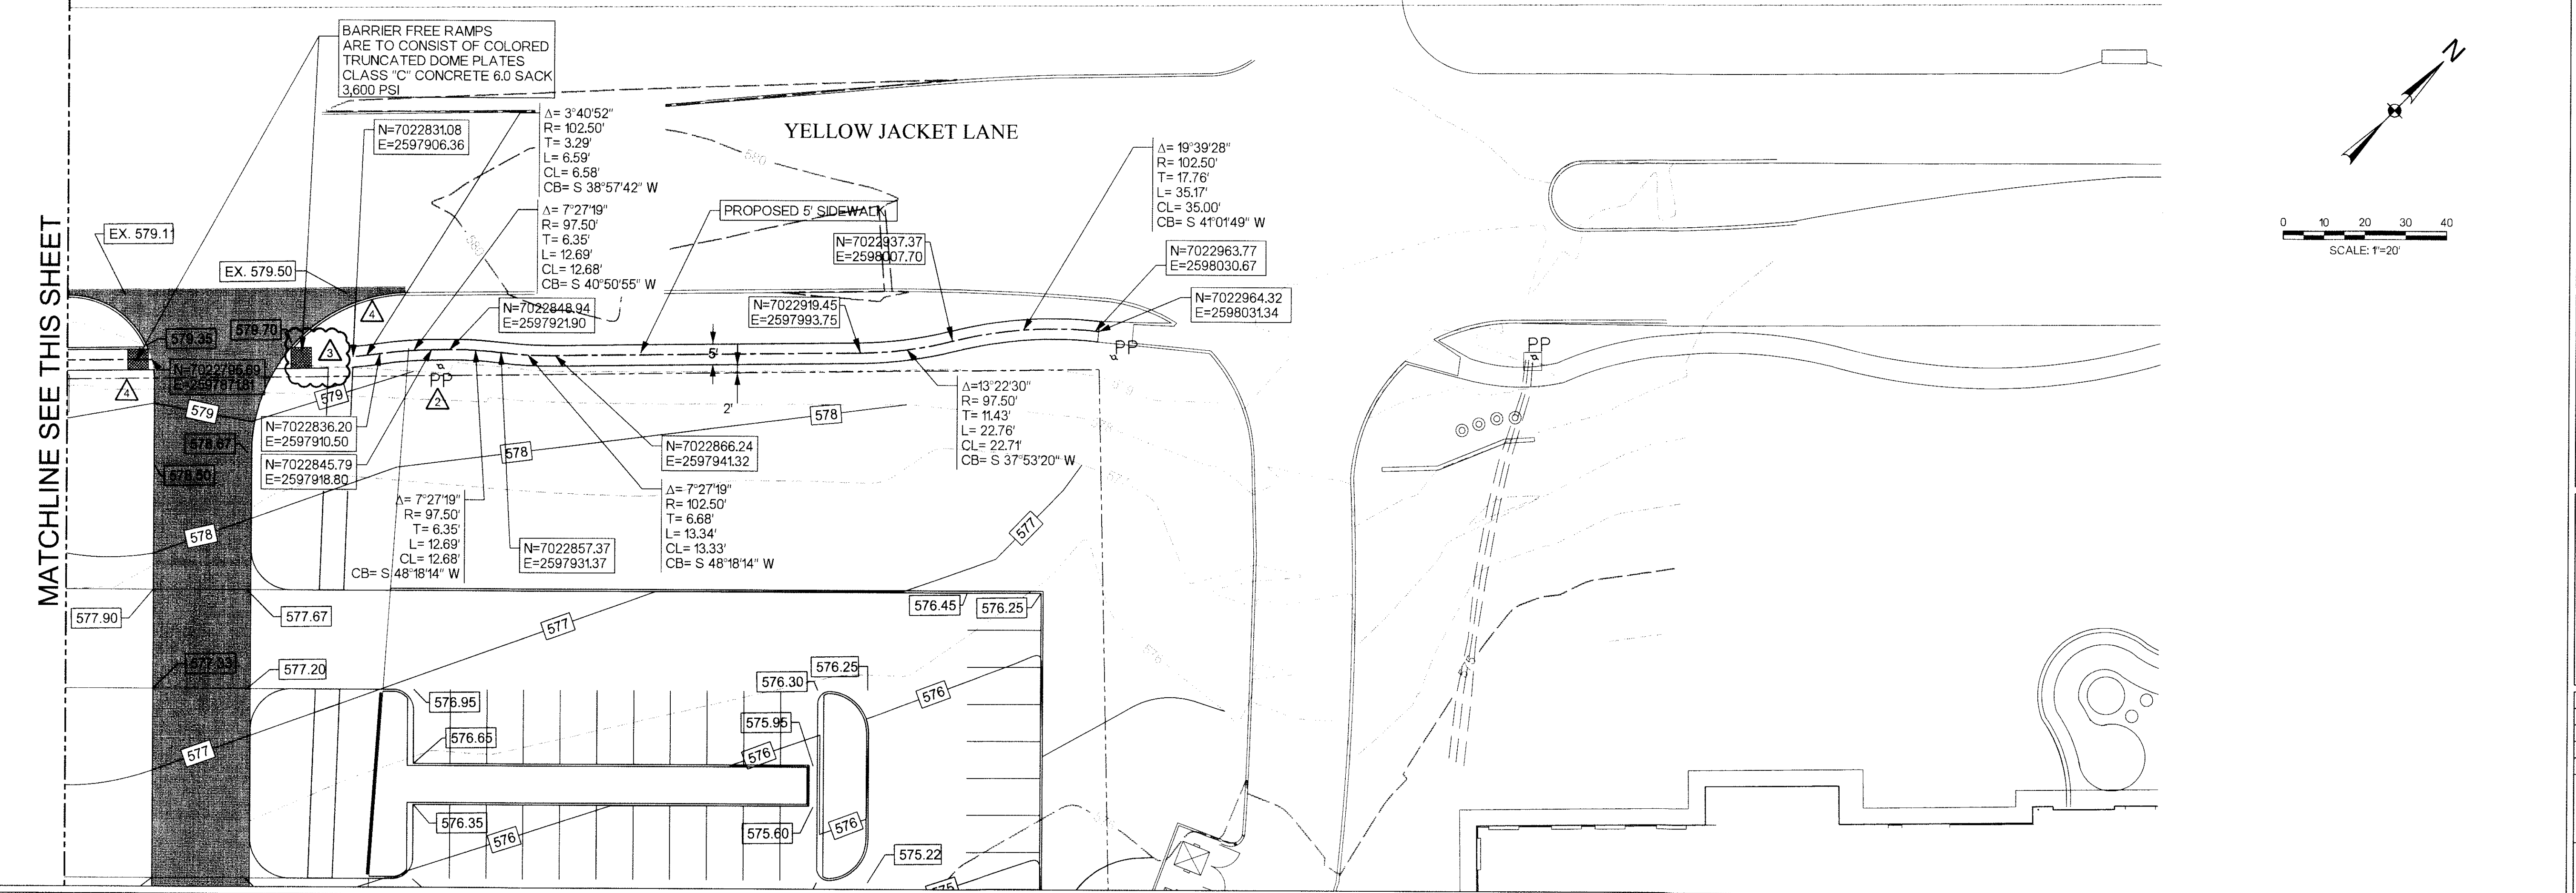

ROCKWALL COUNTY COURTHOUSE
ROCKWALL COUNTY
ROCKWALL, TEXAS

HALFF
2080 N. STATE HIGHWAY 380, SUITE 350
GRAND PRAIRIE, TEXAS
TEL: (214) 201-1270
FAX: (214) 201-1271
TDC# 114668-312

Revision No.	Date	Description
04/05/2010	04/05/2010	CITY COMMENTS
04/13/2010	04/13/2010	REALIGN SDWLK FOR EX. PP
05/05/2010	05/05/2010	RELOCATED ADA RAMP
07/19/2010	07/19/2010	REVISED SDWLK ALIGNMENT

RECORD DRAWING
APRIL 2011
These Record Documents have been prepared based upon information provided by Manhattan Construction. The Design Professional has not verified the accuracy and / or completeness of this information and shall not be responsible for any errors or omissions which may be incorporated herein as a result of Design Consultant: Halff Associates, Inc.
RECORD DRAWING SUBMITTAL

Stephen B. Crawford
STEPHEN B. CRAWFORD
88249
LICENSED PROFESSIONAL ENGINEER
7/19/10

Project No.: 26244
Issued: APRIL 2011
Drawn By: BJG
Checked By: SBC
Scale: AS NOTED
Sheet Title: SIDEWALK PLAN

C3.02
Sheet Number

SPL.DRVSS

SMODELNAME

SUSERS\$CLIENTS\$FILELS

SDATES \$TIMES