


AS BUILT

SEE SHEET C1.3 FOR  
REVISED T.C. ELEVATIONS

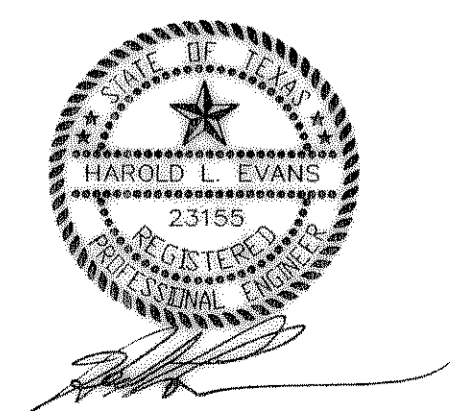

REV.	DATE	SCALE	DESIGN	DRAWN
	6/28/99	1" = 20'	H.L.E.	

**HAROLD L. EVANS**  
CONSULTING ENGINEER  
P.O. BOX 28365  
2331 GUS THOMASSON ROAD, SUITE 102  
DALLAS, TEXAS 75228, (214) 328-8133

**PROPOSED WALL**  
**ROCKWALL LAW ENFORCEMENT CENTER**  
**CITY OF ROCKWALL**

SHEET NO.  
JOB NO.  
9906