


AS BUILT

SEE SHEET C1.3 FOR
REVISED T.C. ELEVATIONS

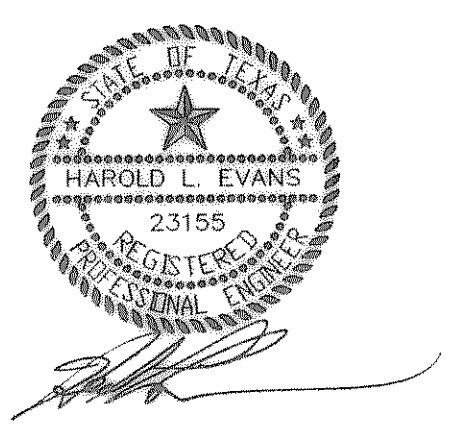

REV.		DATE		SCALE		DESIGN		DRAWN		SHEET NO.	
		7/9/99		1" = 20'		H.L.E.				9906	
REVISION DESCRIPTION						HAROLD L. EVANS CONSULTING ENGINEER P.O. BOX 28365 2331 GUS THOMASSON ROAD, SUITE 102 DALLAS, TEXAS 75228 (214) 328-8133					
						PROPOSED WALL ROCKWALL LAW ENFORCEMENT CENTER CITY OF ROCKWALL					