

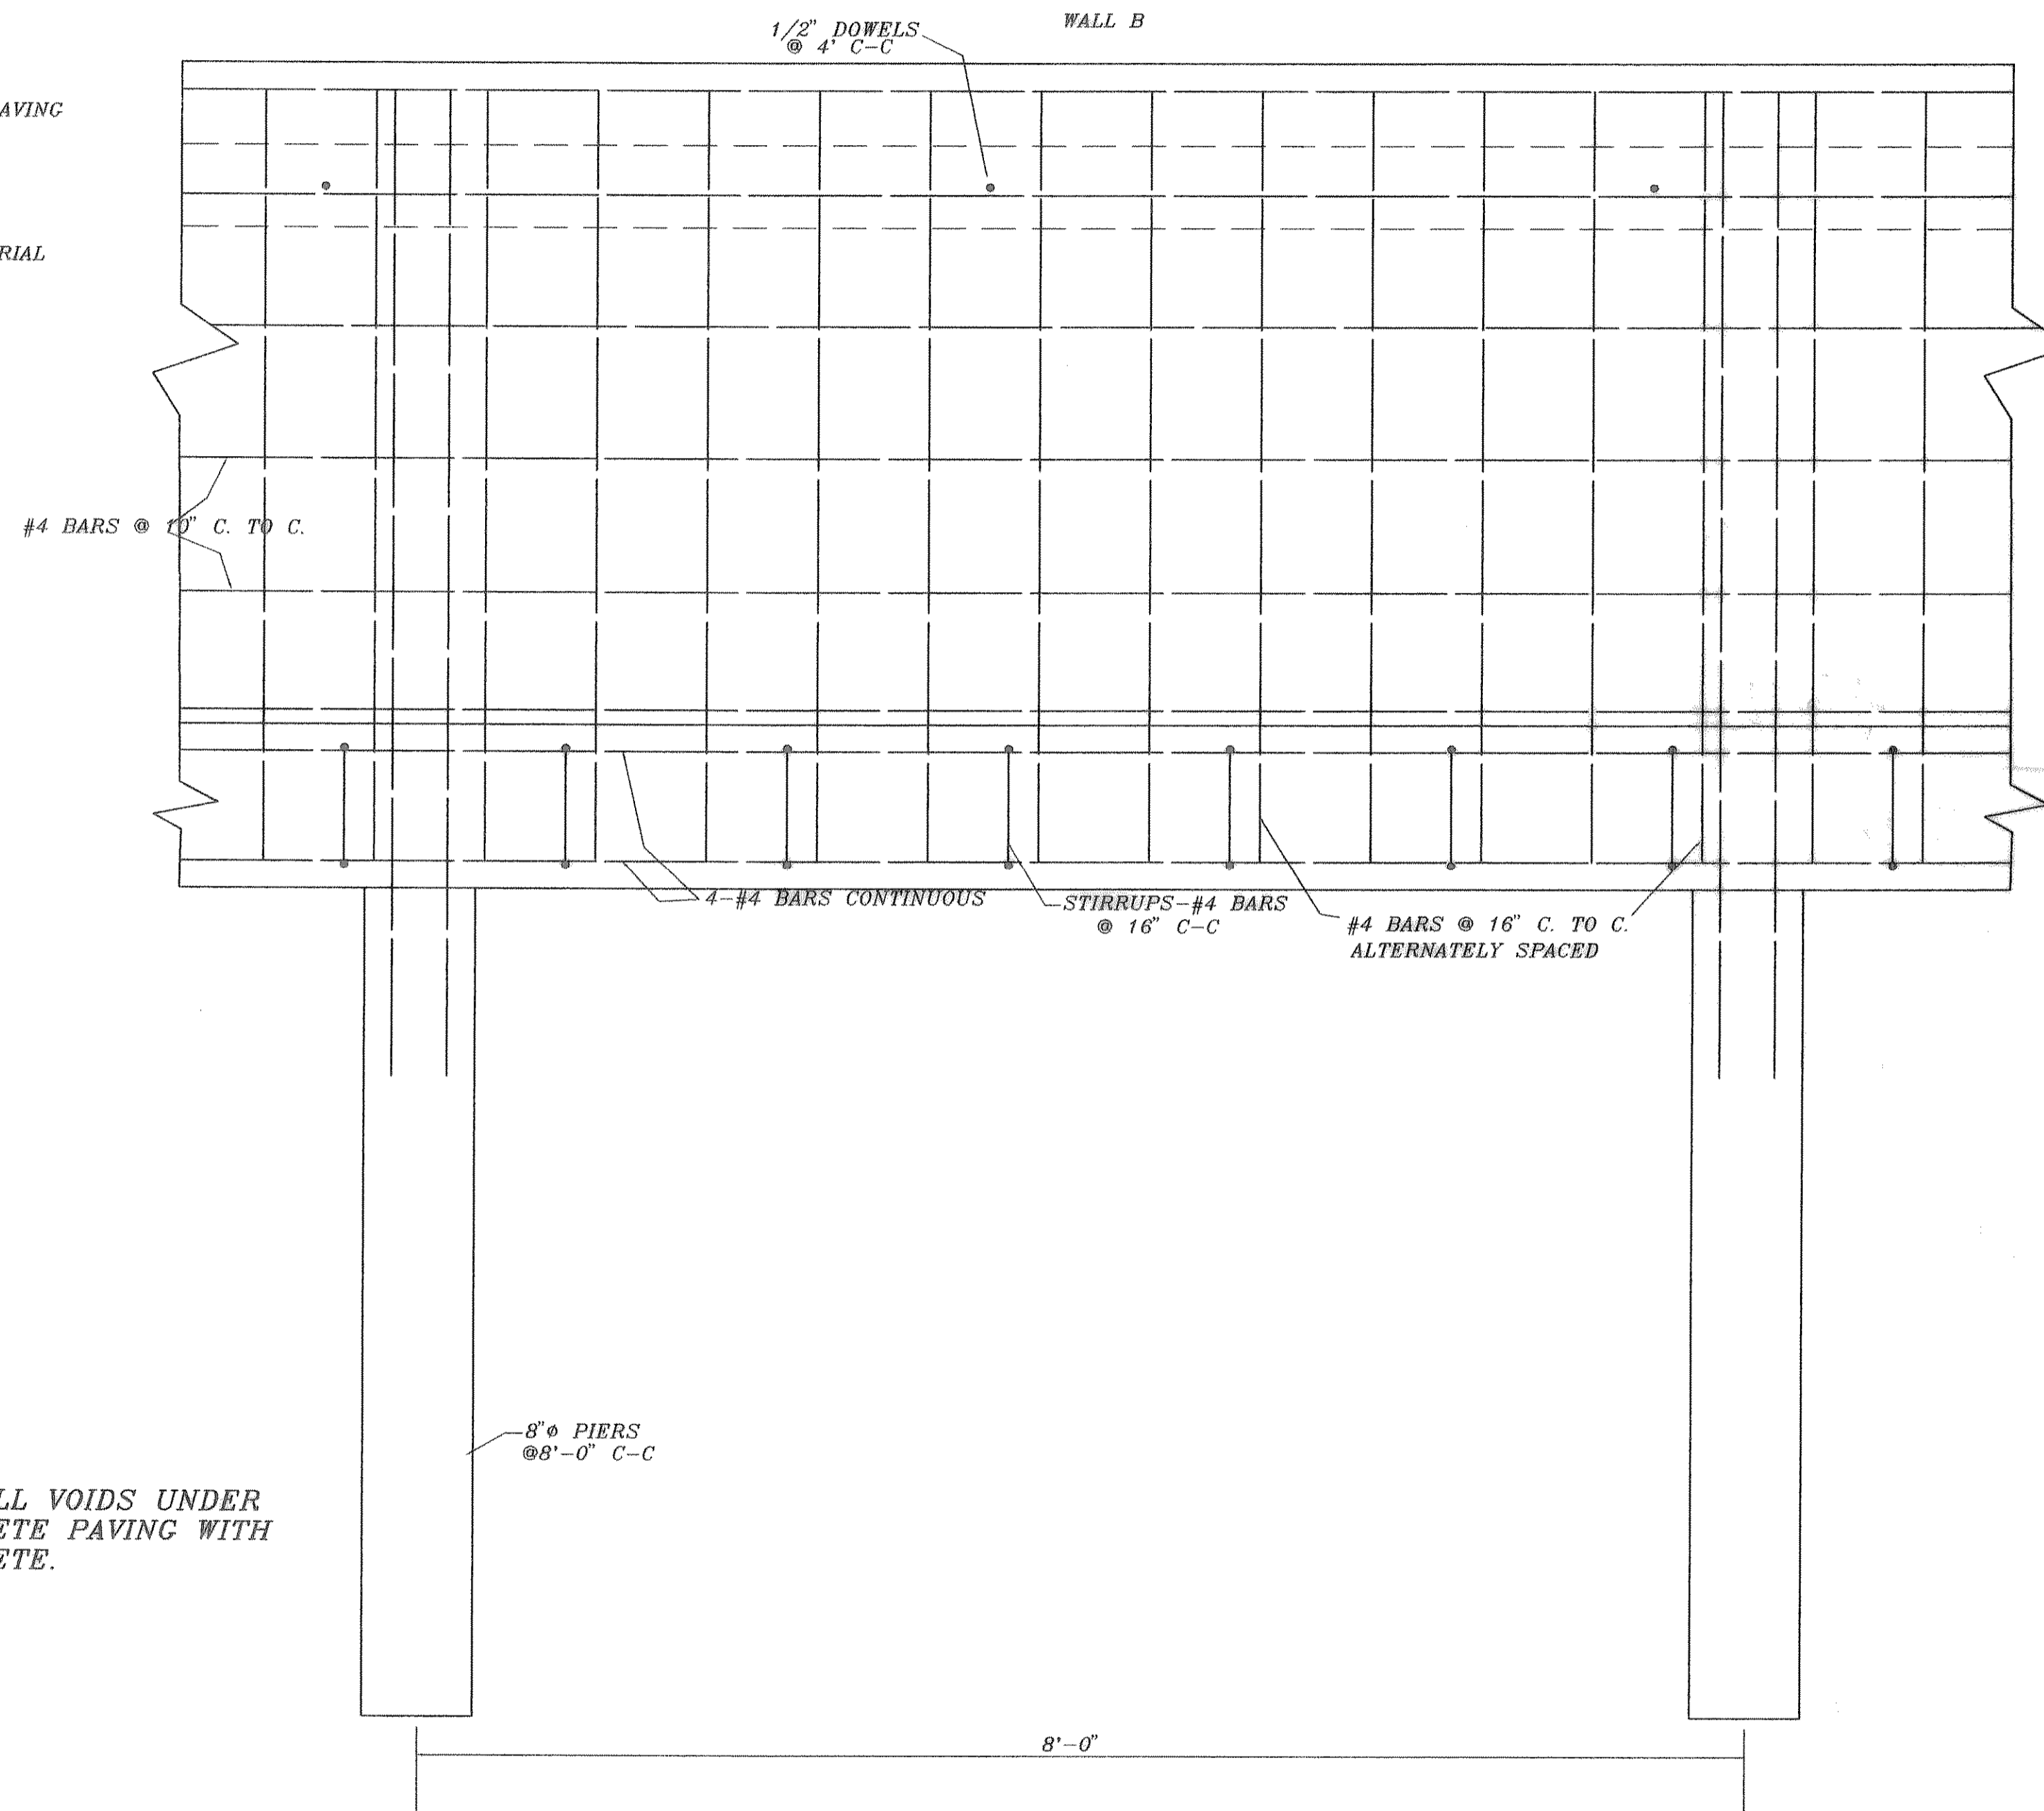


LONGITUDINAL WALL DETAIL

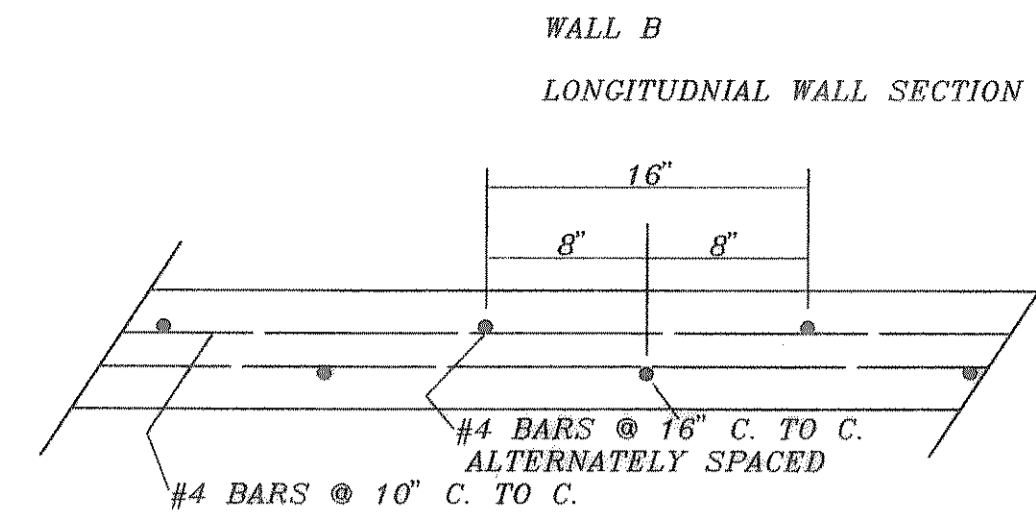

NOTE:
FILL ALL VOIDS UNDER
CONCRETE PAVING WITH
CONCRETE.

AS BUILT

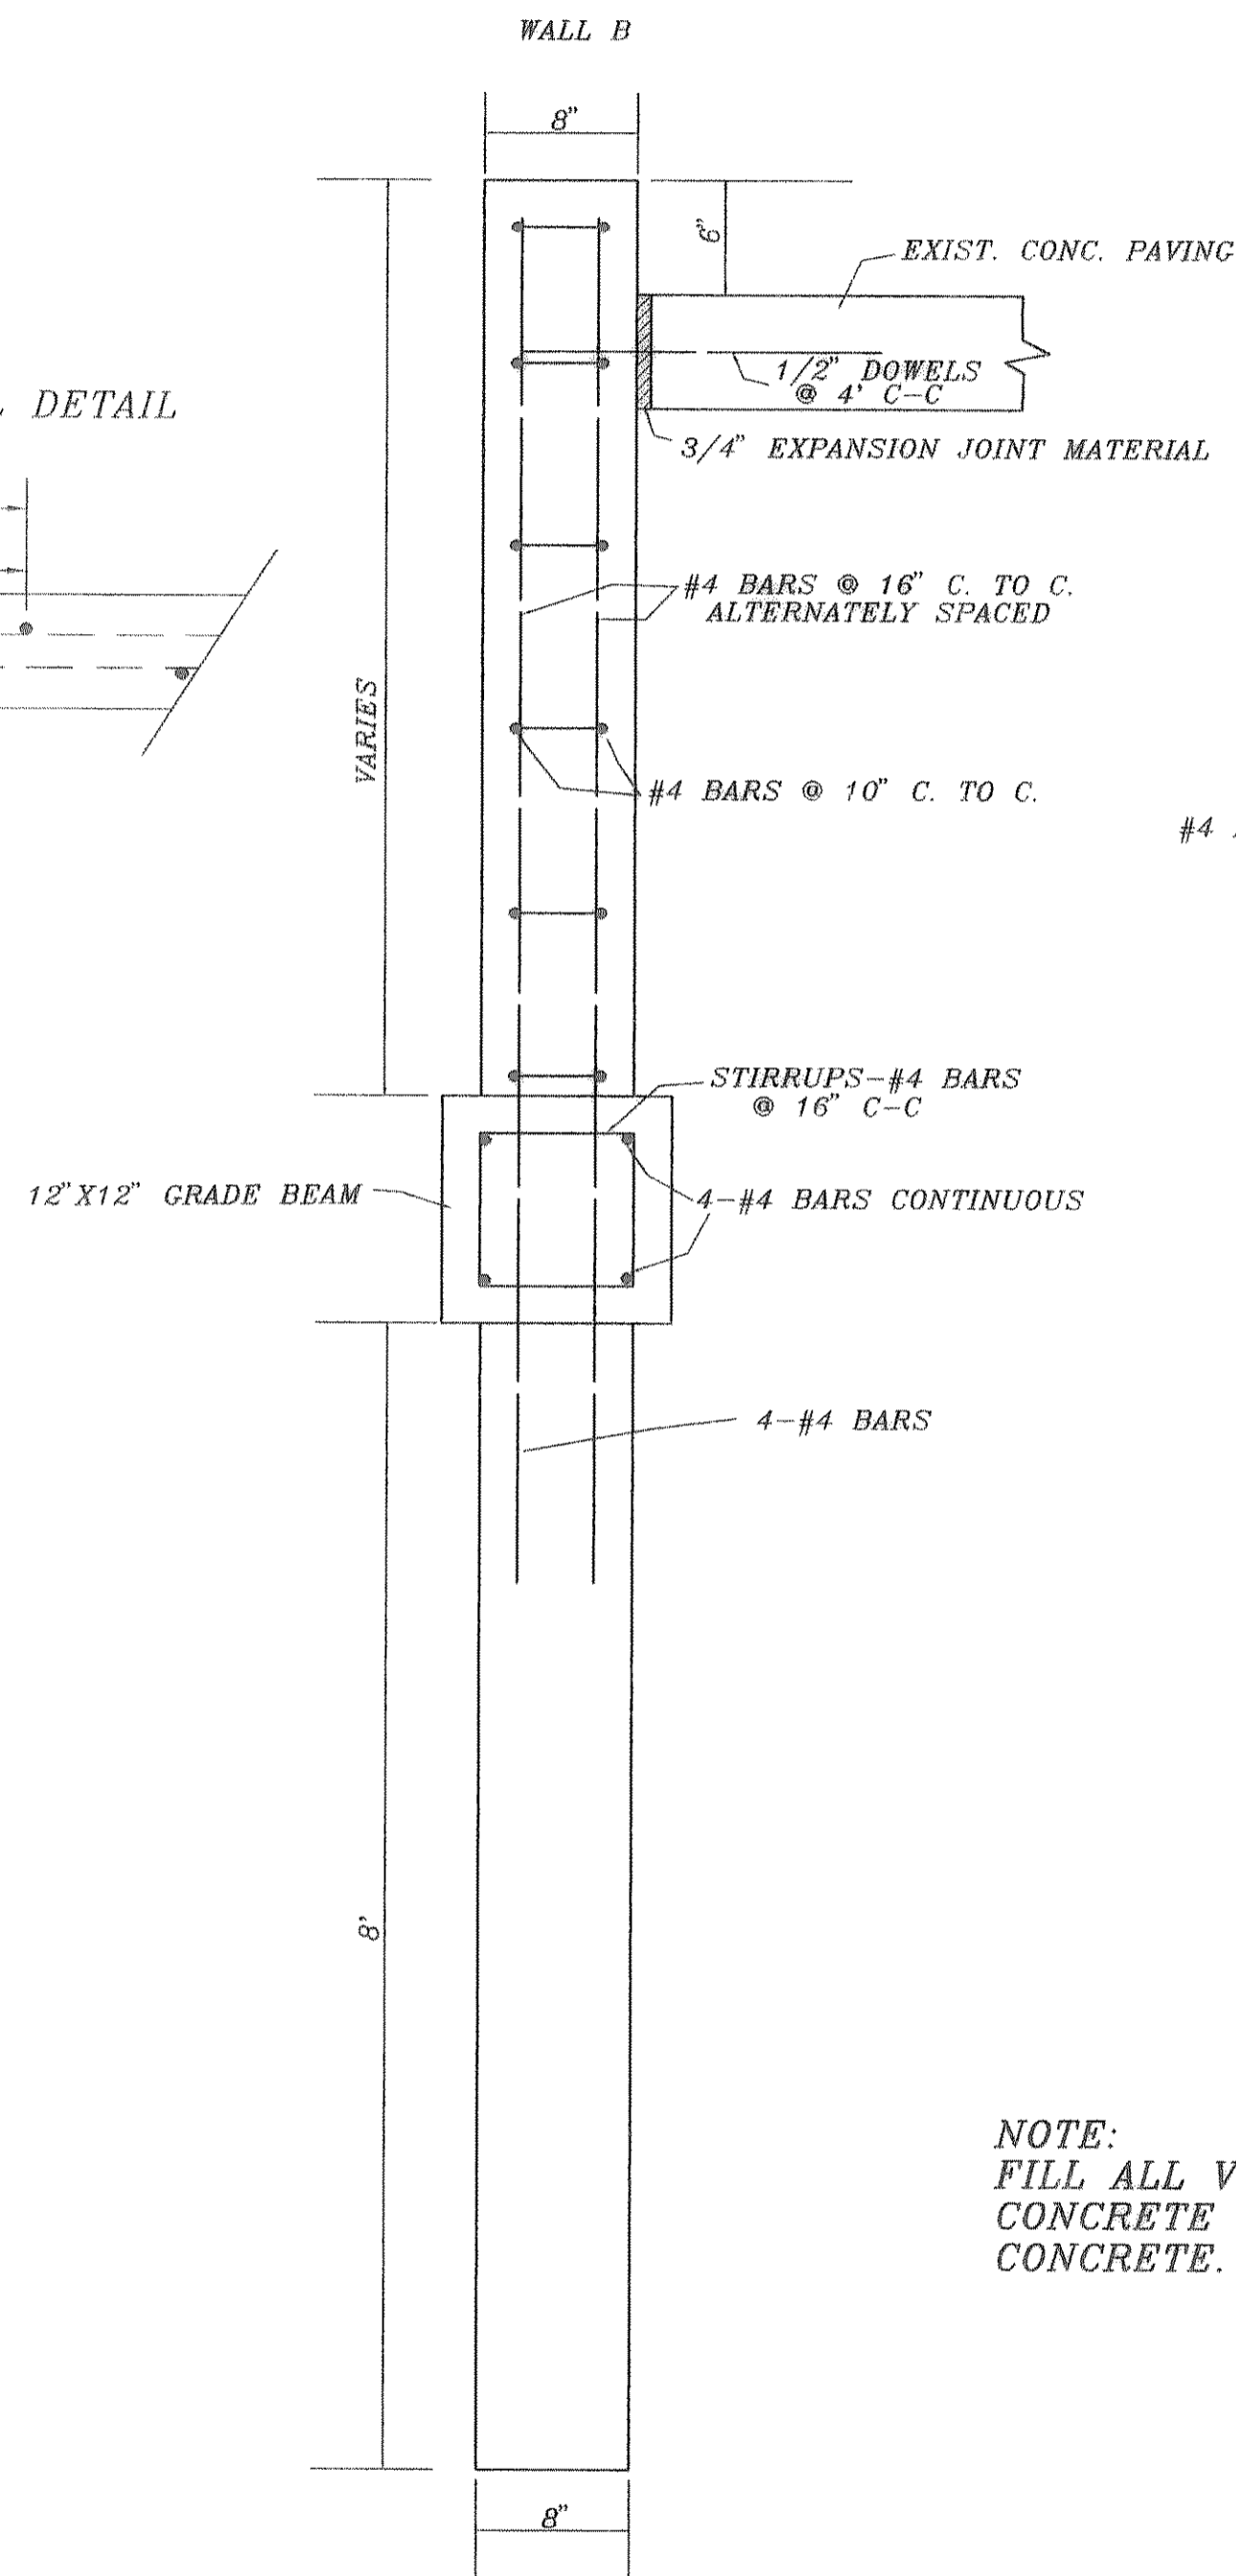

HAROLD L. EVANS CONSULTING ENGINEER P.O. BOX 29355 2331 GUS THOMASSON ROAD, SUITE 102 DALLAS, TEXAS 75228, (214) 328-8133		WALL DETAILS ROCKWALL LAW ENFORCEMENT CENTER CITY OF ROCKWALL		SHEET NO. JOB NO. 9906
REV. 7/9/99	DATE 6/28/99	SCALE 1" = 20'	DESIGN H.L.E.	DRAWN
REVISION DESCRIPTION		2906STM		