


Z:\Projects\6-Commercial\Rockwall Library\Construction\rockwall-city.dwg Tue Jul 01 15:09:23 2008

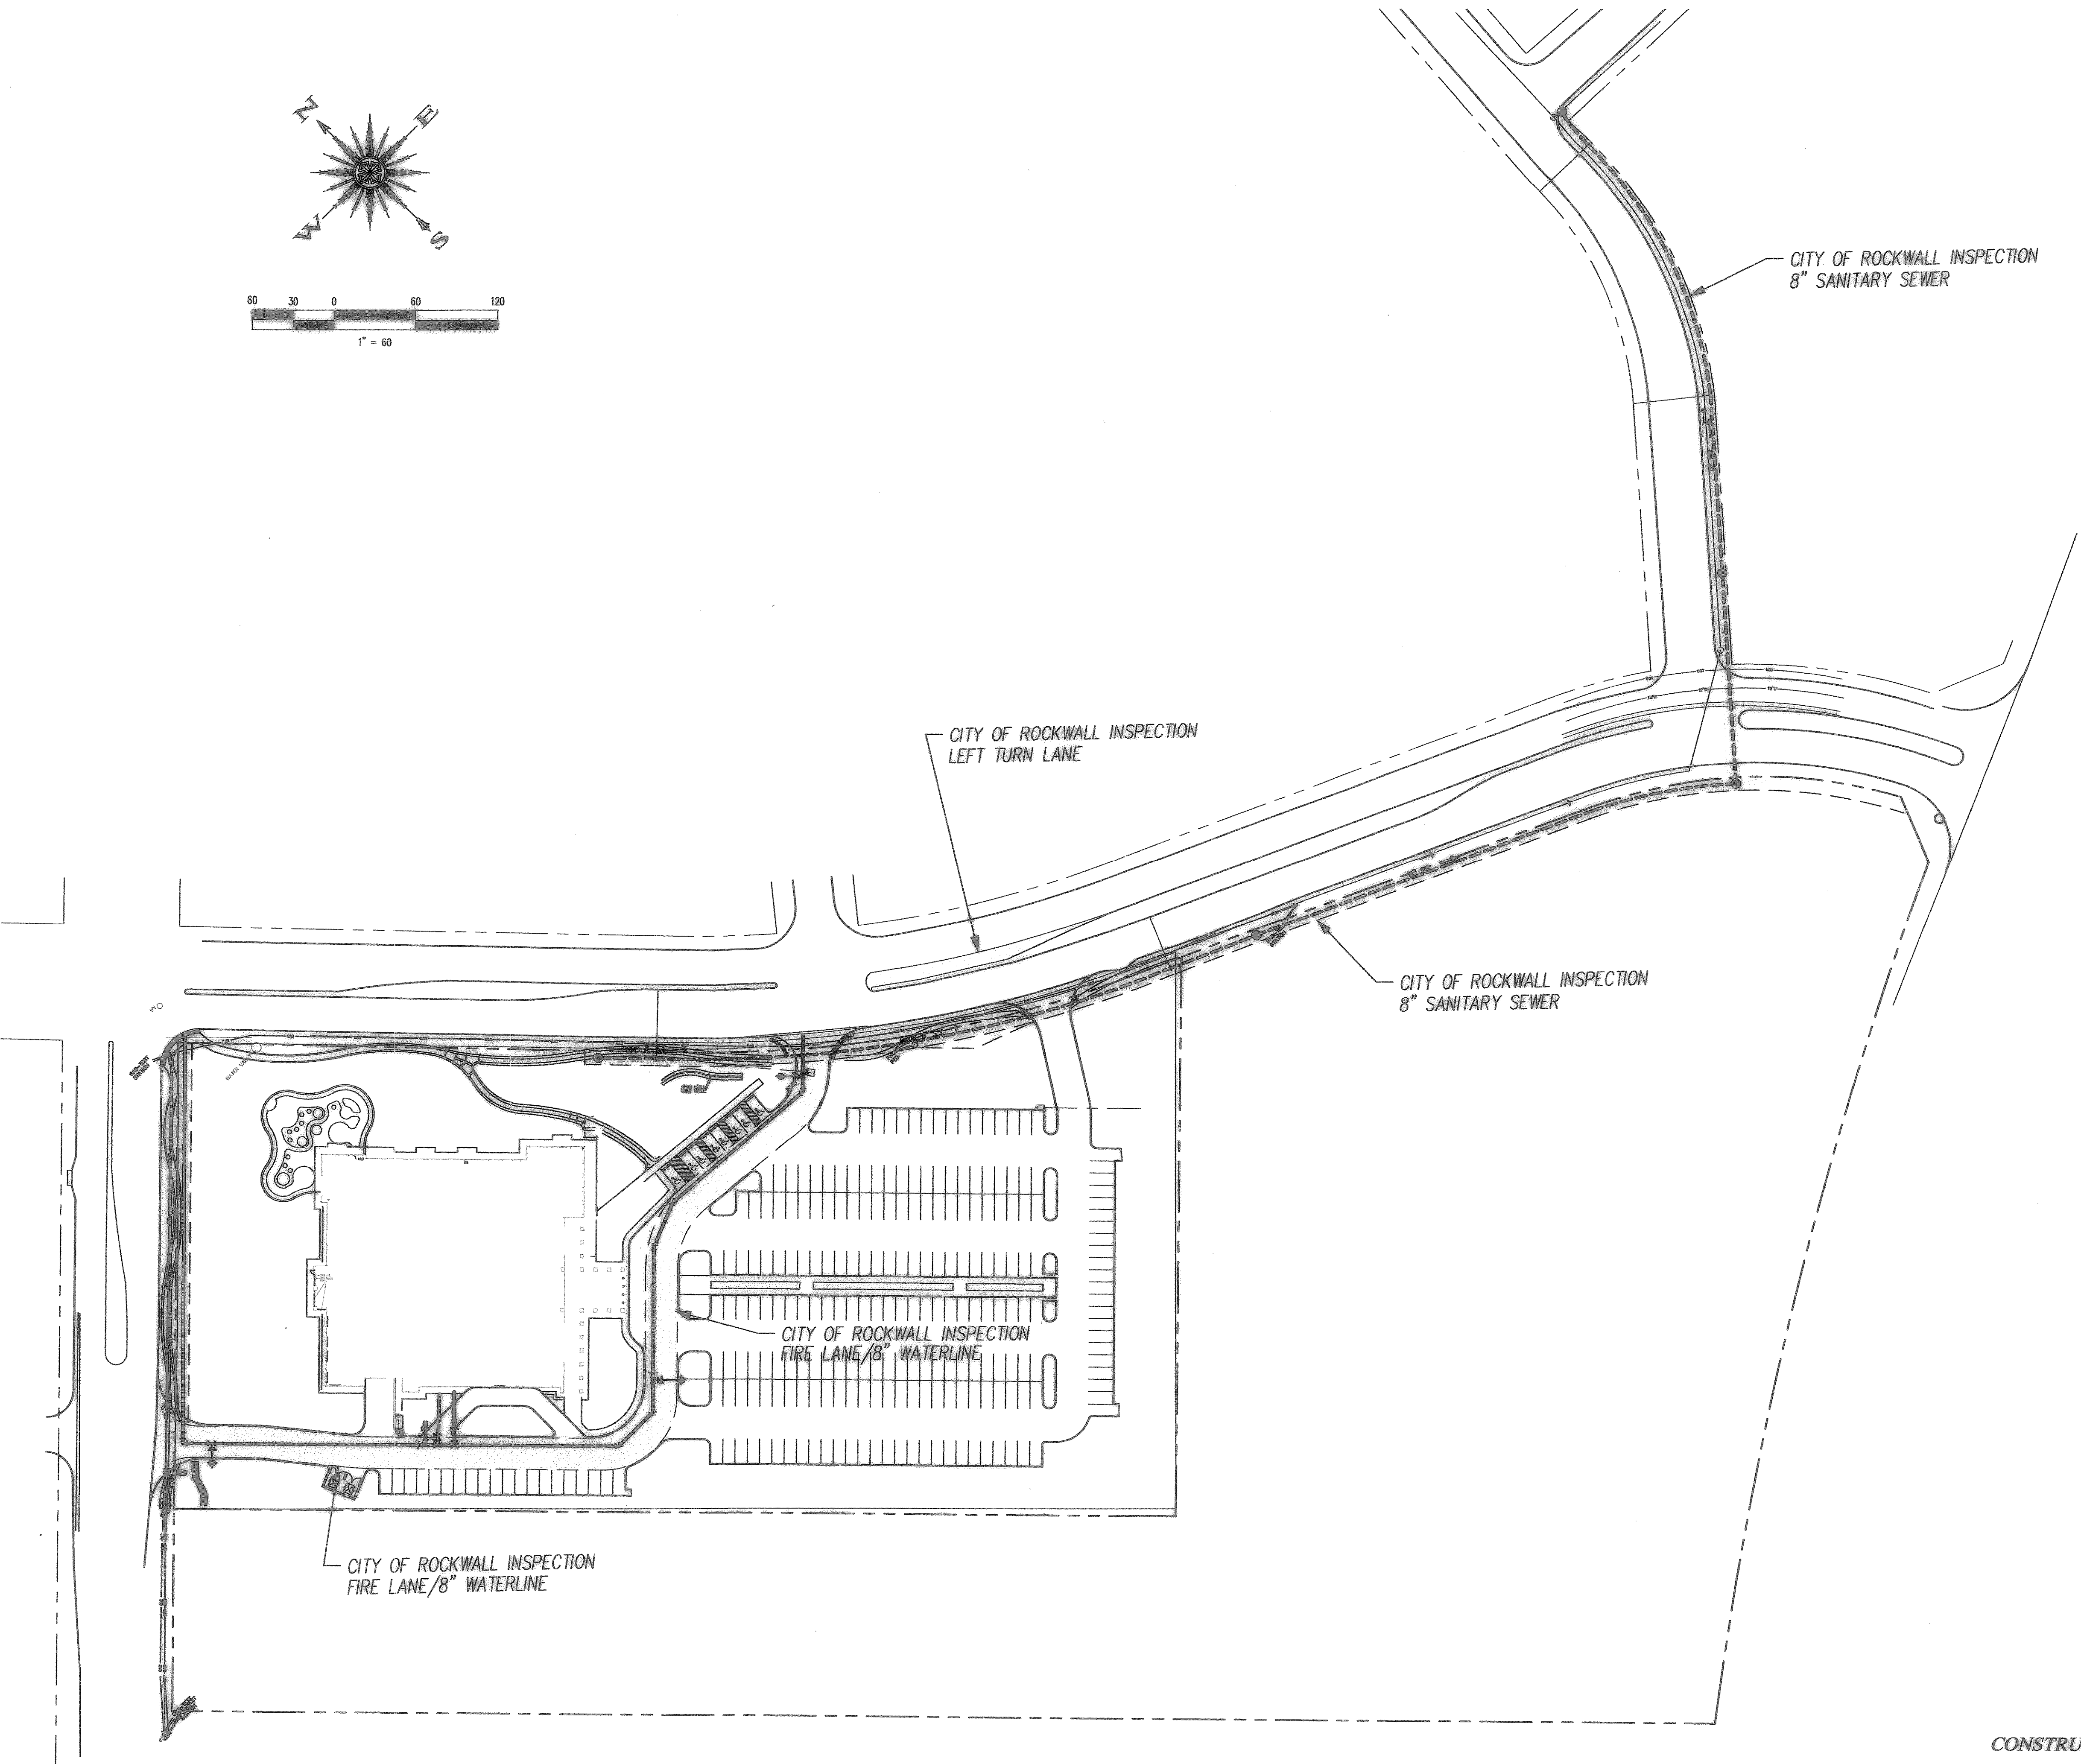


Revision	Date	Description

Rockwall Library

F.C. CUNY CORPORATION

#2 Horizon Court
Heath, Texas 75032
Phone: 469-402-7700
Fax: 469-402-0700

THE SEAL APPEARING ON THIS DOCUMENT WAS AUTHORIZED BY CHRISTOPHER R. CUNY (P.E. 65642)

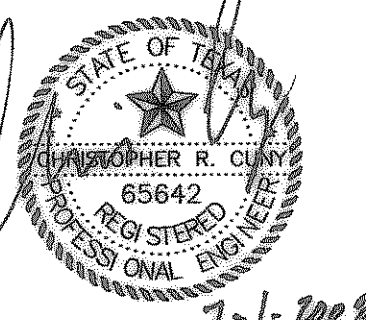

Drawn By: MSC	Checked By: DJW
Date: 6-22-07	Project No.: 05-017
Sheet Title: City of Rockwall Inspection Reference	
Scale: 1"=60'	Sheet No.: 11 of 11