
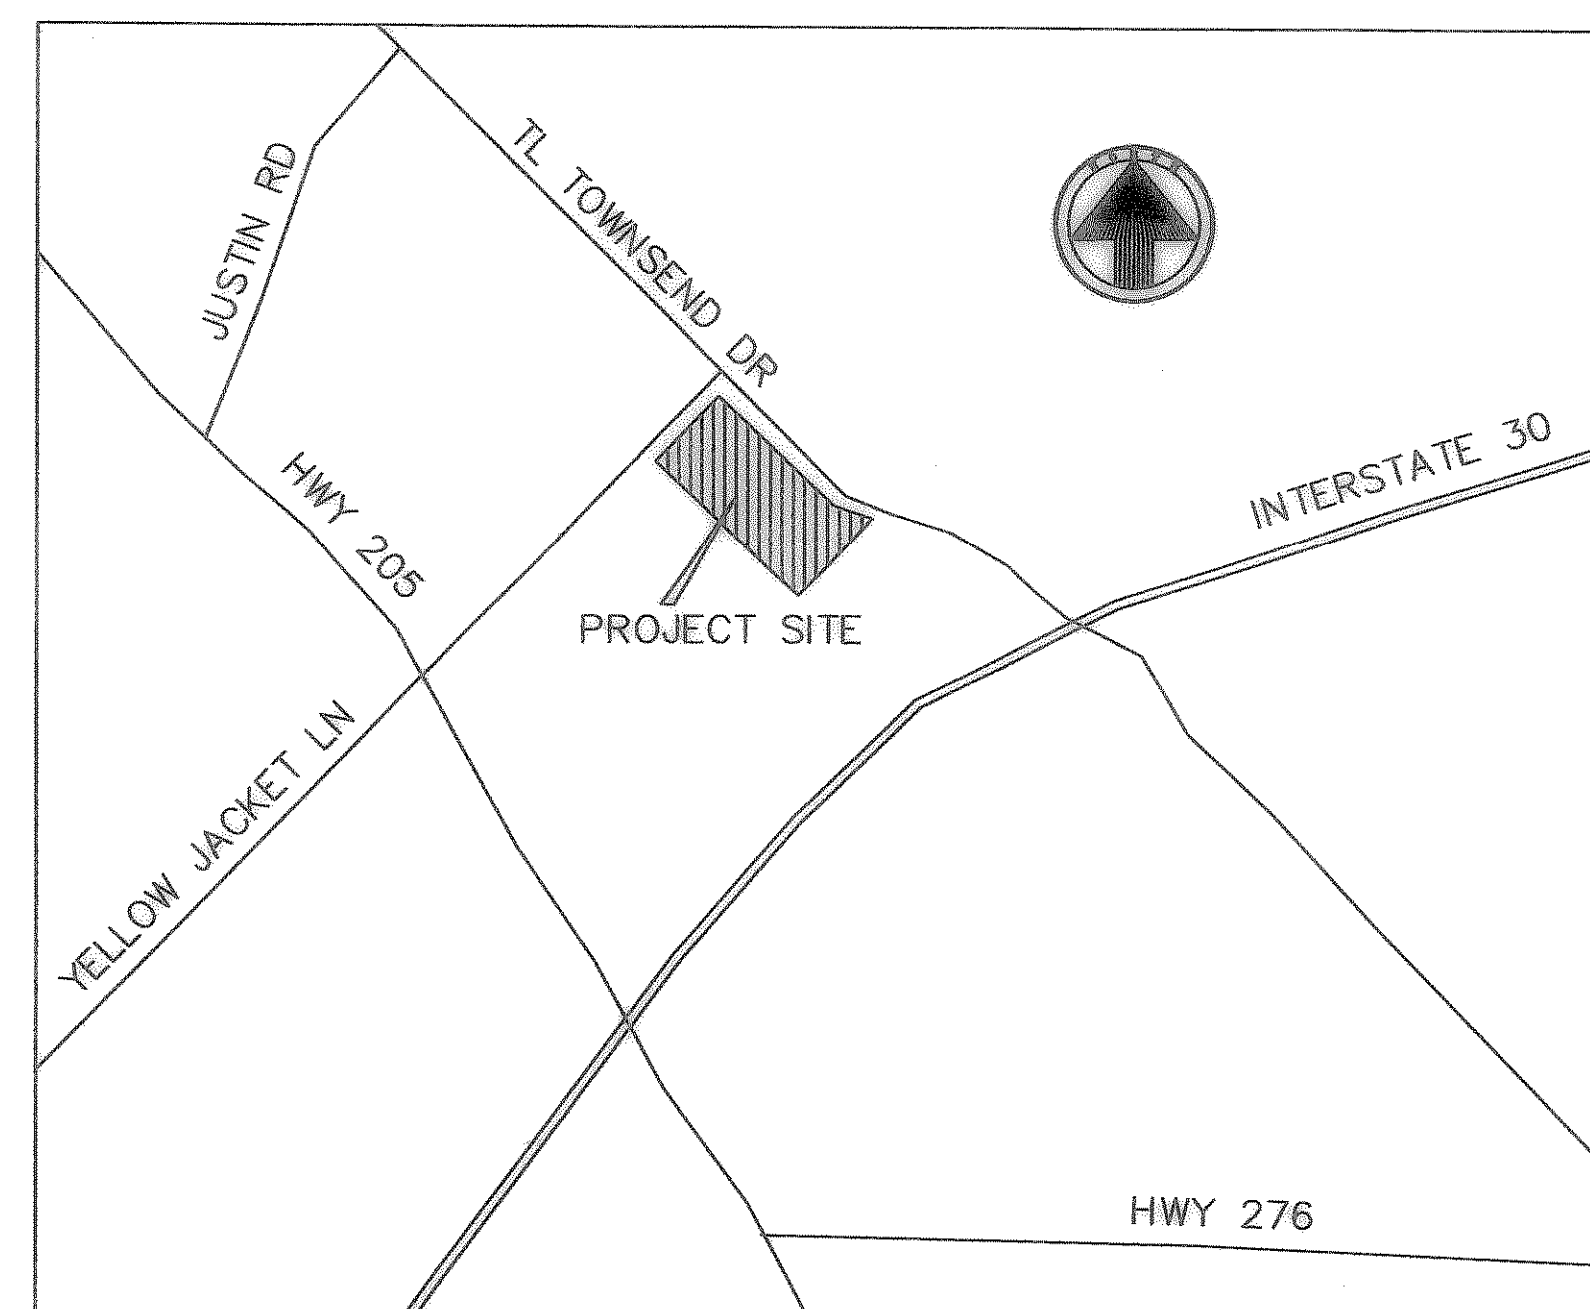


DEVELOPMENT PLANS

Rockwall Library

ROCKWALL COUNTY, TEXAS

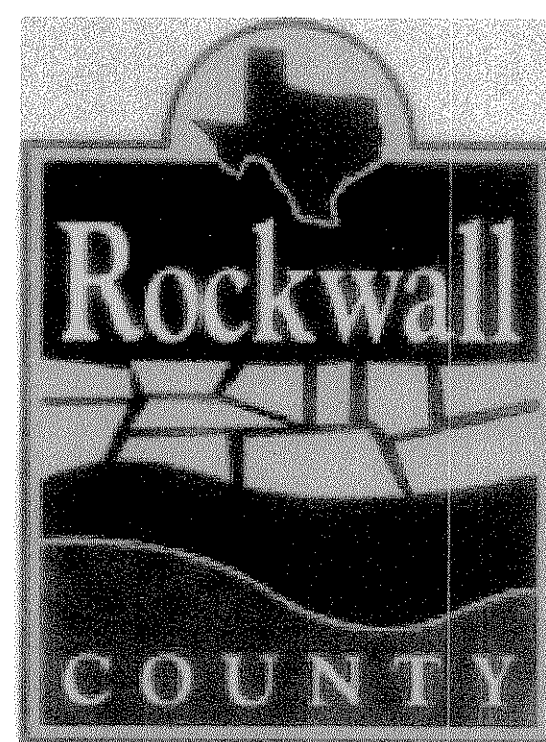


LOCATION MAP


INDEX of SHEETS

Sheet No.	Title
1	Cover Sheet
2	Dimensional Control & Paving Plan
3	Grading Plan
4	Water & Sanitary Sewer
5-5A	Sanitary Sewer Profile
6	Detention Pond Plan and Details
7	Drainage Area Map
8	Storm Sewer Plan
9	Storm Sewer Profiles
10	Erosion Control Plan
11	City of Rockwall Inspection Reference

THE SEAL APPEARING ON THIS
DOCUMENT WAS AUTHORIZED BY
CHRISTOPHER R. CUNY, P.E. 65642

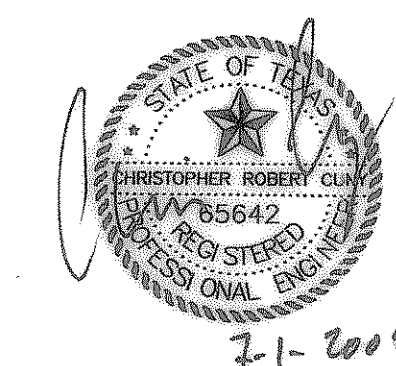

Record Drawings
Project # 05-017
July 2008

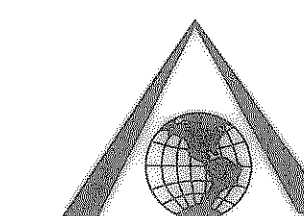

Engineer:
F.C. CUNY CORPORATION

#2 Horizon Court
Heath, Texas 75032
469.402.7700