


Revision	Date	Description

SANITARY SEWER PROFILE
Rockwall Library

F.C. CUNY CORPORATION

#2 Horizon Court
Heath, Texas 75032
Phone: 469-402-7700
Fax: 469-402-0700

THE SEAL APPEARING ON THIS DOCUMENT WAS AUTHORIZED BY CHRISTOPHER R. CUNY, P.E. 65642

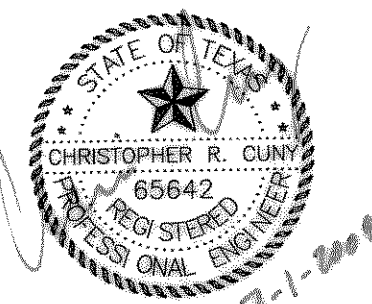

Drawn By: MSC
Checked By: DJW

Date: 6-22-07
Project No.: 05-017

Sheet Title:
Sanitary Sewer Profile

Scale: 1"=40' H.
1"=4' V.
Sheet No.: **5 A of 11**

LEGEND


SYM.	DESCRIPTION
---	R.O.W. LINE
---	EXISTING SS LINE
---	SS LINE
---	EASEMENT

NOTE:
CONTRACTOR TO LOCATE AND VERIFY ELEV. OF EXIST. 16" WATERLINE BEFORE CONSTRUCTION OF SANI. SWR.



IF WATERLINE/SANITARY SEWER CROSSING IS LESS THAN 2.0' VERTICAL CONCRETE ENCASEMENT OF THE SEWER 10' EITHER SIDE OF CROSSING IS REQUIRED.

CAUTION !!!
EXISTING UTILITIES AND UNDERGROUND FACILITIES INDICATED ON THESE PLANS HAVE BEEN LOCATED FROM REFERENCE INFORMATION. IT SHALL BE THE RESPONSIBILITY OF THE CONTRACTOR TO VERIFY BOTH HORIZONTALLY AND VERTICALLY THE LOCATION OF ALL EXISTING UTILITIES AND UNDERGROUND FACILITIES PRIOR TO CONSTRUCTION, TO TAKE NECESSARY PRECAUTIONS IN ORDER TO PROTECT ALL FACILITIES ENCOUNTERED. THE CONTRACTOR SHALL PRESERVE AND PROTECT ALL EXISTING UTILITIES FROM DAMAGE DURING CONSTRUCTION.

LINE "A"

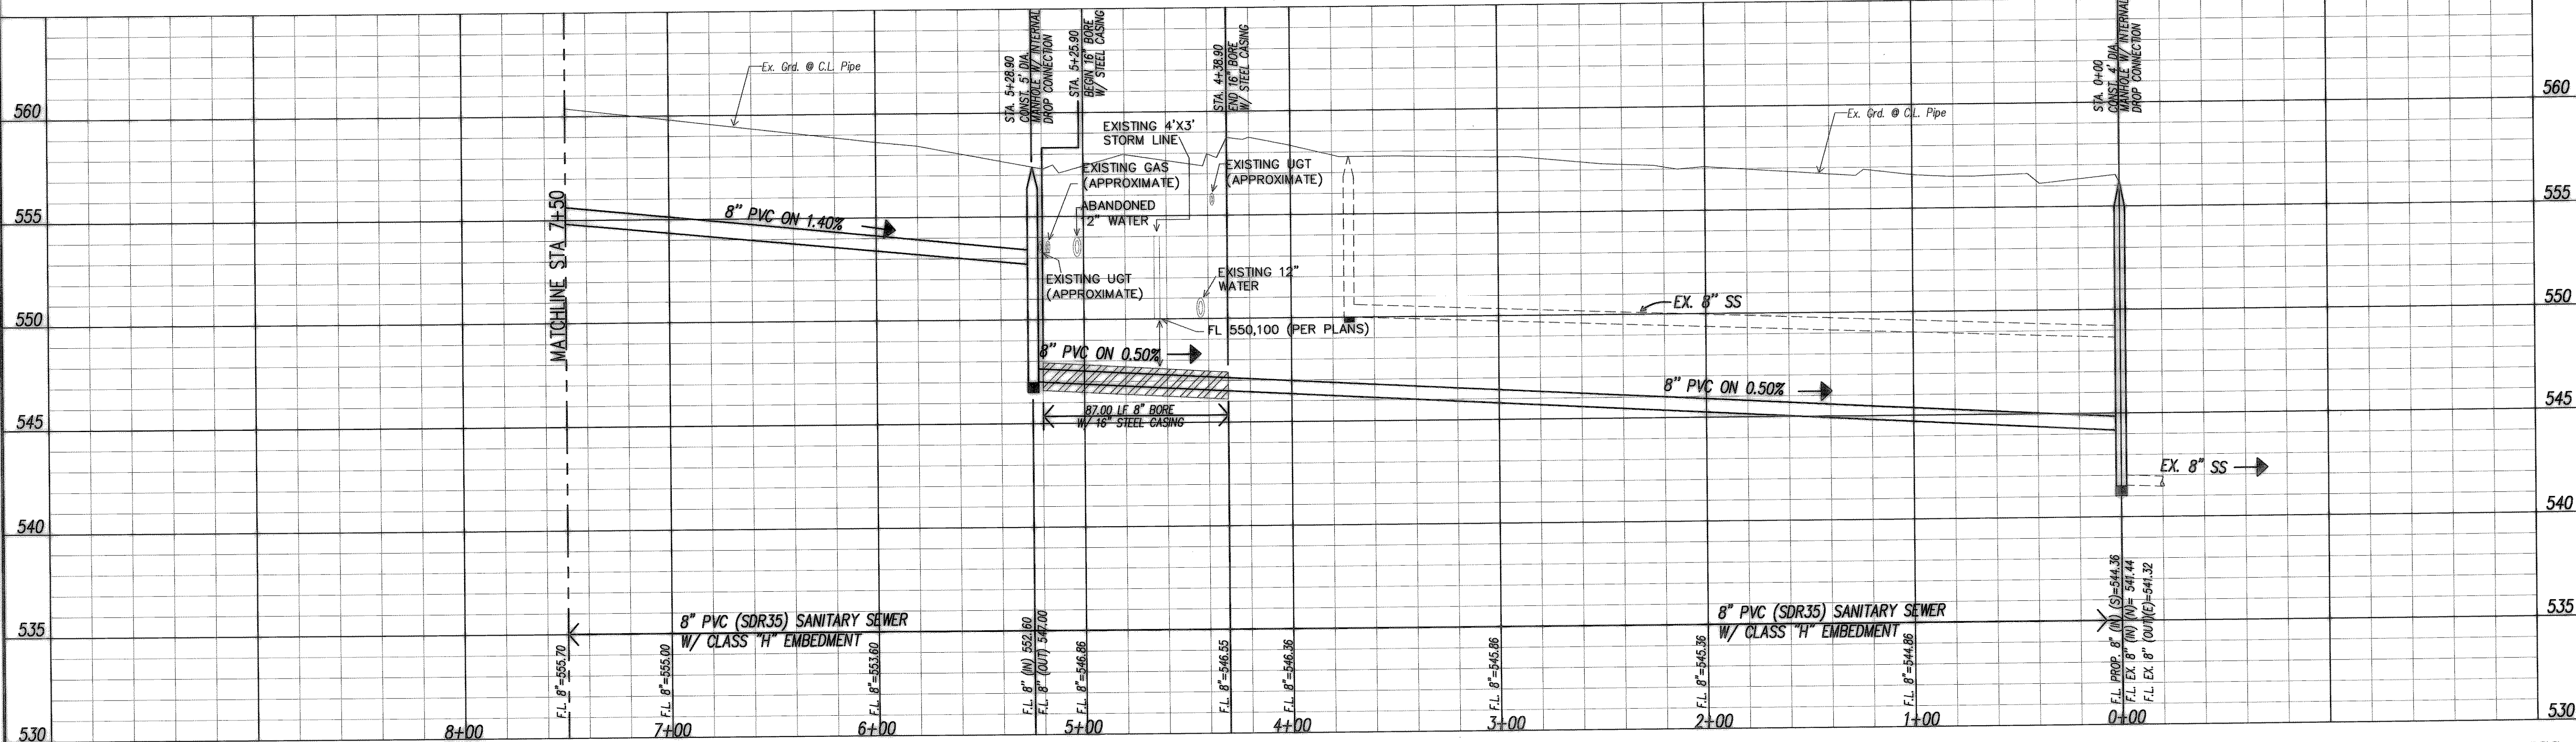

CONSTRUCTION RECORD DRAWINGS
JULY 2008

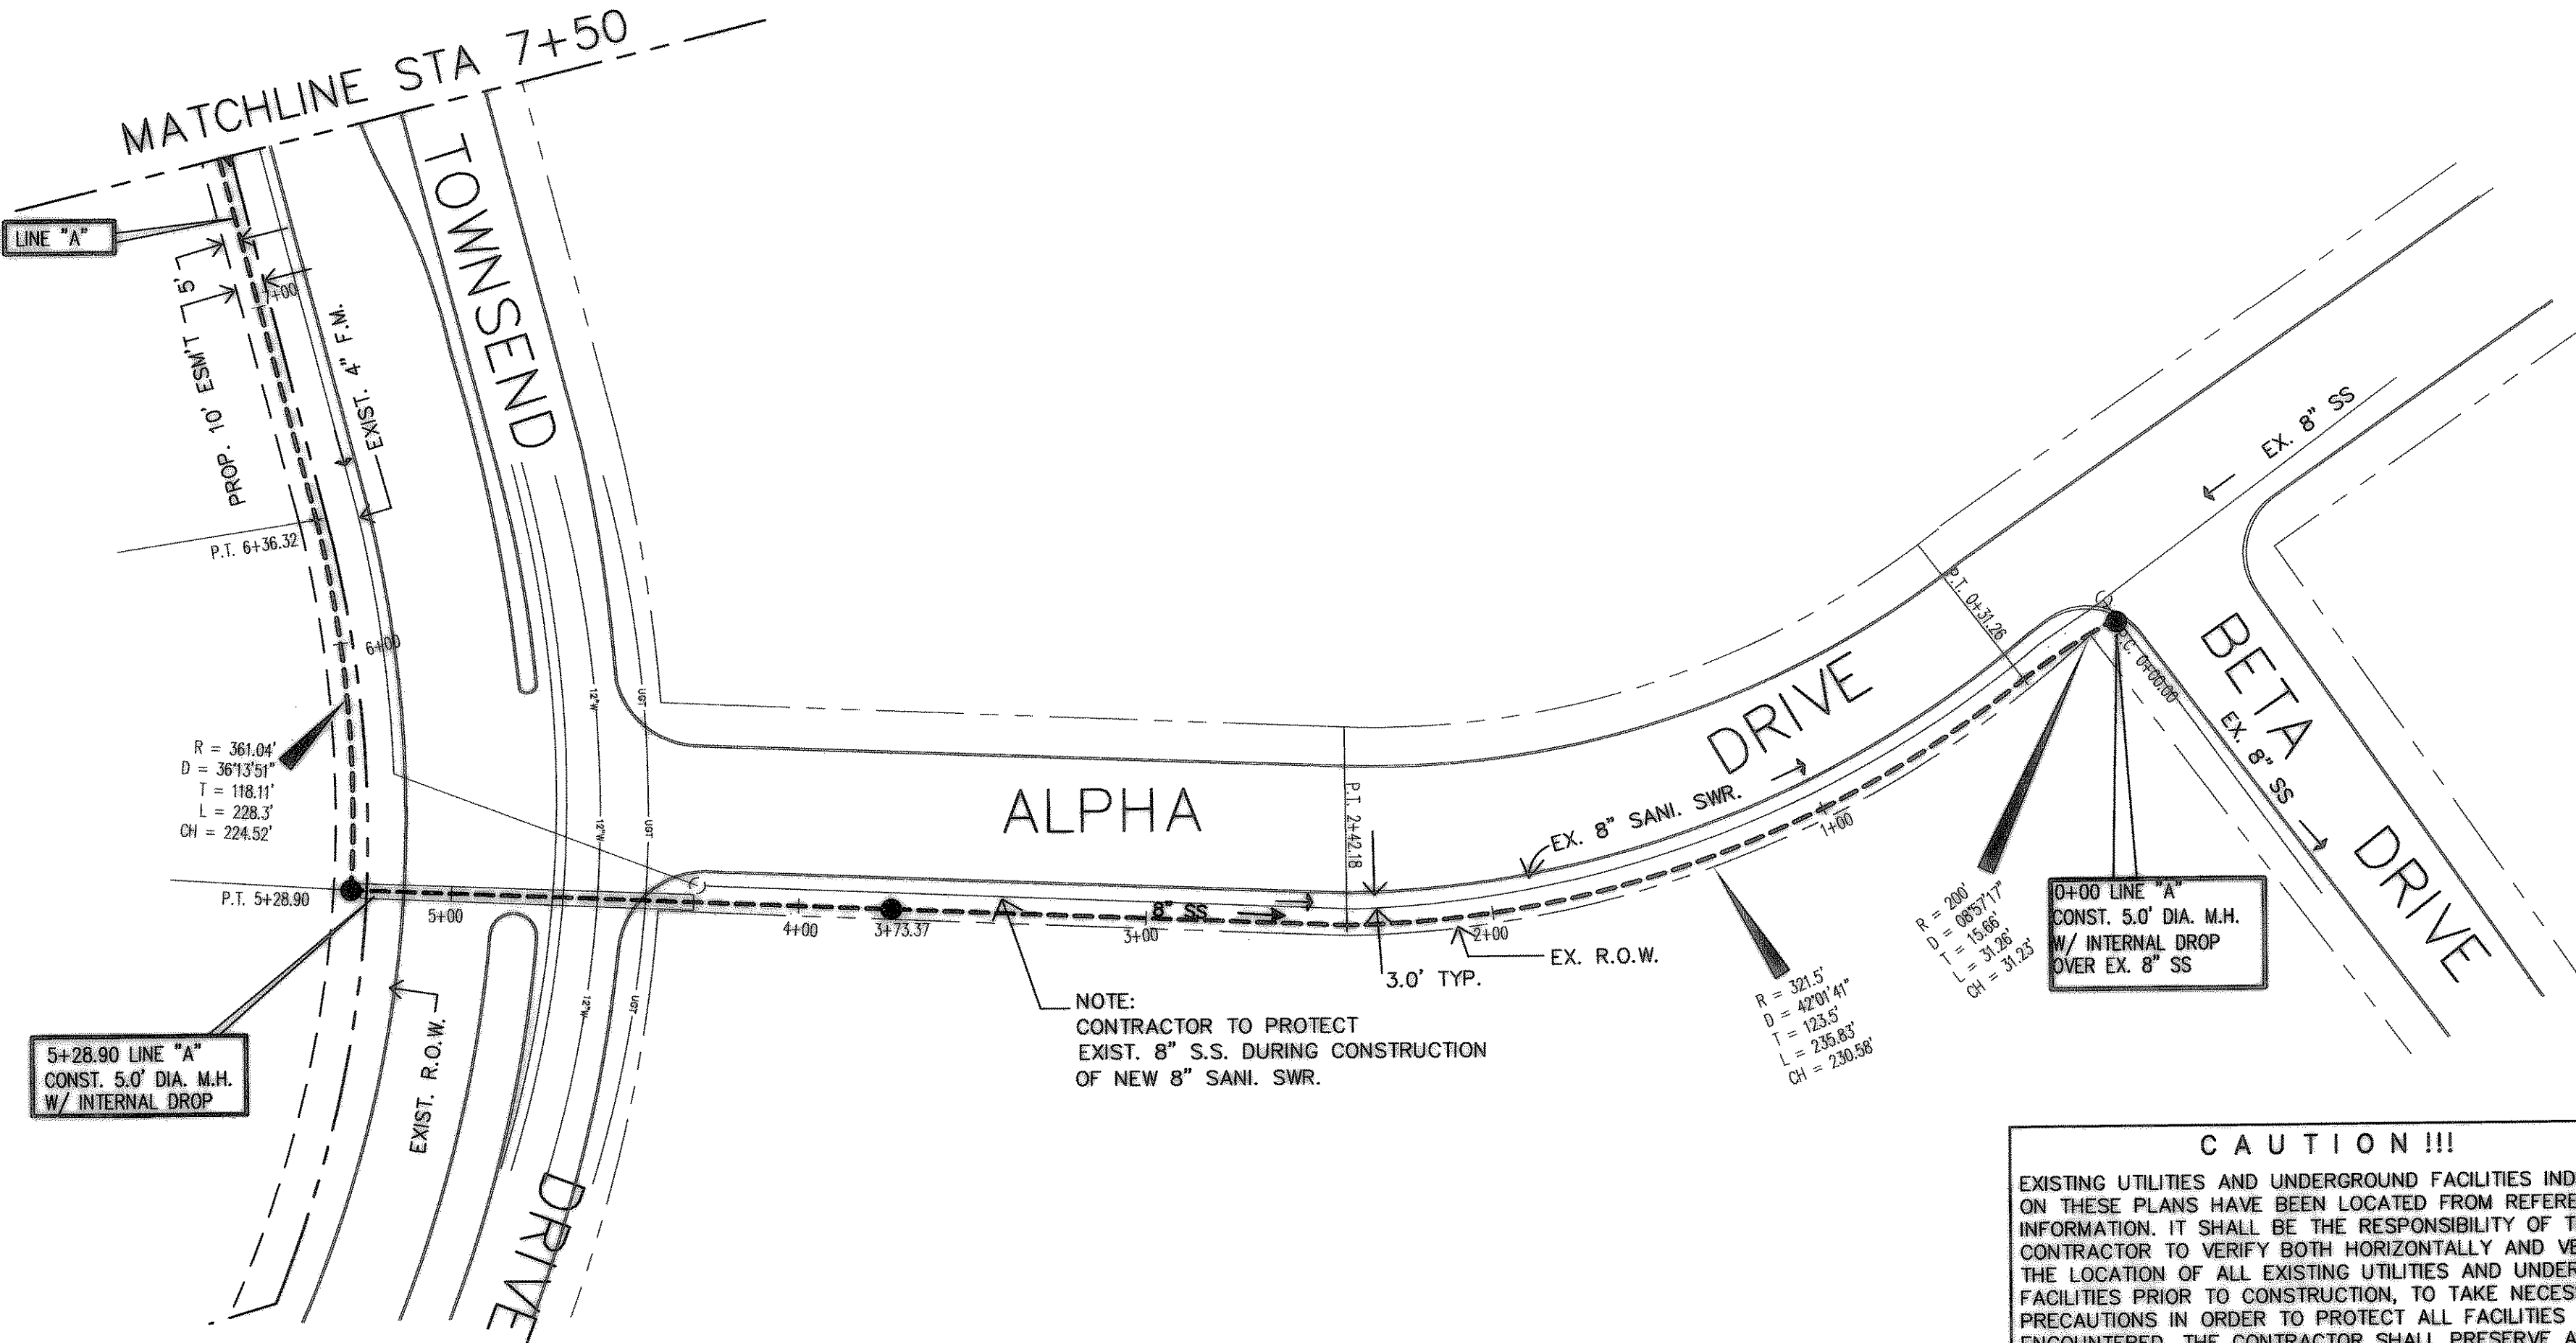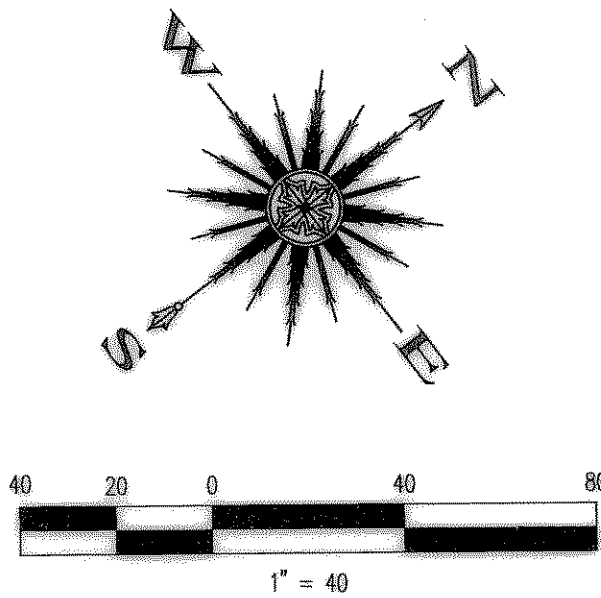

NOTE:
CONTRACTOR TO PROTECT EXIST. 8" S.S. DURING CONSTRUCTION OF NEW 8" SANI. SWR.

5+28.90 LINE "A"
CONST. 5.0' DIA. M.H.
W/ INTERNAL DROP

0+00 LINE "A"
CONST. 5.0' DIA. M.H.
W/ INTERNAL DROP
OVER EX. 8" SS