
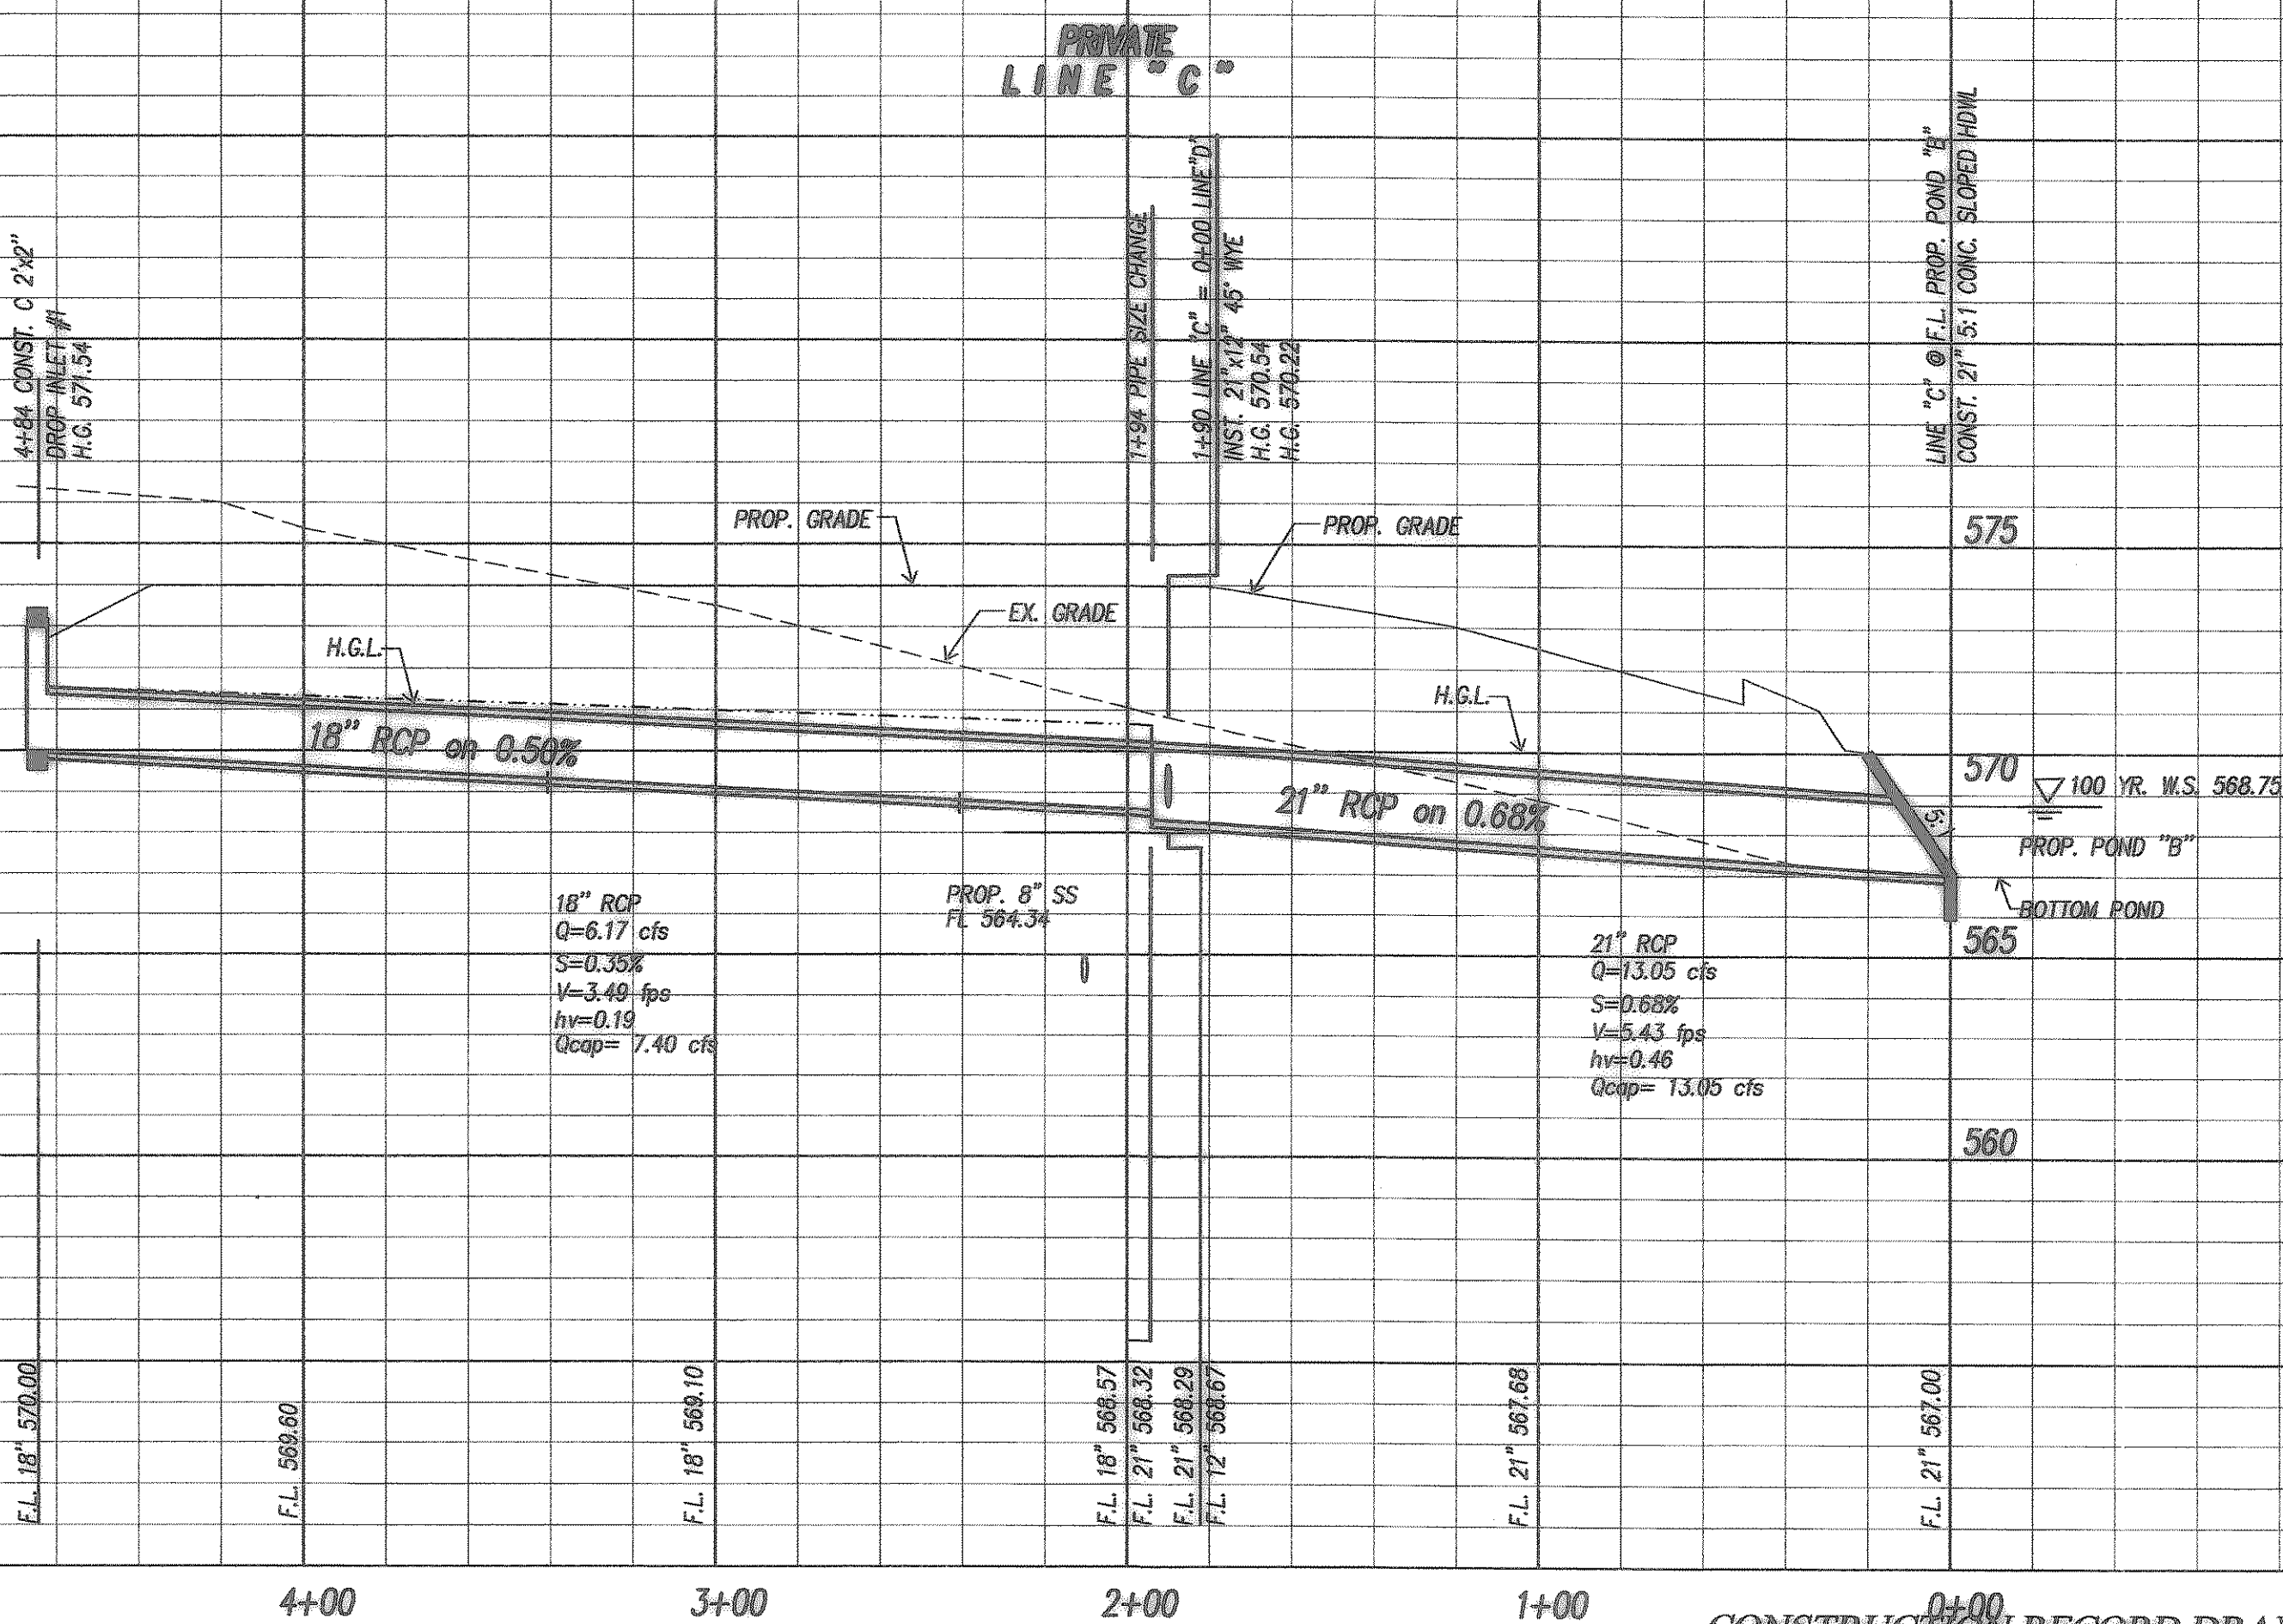
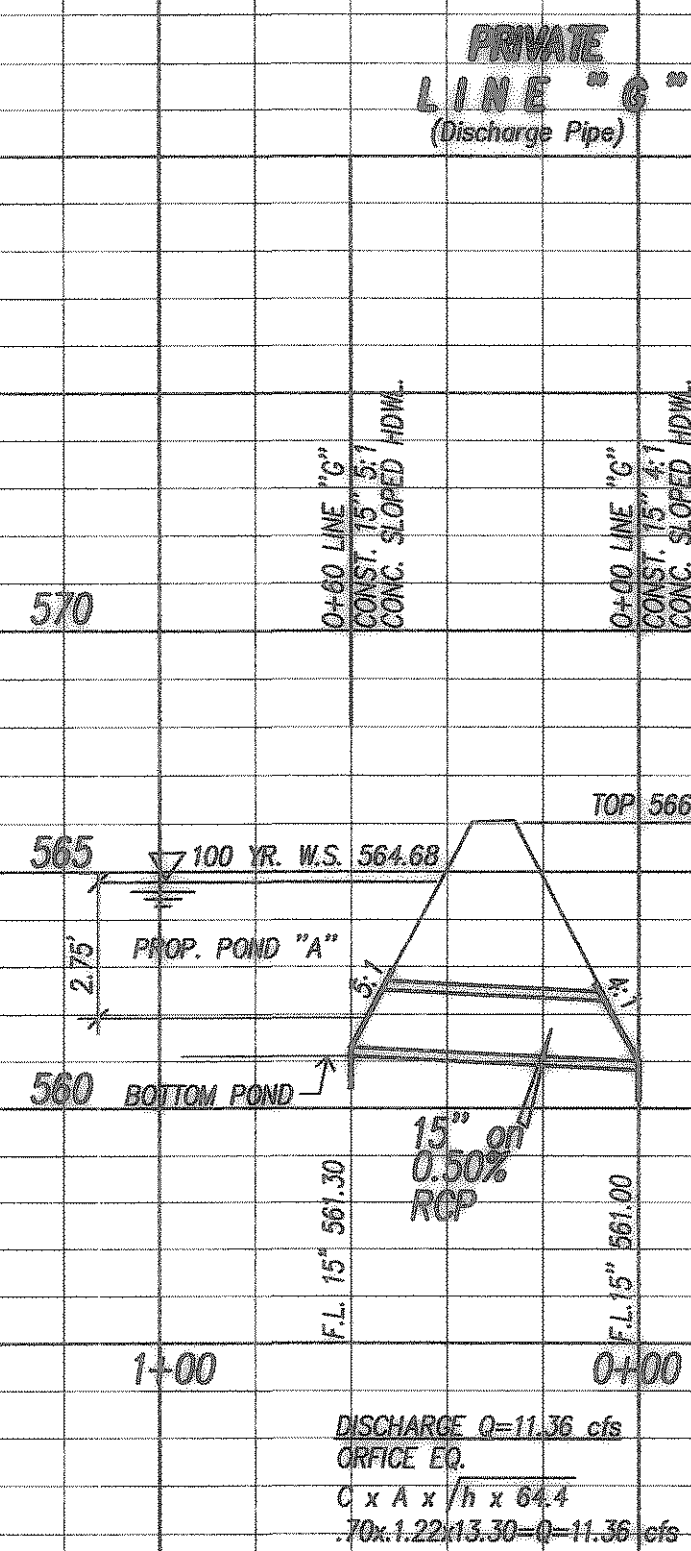
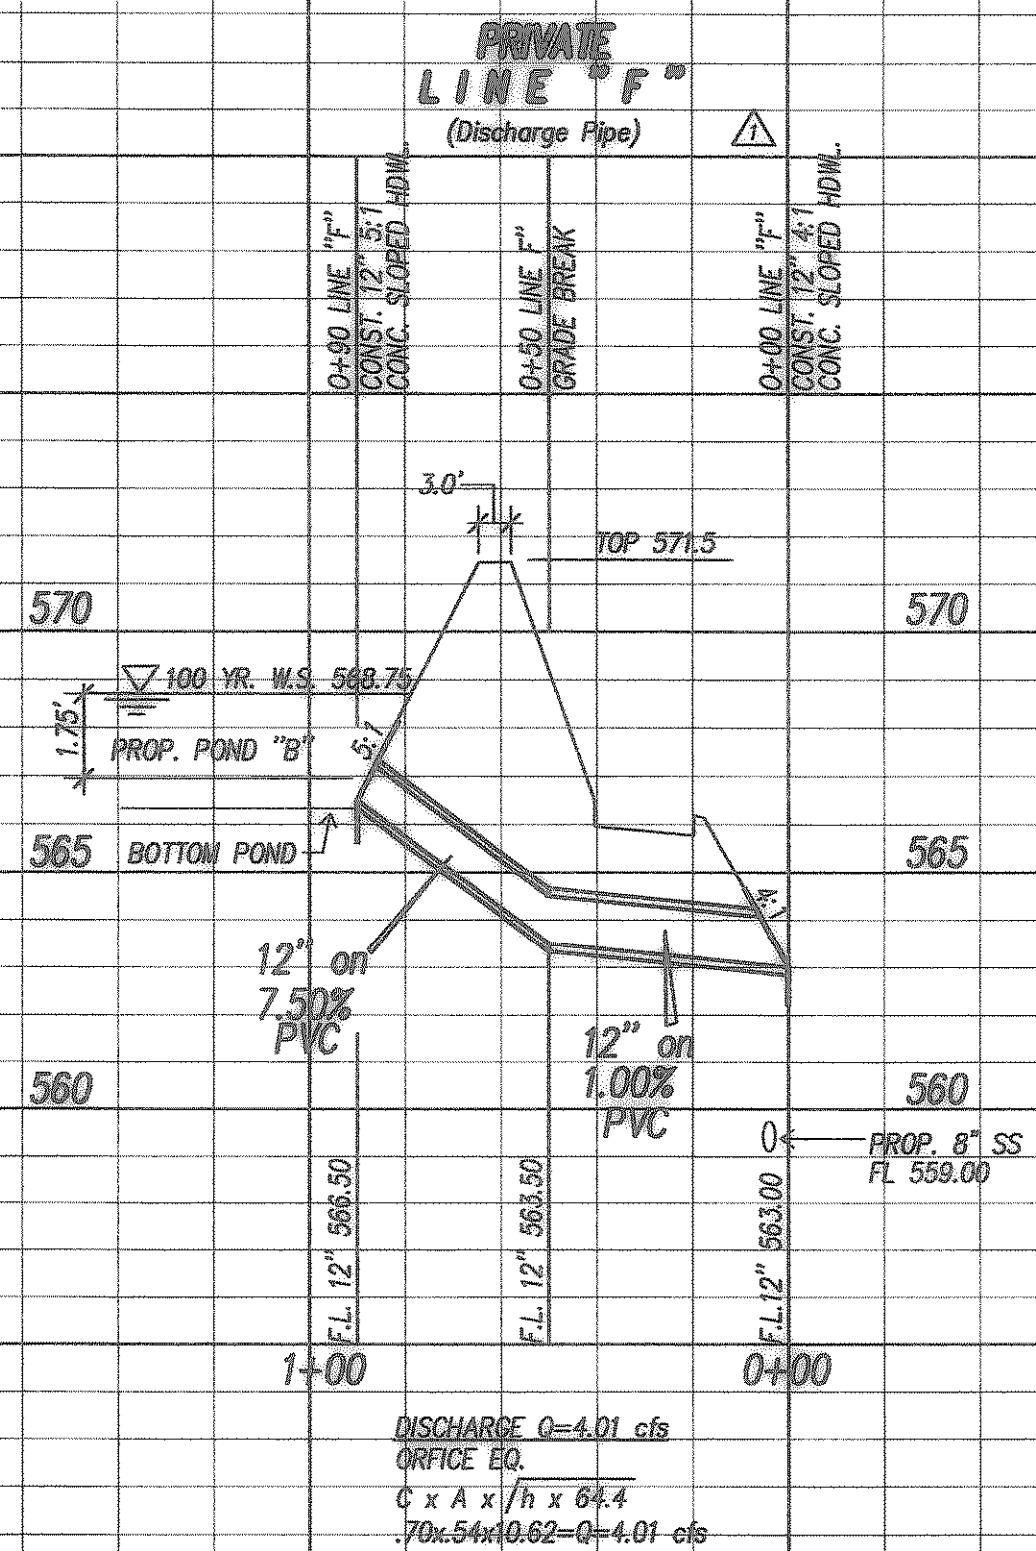
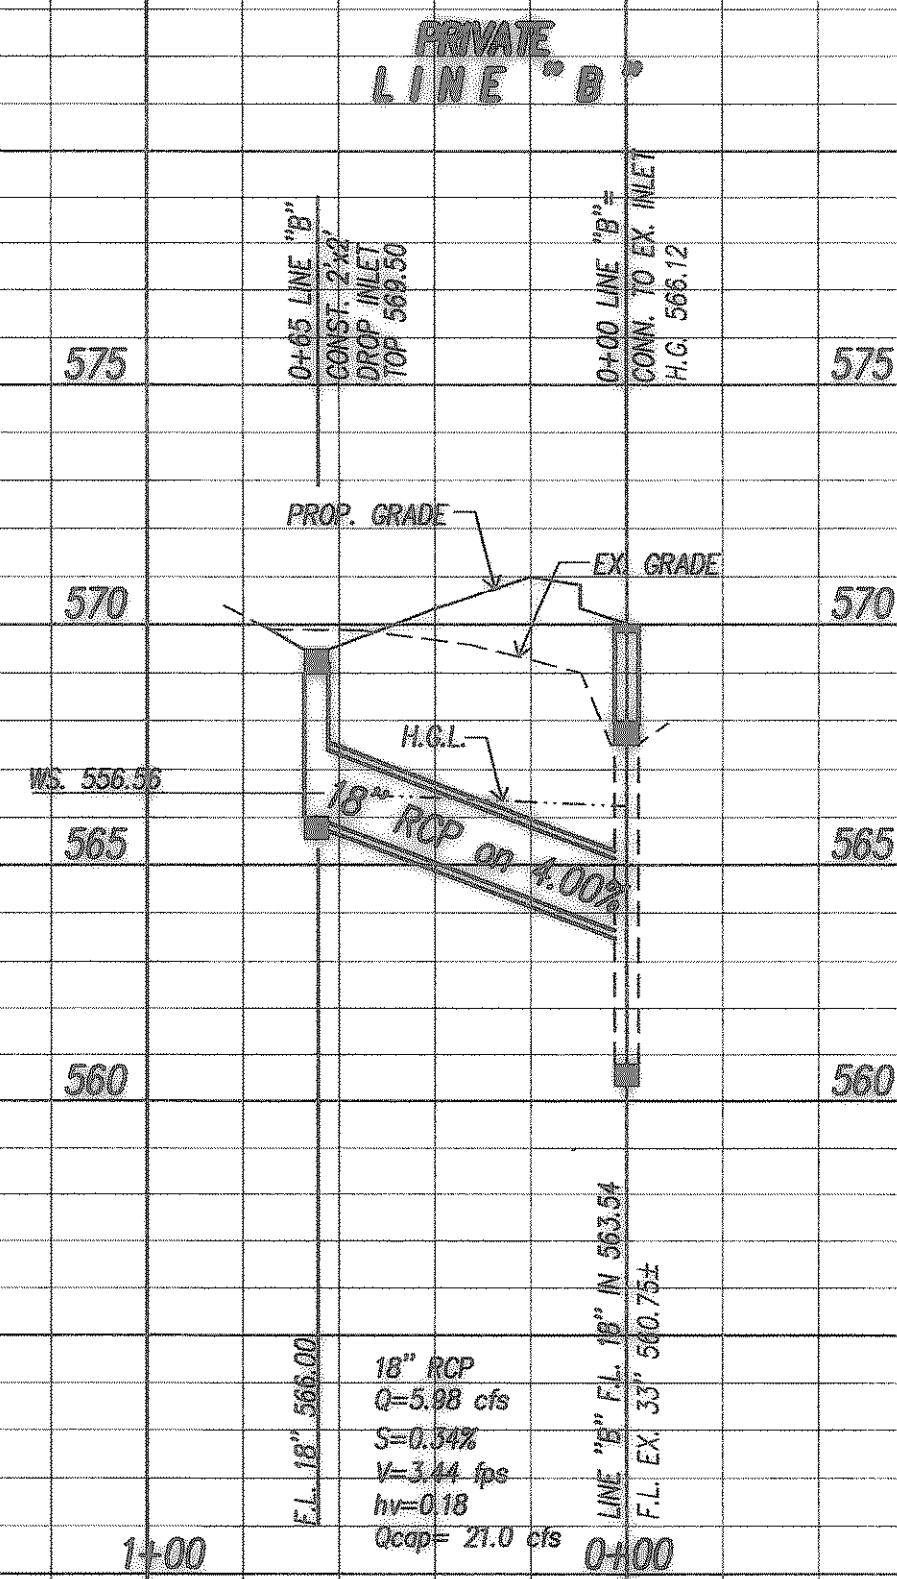


Z:\Projects\6-Commercial\Rockwall Library\Construction\rockwall-dm.dwg Tue Jul 01 15:07:52 2008

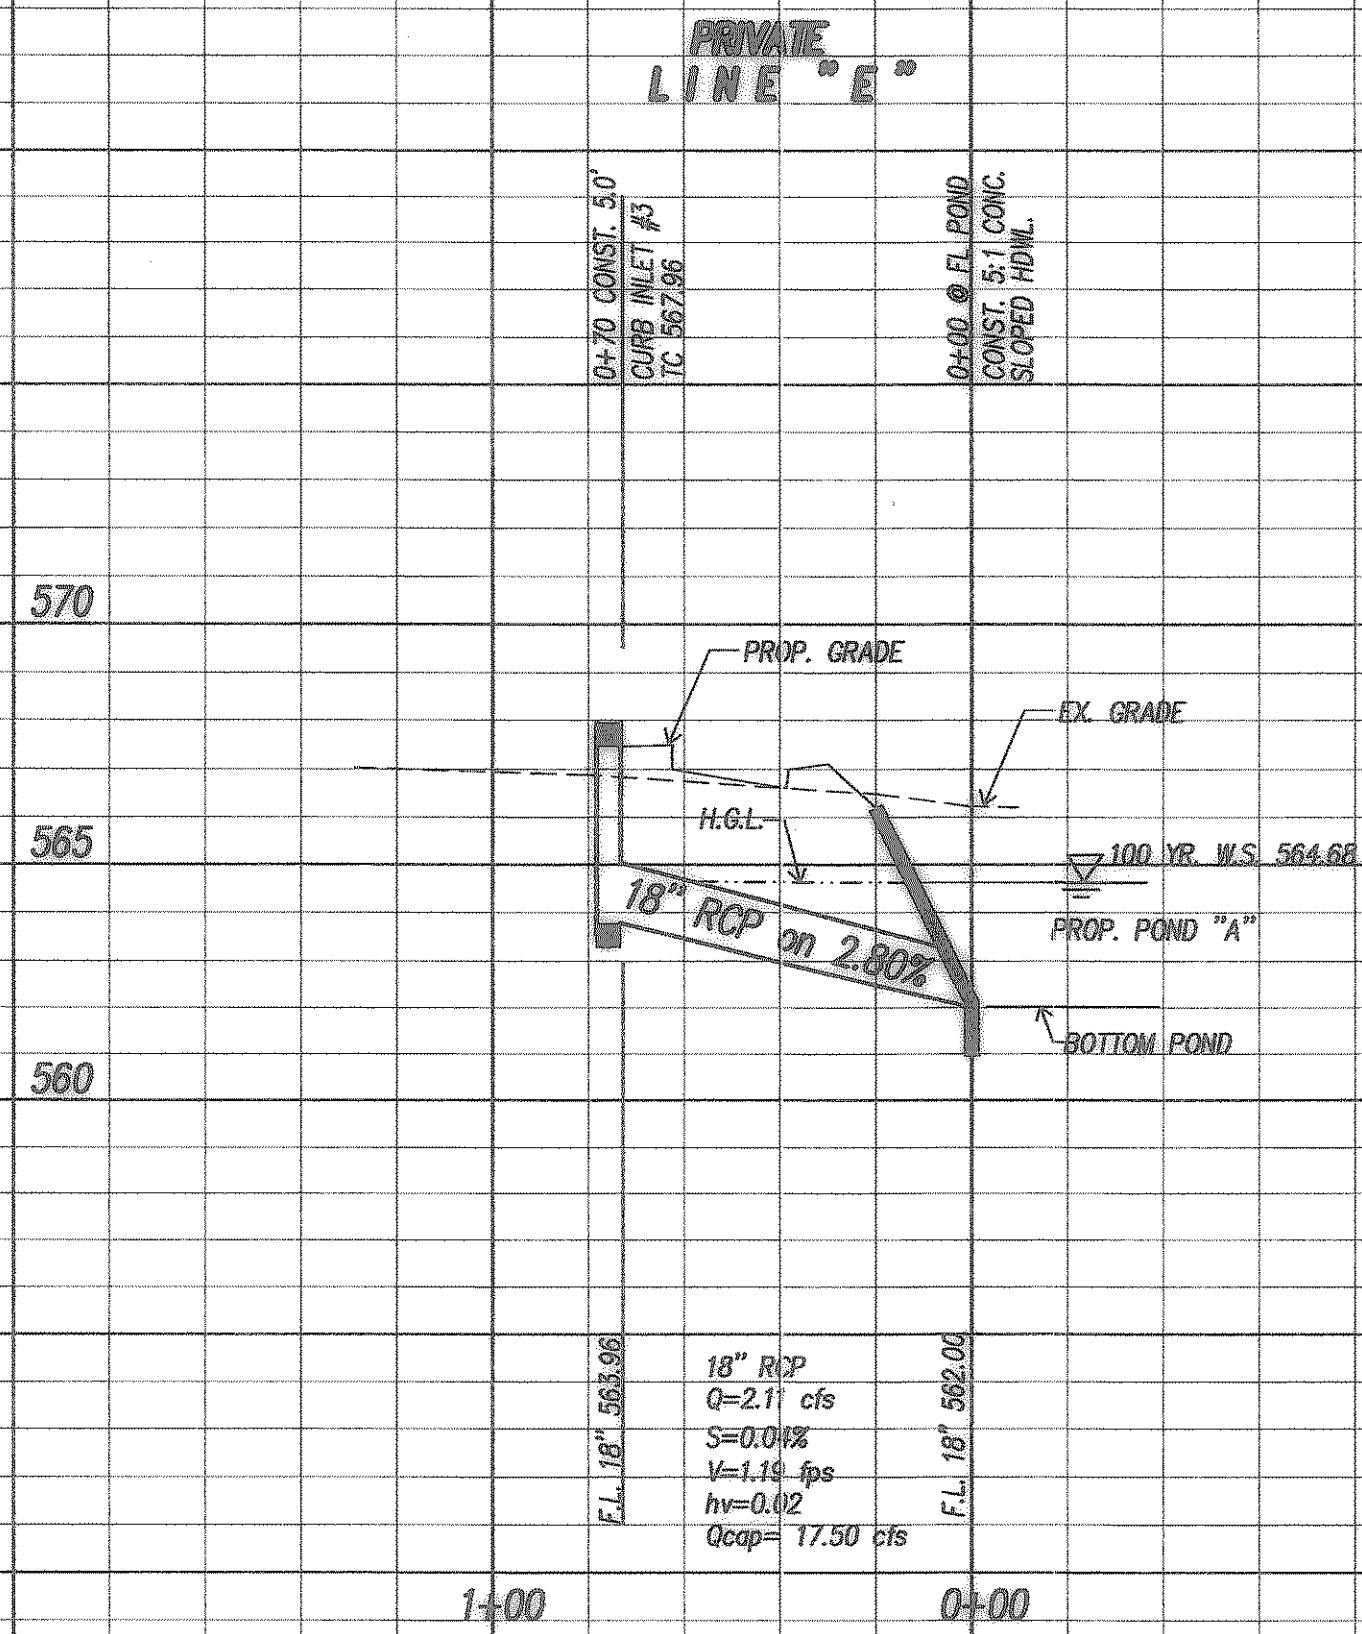


CONSTRUCTION RECORD DRAWINGS
JULY 2008

Revision	Date	Description

STORM SEWER PROFILES
Rockwall Library

F.C. CUNY CORPORATION

#2 Horizon Court
Heath, Texas 75032
Phone: 469-402-7700
Fax: 469-402-0700

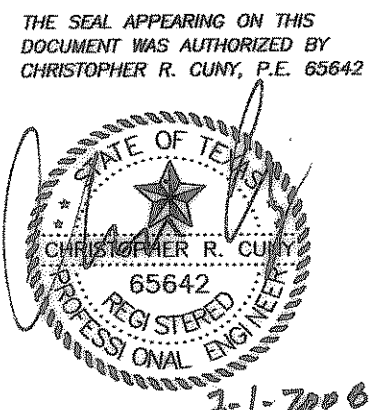

Drawn By: MSC	Checked By: DJW
Date: 6-22-07	Project No.: 05-017
Sheet Title:	

Storm Sewer Profiles

Scale: 1"=40'	Sheet No.: 9 of 11
------------------	-----------------------