

# CONSTRUCTION PLANS FOR

# 2008 ADDITION AND RENOVATIONS

# HERMAN E. UTLEY MIDDLE SCHOOL

1201 T L TOWNSEND DRIVE  
 ROCKWALL, ROCKWALL COUNTY, TEXAS 75087

**SHWGROUP**  
 ARCHITECTS | ENGINEERS | PLANNERS

CIVIL:  
 GLENN ENGINEERING, INC.

STRUCTURAL:  
 SHW GROUP LLP


MEP:  
 ESTES, McCLURE &  
 ASSOCIATES

LANDSCAPING:  
 GRUBBS-RAMSEY, INC.

FOOD SERVICE:  
 JMK DESIGNS

AQUATICS:  
 AQUATIC EXCELLENCE

**FINAL PLANS**  
 FOR BIDDING AND CONSTRUCTION

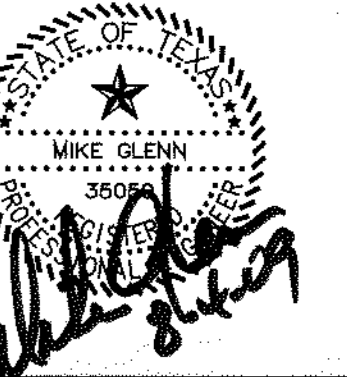

**HERMAN E. UTLEY  
 MIDDLE SCHOOL**


CHECKED:  
 File:  
 © 2008 SHW Group LLP

ISSUE: 08/22/2008

1	09/19/08	CITY REVISIONS #1
2	09/28/08	CITY REVISIONS #2
3	10/01/08	CITY REVISIONS #3
4	10/13/08	REVISIONS #4
5	11/18/08	GRADING REVISIONS
6	12/02/08	UTILITY REVISIONS
7	01/14/09	GRADING REVISIONS
8	02/26/09	GRADING REVISIONS
9	05/20/09	COURTYARD STORM
10	08/03/09	RECORD SET

**TABLE OF CONTENTS**

SHEET NO	TITLE
C 1.01	COVER SHEET
V 1.01	EAST TOPOGRAPHIC SURVEY
V 1.02	WEST TOPOGRAPHIC SURVEY
CD 1.01	EAST DEMOLITION PLAN
CD 1.02	WEST DEMOLITION PLAN
CS 1.01	OVERALL SITE PLAN
CS 1.02	UTLEY EAST SITE PLAN
CS 1.03	UTLEY WEST SITE PLAN
CS 1.04	AQUATIC CENTER SITE PLAN
CS 1.05	VISITOR SITE PLAN
CS 1.06	HOME SITE PLAN
CG 1.01	UTLEY OVERALL GRADING PLAN
CG 1.02	UTLEY EAST GRADING PLAN
CG 1.03	UTLEY WEST GRADING PLAN
CG 1.04	AQUATIC CENTER GRADING PLAN
CG 1.05	VISITORS SIDE GRADING PLAN
CG 1.06	HOME SIDE GRADING PLAN
CG 1.07	NOT USED
CG 1.08	NOT USED
CG 1.09	DRAINAGE AREA MAP
CG 1.10	DRAINAGE AREA CALCULATIONS
CG 1.10A	NOT USED
CG 1.10B	NOT USED
CG 1.11	SWPPP PLAN
CG 1.12	SWPPP DETAILS
CG 1.13	SWPPP DETAILS
CU 1.01	UTLEY EAST WATER AND SEWER PLAN
CU 1.02	UTLEY WEST WATER AND SEWER PLAN
CU 1.03	AQUATIC CENTER WATER AND SEWER PLAN
CU 1.04	VISITORS SIDE WATER AND SEWER PLAN
CU 1.05	HOME SIDE WATER AND SEWER PLAN
CU 1.06	UTLEY EAST ROOF DRAIN PLAN
CU 1.07	UTLEY WEST ROOF DRAIN PLAN
CU 1.08	UTLEY EAST STORM SEWER PLAN
CU 1.09	UTLEY WEST STORM SEWER PLAN
CU 1.10	VISITOR SIDE STORM SEWER PLAN
CU 1.11	NOT USED
CU 1.12	STORM PROFILES
CU 1.13	STORM PROFILES
CU 1.14	NOT USED
CU 1.15	NOT USED
CU 1.16	NOT USED
CU 1.17	NOT USED
CU 1.18	NOT USED
CP 1.01	PAVING PLAN
CP 102	PAVING DETAILS

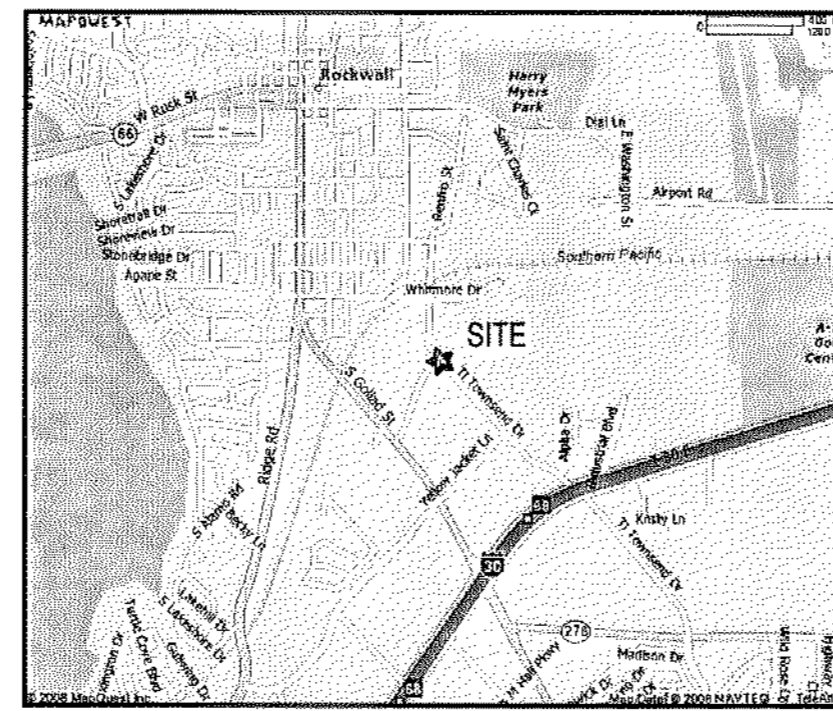

LOCATION MAP  
 NTS

GENERAL NOTE:  
 CONTRACTOR TO UTILIZE CITY APPROVED CONSTRUCTION PLANS FOR CONSTRUCTION OF ALL CIVIL RELATED FACILITIES. CONTRACTOR TO NOTIFY ARCHITECT/ENGINEER IMMEDIATELY OF ANY COST DISCREPANCIES BETWEEN THE CITY APPROVED SET AND BID SET WITH LATEST ADDENDUMS.

**OWNER**

ROCKWALL I.S.D.  
 1050 WILLIAMS STREET  
 ROCKWALL, TEXAS 75087  
 972-771-0605

**ARCHITECT**

SHW GROUP, INC.  
 5717 LEGACY DRIVE  
 DALLAS, TEXAS 75024  
 (214) 473-2400

**ENGINEER**

GLENN ENGINEERING  
 105 DECKER COURT, SUITE 910  
 IRVING, TEXAS 75062  
 (972) 717-5151

SEPTEMBER 2008

**RECORD DRAWING**  
 This is to certify that changes and corrections have been made to conform to the contractor's record of this project.  
 Signed: *Mike Glenn* Date: 8-4-09  
 Glenn Engineering Corporation

Sheet Title:  
**COVER SHEET**

**C 1.01**

Plotter: Aug 4, 2008, 9:38 AM by user: rcd, Saved: 8/22/2008 by user: rcd  
 W:\shw\p\c\shw\rockwall\UTLEY\2008 ADDITION\BIBL0 SET\2008 UTLEY\UTLIES.DWG