

DEMOLITION NOTES:

1. CONTRACTOR SHALL CONSULT ALL UTILITY COMPANIES AND VERIFY
LOCATION OF ALL UNDERGROUND UTILITIES PRIOR TO DEMOLITION.
REMOVAL AND RELOCATION OF ALL UTILITY LINES, METERS, VALVES,
ETC. SHALL BE PERFORMED PER REQUIREMENTS OF THE CITY OF
ROCKWALL & UTILITY COMPANIES. ANY DAMAGE TO PUBLIC
UTILITIES SHALL BE THE GENERAL CONTRACTOR'S RESPONSIBILITY TO

 ALL DEMOLITION AND CONSTRUCTION TO BE KEPT WITHIN THE BOUNDARIES OF THE SITE OR AS DESIGNATED BY CONSTRUCTION ENGINEER. ANY DAMAGE BY CONTRACTOR TO ADJOINING PROPERTIES OR ITEMS NOT IN THE DESIGNATED DEMOLITION AREA SHALL BE THE GENERAL CONTRACTOR'S RESPONSIBILITY TO CORRECT.

3. REMOVE ALL EXISTING UNDERGROUND UTILITIES, CAP AS REQUIRED. BACK FILL AND COMPACT PER CITY OF ROCKWALL SPECIFICATIONS.


4. REMOVE SURFACE PAVING AS NEEDED TO COMPLETE PAVING PLAN.

5. REMOVE EXISTING SIGNAGE, INCLUDING POSTS AND FOUNDATIONS.

6. REMOVE ANY OTHER ITEMS NOT INDICATED ABOVE BUT WHICH MUST BE DEMOLISHED TO COMPLETE PROJECT AS DESIGNATED BY SITE PLAN.

NOTE:
Contractor shall remove all sprinkler heads and equipment in the areas occupied by the construction and staging areas. Terminate/cap off all lines as required. All sprinkler heads and equipment shall be given to the owner. The contractor is responsible for making all necessary changes to the irrigation system that are required to keep the remaining areas outside the construction areas in working order. This includes relocation of any valves, piping, controls, etc., to operate the system.

At the completion of the construction project, this contractor is responsible for installation of an irrigation system throughout the areas that were involved in the construction. Equipment installed shall be the same as that which was removed. Owner will provide the equipment that was removed back to the contractor. Any additional equipment required will be by the contractor.

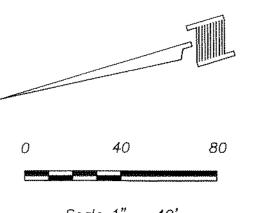

RECORD DRAWING

This is to certify that changes and

corrections have been made to conform

Glenn Engineering Corporation



CIVIL: GLENN ENGINEERING, INC.

STRUCTURAL: SHW GROUP LLP

MEP: ESTES, McCLURE &

ASSOCIATES

LANDSCAPING: GRUBBS-RAMSEY, INC.


NOD REDVICE:


FOOD SERVICE: JMK DESIGNS

AQUATIC EXCELLENCE

AQUATICS:

FINAL PLANS
FOR BIDDING AND CONSTRUCTION

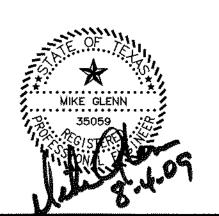

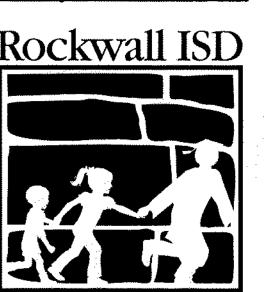

HERMAN E. UTLEY MIDDLE SCHOOL

CHECKED:
File:
© 2008 SHW Group LLP

ISSUE: 08/22/2008

1 09/19/08 CITY REVISIONS #1
2 09/28/08 CITY REVISIONS #2
3 10/01/08 CITY REVISIONS #3
4 10/13/08 REVISIONS #4

6 12/02/08 UTILITY REVISIONS
7 01/14/09 GRADING REVISIONS

02/26/09 GRADING REVISIONS

08/03/09 RECORD SET

et Title:

Sheet Title:

EAST

DEMOLITION
PLAN

CD 1.01