



GENERAL STORM SEWER NOTES:

- ALL CONSTRUCTION TO BE IN ACCORDANCE WITH THESE PLANS AND CITY OF ROCKWALL STANDARDS AND SPECIFICATIONS.
- 2. PRIOR TO STARTING CONSTRUCTION, THE CONTRACTOR SHALL MAKE CERTAIN THAT ALL REQUIRED PERMITS AND APPROVALS HAVE BEEN OBTAINED. NO CONSTRUCTION OR FABRICATION SHALL BEGIN UNTIL THE CONTRACTOR HAS RECEIVED AND THOROUGHLY REVIEWED ALL PLANS AND OTHER DOCUMENTS APPROVED BY ALL OF THE PERMITTING AUTHORITIES
- ALL WORK SHALL BE PERFORMED IN ACCORDANCE WITH THESE PLANS AND SPECIFICATIONS AND THE REQUIREMENTS AND STANDARDS OF THE LOCAL GOVERNING AUTHORITY.
- 4. IN THE EVENT AN ITEM IS NOT COVERED IN THE CITY OF ROCKWALL. SPECIFICATIONS, THE ENGINEER'S DECISION SHALL APPLY.
- 5. BARRICADING, TRAFFIC CONTROL, AND PROJECT SIGNS SHALL CONFORM TO "STATE DEPARTMENT OF HIGHWAYS AND PUBLIC TRANSPORTATION BARRICADING AND CONSTRUCTION STANDARDS".
- 6. THE GENERAL CONTRACTOR AND ALL SUB-CONTRACTORS SHALL VERIFY THE SUITABILITY OF ALL EXISTING AND PROPOSED SITE CONDITIONS INCLUDING GRADES AND DIMENSIONS BEFORE COMMENCEMENT OF ANY CONSTRUCTION. IN THE EVENT OF ANY CONFLICT AND PRIOR TO COMMENCEMENT OF ANY CONSTRUCTION, IMMEDIATELY NOTIFY ENGINEER. MINOR ADJUSTMENTS OF FINISH GRADE TO ACCOMPLISH SPOT DRAINAGE ARE ACCEPTABLE, IF NECESSARY, UPON PRIOR APPROVAL OF ENGINEER. PAVING INSTALLED SHALL "FLUSH OUT" AT ANY JUNCTURE WITH EXISTING PAVING.
- 7. THE LOCATIONS OF UNDERGROUND UTILITIES SHOWN ON THIS PLAN ARE BASED ON FIELD SURVEYS AND LOCAL UTILITY COMPANY RECORDS. IT SHALL BE THE CONTRACTOR'S FULL RESPONSIBILITY TO CONTACT THE VARIOUS UTILITY COMPANIES TO LOCATE THEIR UTILITIES PRIOR TO STARTING CONSTRUCTION.
- 8. CONTRACTOR SHALL VERIFY ALL EXISTING INVERTS, RIM ELEVATIONS AND SIZES PRIOR TO CONSTRUCTION.
- 9. ALL NON RCP DRAIN PIPE SHALL BE PVC SCH 40, ADS OR APPROVED EQUAL.
- 10. ALL RCP SHALL BE CLASS III.
- 11. W.E. AS INDICATED ON INLET CALLS INDICATES WATER ELEVATION AT INLET DURING 100 YEAR STORM EVENT.

NOT

SEE SHEET MP PLANS FOR DOWNSPOUT & ROOF DRAIN LOCATIONS. ALL ROOF DRAINS, CANOPY'S AND DOWNSPOUTS SHALL BE CONNECTED TO STORM SEWER SYSTEM.

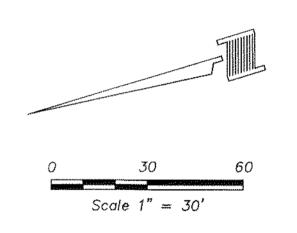


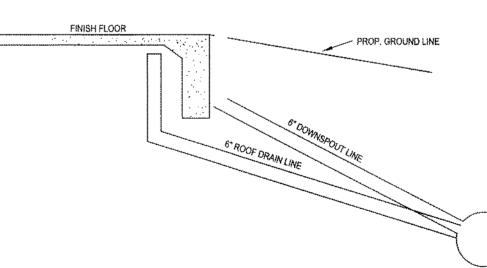

DOWNSPOUT DETAIL

NOTE:

1. AT ALL LOCATIONS OF DOWNSPOUTS AND ROOF DRAINS A
6" PVC PIPE IS TO BE INSTALLED FROM THE 12" PVC LINE TO
THE FOUNDATION AND EXTEND UP ABOVE THE FINISH FLOOR ELEV.
SEE ARCH. PLAN FOR THE CONNECTION DETAIL AND
THE ROOF PLAN FOR ACTUAL DOWNSPOUT AND ROOF DRAIN
LOCATIONS.

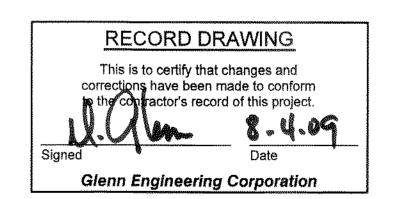



CIVIL:

STRUCTURAL: SHW GROUP LLP

MEP: ESTES, McCLURE &

ASSOCIATES

LANDSCAPING: GRUBBS-RAMSEY, INC.


RUBBS-RAMSEY, INC.


FOOD SERVICE: JMK DESIGNS

AQUATICS: AQUATIC EXCELLENCE

FINAL PLANS

FOR BIDDING AND CONSTRUCTION

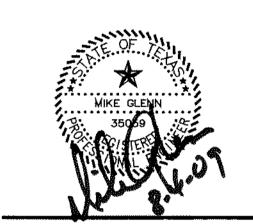

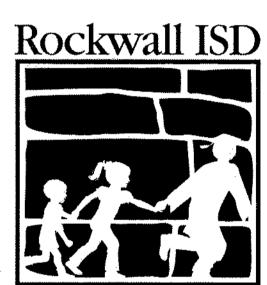

HERMAN E. UTLEY MIDDLE SCHOOL

CHECKED: File: © 2008 SHW Group LLP

ISSUE: 08/22/2008

1 09/19/08 CITY REVISIONS #1

3 10/01/08 CITY REVISIONS #3

2 09/28/08 CITY REVISIONS #2

4 10/13/08 REVISIONS #4

5 11/18/08 GRADING REVISIONS

6 12/02/08 UTILITY REVISIONS

7 01/14/09 GRADING REVISIONS 8 02/25/09 GRADING REVISIONS

9 05/20/09 COURTYARD STORM

10 08/03/09 RECORD SET

Sheet Title:
UTLEY EAST
ROOF DRAIN

PLAN

CH 1 06

4107.043.0