


CONSTRUCTION PLANS FOR

2008 ADDITION AND RENOVATIONS WILKERSON SANDERS STADIUM

1201 T L TOWNSEND DRIVE ROCKWALL, ROCKWALL COUNTY, TEXAS 75087

GENERAL NOTE:

CONTRACTOR TO UTILIZE CITY APPROVED CONSTRUCTION PLANS FOR CONSTRUCTION OF ALL CIVIL RELATED FACILITIES. CONTRACTOR TO NOTIFY ARCHITECT/ENGINEER IMMEDIATELY OF ANY COST DISCREPANCIES BETWEEN THE CITY APPROVED SET AND BID SET WITH LATEST ADDENDUMS.

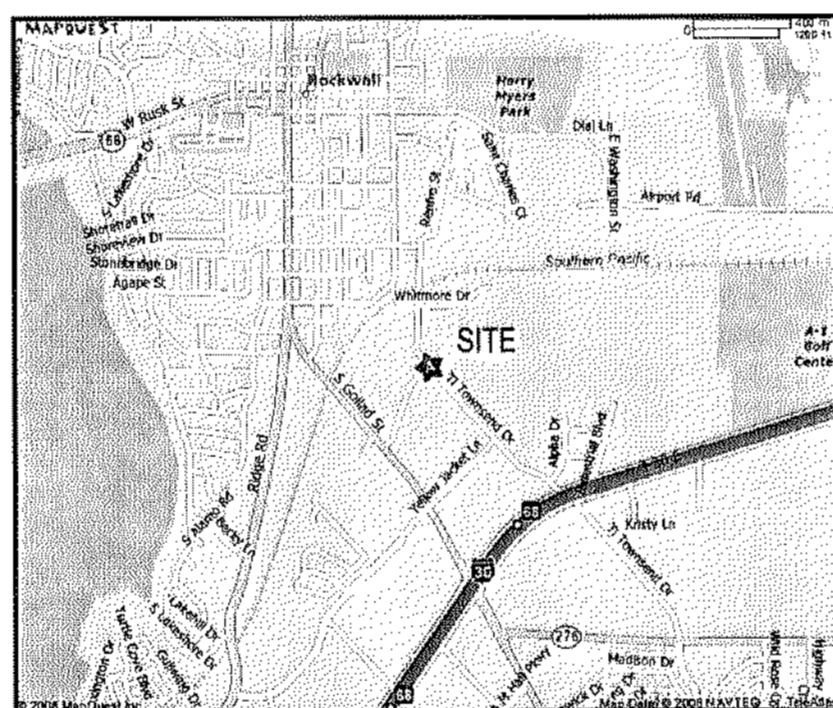

LOCATION MAP
NTS

TABLE OF CONTENTS

SHEET NO	TITLE
C 1.01	COVER SHEET
V 1.01	NORTH TOPOGRAPHIC SURVEY
V 1.02	SOUTH TOPOGRAPHIC SURVEY
CS 1.01	OVERALL SITE PLAN
CS 1.02	WEST SITE PLAN
CS 1.03	NORTH SITE PLAN
CS 1.04	SOUTH SITE PLAN
CG 1.01	OVERALL GRADING PLAN
CG 1.02	WEST GRADING PLAN
CG 1.03	NORTH GRADING PLAN
CG 1.04	SOUTH GRADING PLAN
CG 1.05	NOT USED
CG 1.06	DRAINAGE AREA MAP
CG 1.07	DRAINAGE AREA CALCULATIONS
CG 1.08	NOT USED
CG 1.09	NOT USED
CG 1.10	SWPPP PLAN
CG 1.11	SWPPP DETAILS
CG 1.12	SWPPP DETAILS
CU 1.01	NORTH UTILITY PLAN
CU 1.02	HOME SIDE CENTER UTILITY PLAN
CU 1.03	HOME SIDE STORM SEWER PLAN
CU 1.04	UNDERSTANDS DRAINAGE PLAN
CU 1.05	TRENCH DETAILS
CP 1.01	PAVING PLAN
CP 1.02	PAVING DETAILS

OWNER

ROCKWALL I.S.D.
1050 WILLIAMS STREET
ROCKWALL, TEXAS 75087
972-771-0605

ARCHITECT

SHW GROUP, INC.
5717 LEGACY DRIVE
DALLAS, TEXAS 75024
(214) 473-2400

ENGINEER

GLENN ENGINEERING
105 DECKER COURT, SUITE 910
IRVING, TEXAS 75062
(972) 717-5151

SEPTEMBER 2008

RECORD DRAWING

This is to certify that changes and corrections have been made to conform to the contractor's record of this project.

Signed: *J. Glenn* Date: *8.4.09*

Glenn Engineering Corporation




SHWGROUP
ARCHITECTS | ENGINEERS | PLANNERS

Consultants:

- CIVIL:
GLENN ENGINEERING CORP
- STRUCTURAL:
SHW GROUP, LLP
- MEP:
ESTES McCLURE &
ASSOCIATES, INC.
FOOD SERVICE:
JMK FOODSERVICE
CONSULTING & DESIGN, LLC
- LANDSCAPING:
RAMSEY LANDSCAPE
ARCHITECTS, LLP

Final Plans for Bidding and Construction

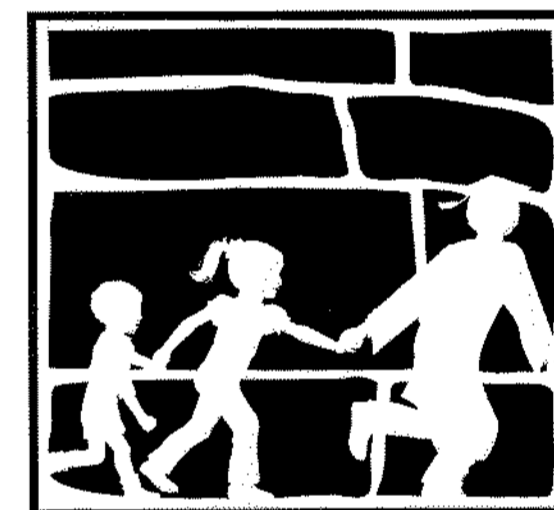

Rockwall
INDEPENDENT SCHOOL DISTRICT

WILKERSON SANDERS STADIUM RENOVATIONS ROCKWALL, TEXAS

Project Number: 4107.048.00
 Drawing Date: 05/29/2008
 Drawn:
 Checked:
 Scale:
 ACAD File: 2008WILKERSON-SANDERS-DETAIL
 © 2008 SHW Group, LLP

Revisions:

Rev	Date	Description
1	11/05/08	CITY REVISIONS
2	12/02/08	CITY REVISIONS #2
3	12/12/08	CITY REVISIONS #3
4	12/16/08	CITY REVISIONS #4
5	01/26/09	CITY REVISIONS #5
6	08/03/09	RECORD SET

Sheet Title:
COVER SHEET

C 1.01