

SHWGROUP
ARCHITECTS | ENGINEERS | PLANNERS

Consultants:


CIVIL:
GLENN ENGINEERING CORP

STRUCTURAL:
SHW GROUP, LLP

MEP:
ESTES McCLURE &
ASSOCIATES, INC.
FOOD SERVICE:
JMK FOODSERVICE
CONSULTING & DESIGN, LLC

LANDSCAPING:
RAMSEY LANDSCAPE
ARCHITECTS, LLP

Final Plans for Bidding and Construction

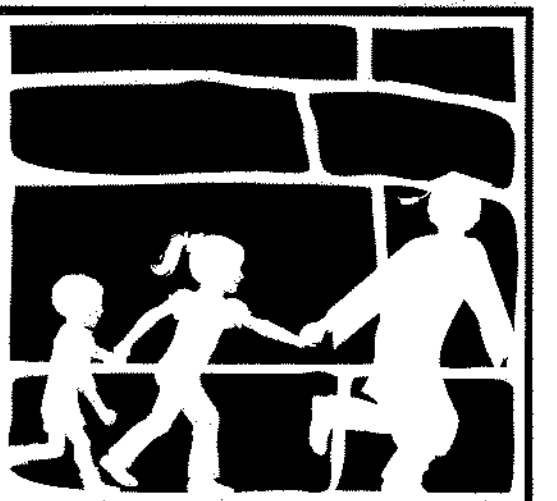

Rockwall
INDEPENDENT SCHOOL DISTRICT

**WILKERSON SANDERS
STADIUM RENOVATIONS
ROCKWALL, TEXAS**

Project Number: 4107.048.00
Drawing Date: 05/29/2008
Drawn:
Checked:
Scale:
ACAD File: 2008WILKERSON-SANDERS-REV8.dwg
© 2008 SHW Group, LLP



Revisions:

1	11/05/08	CITY REVISIONS
2	12/02/08	CITY REVISIONS #2
3	12/12/08	CITY REVISIONS #3
4	12/16/08	CITY REVISIONS #4
5	01/26/09	CITY REVISIONS #5
6	08/03/09	RECORD SET

Sheet Title:
**DRAINAGE
AREA
MAP**

CG 1.06

Aug 03, 2009 - 3:31pm User: Rick
\\robertpic-drive\ROCK\ISD\UTLE\2008 ADDITIONS\BID SET\2008 WILKERSON-SANDERS STADIUM\2008WILKERSON-SANDERS-REV8.dwg

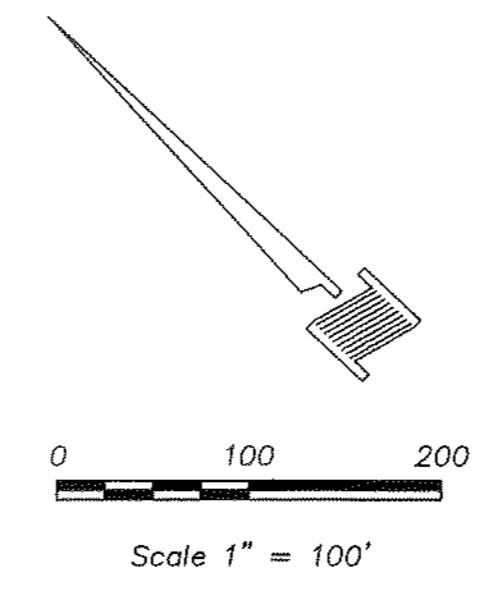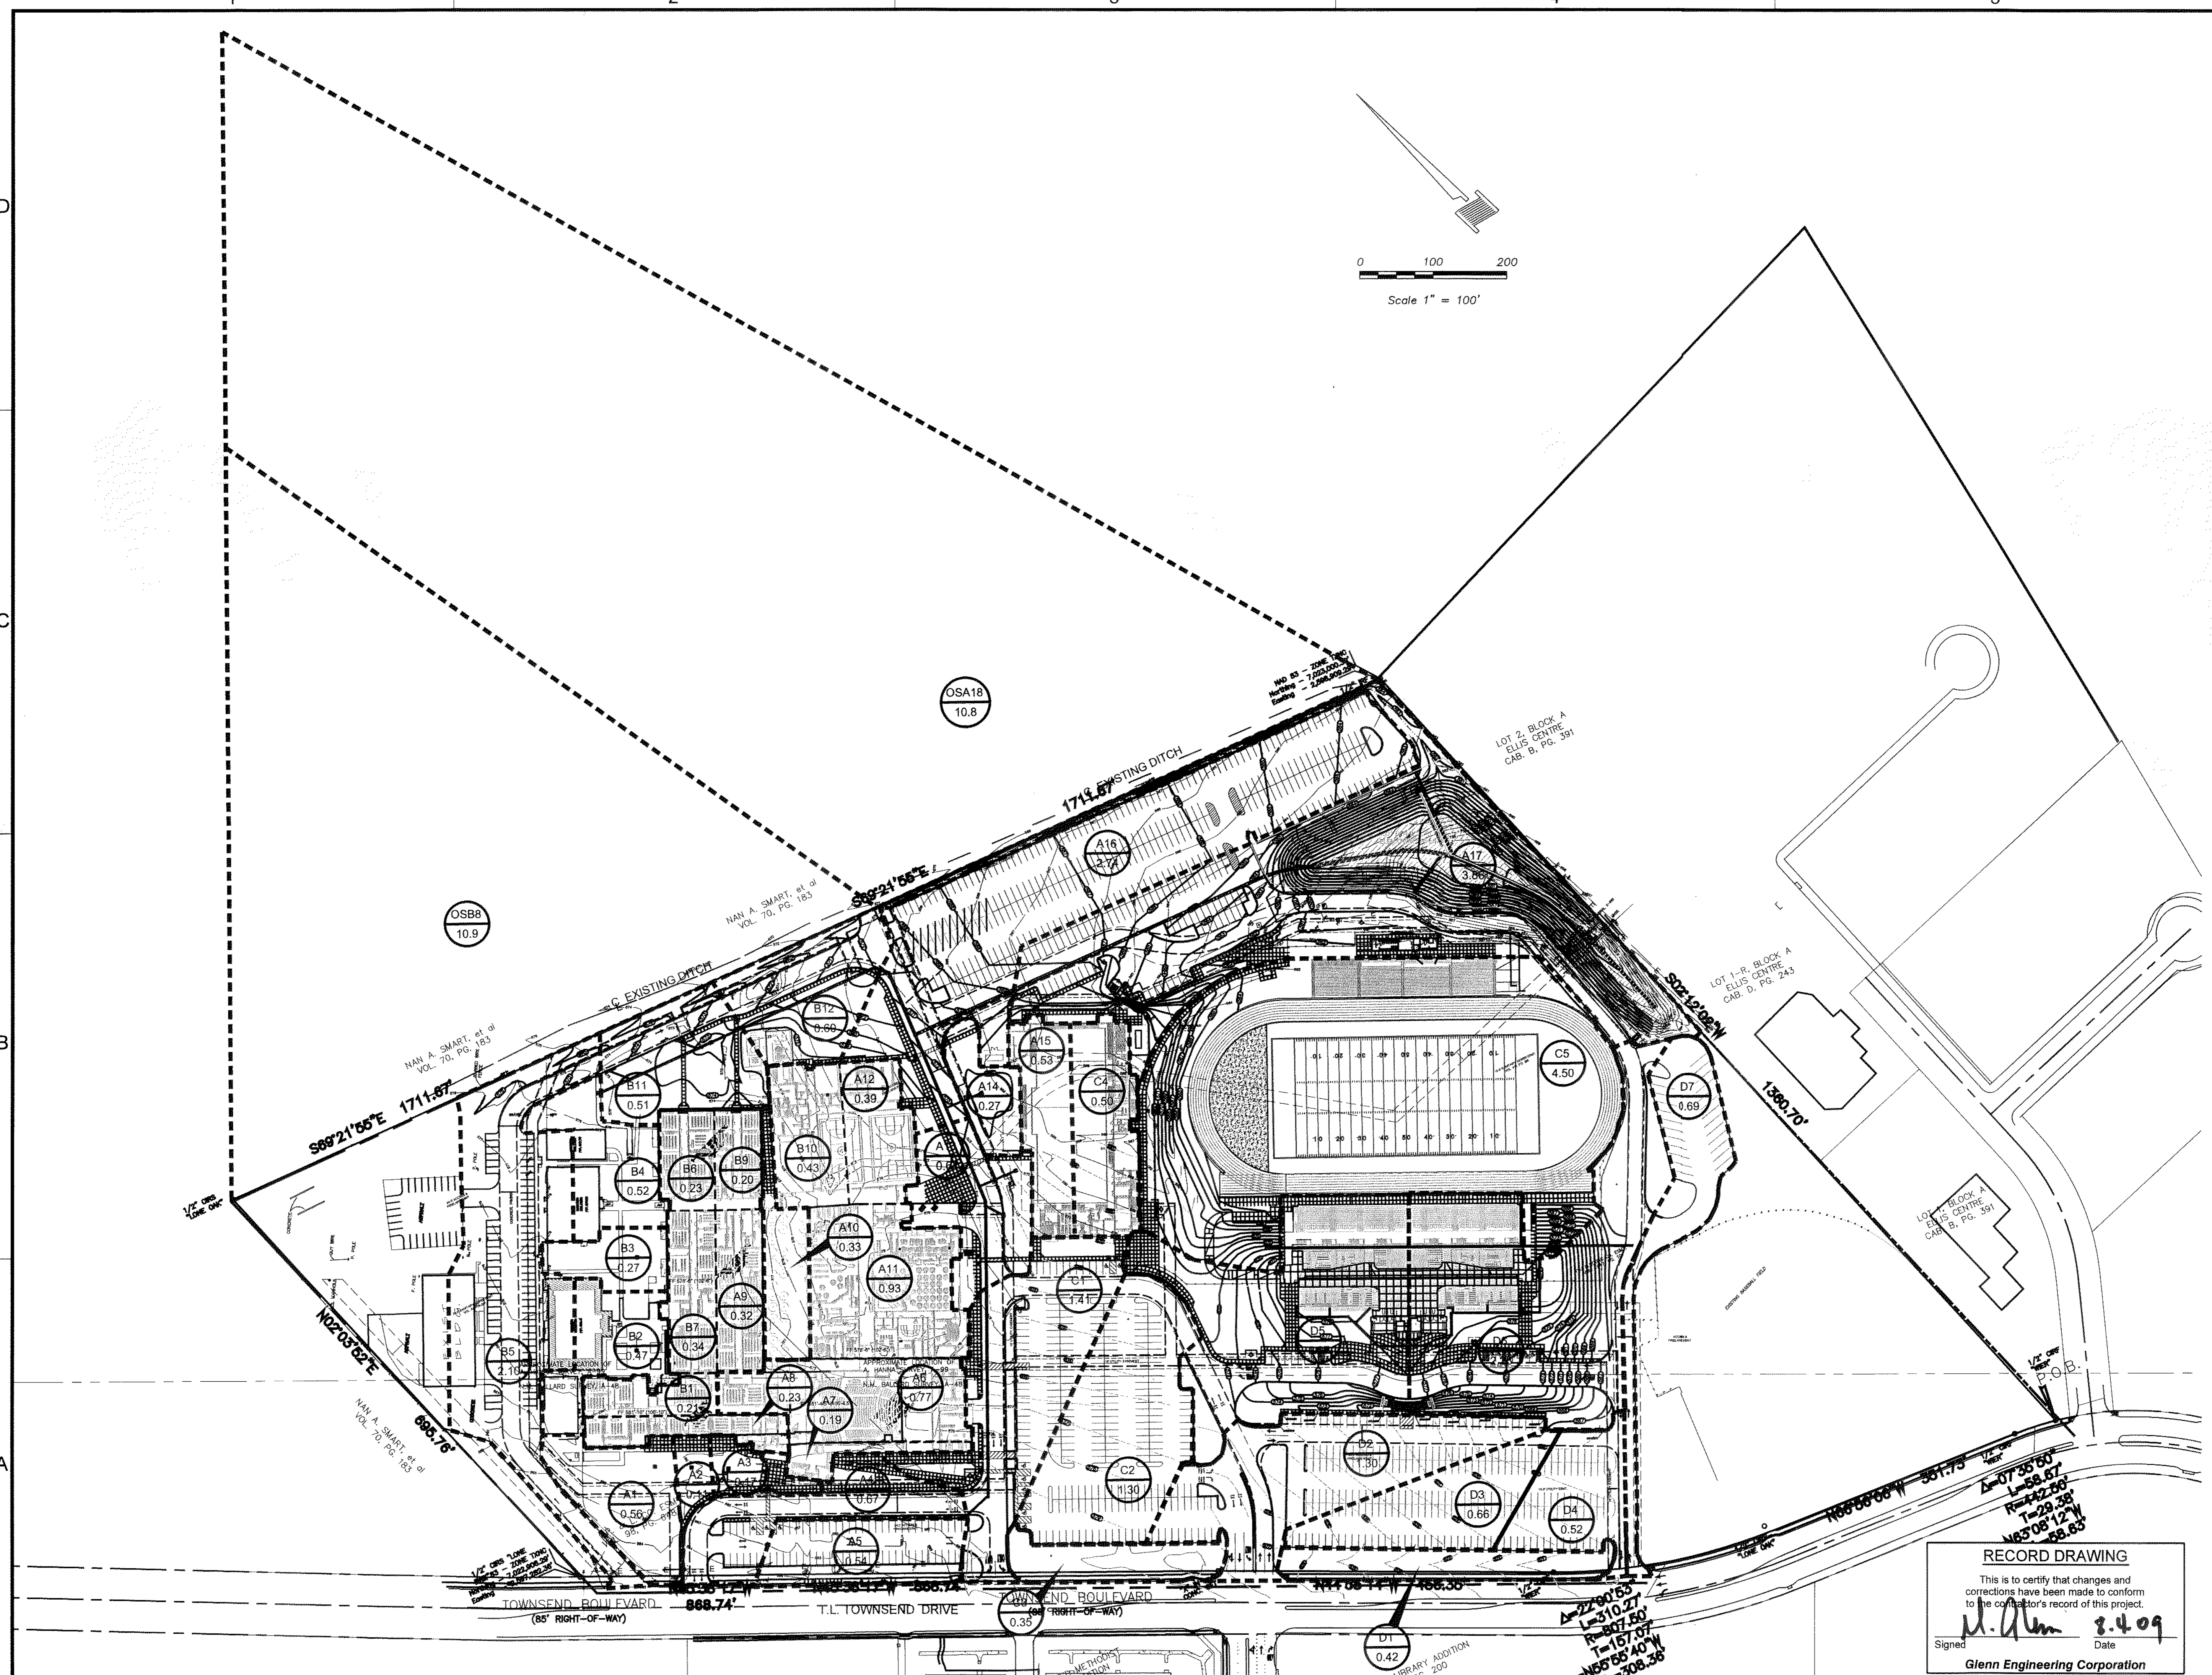

RECORD DRAWING
This is to certify that changes and corrections have been made to conform to the contractor's record of this project.
M. Glenn 8.4.09
Signed Date
Glenn Engineering Corporation