


1

2

3



4

5

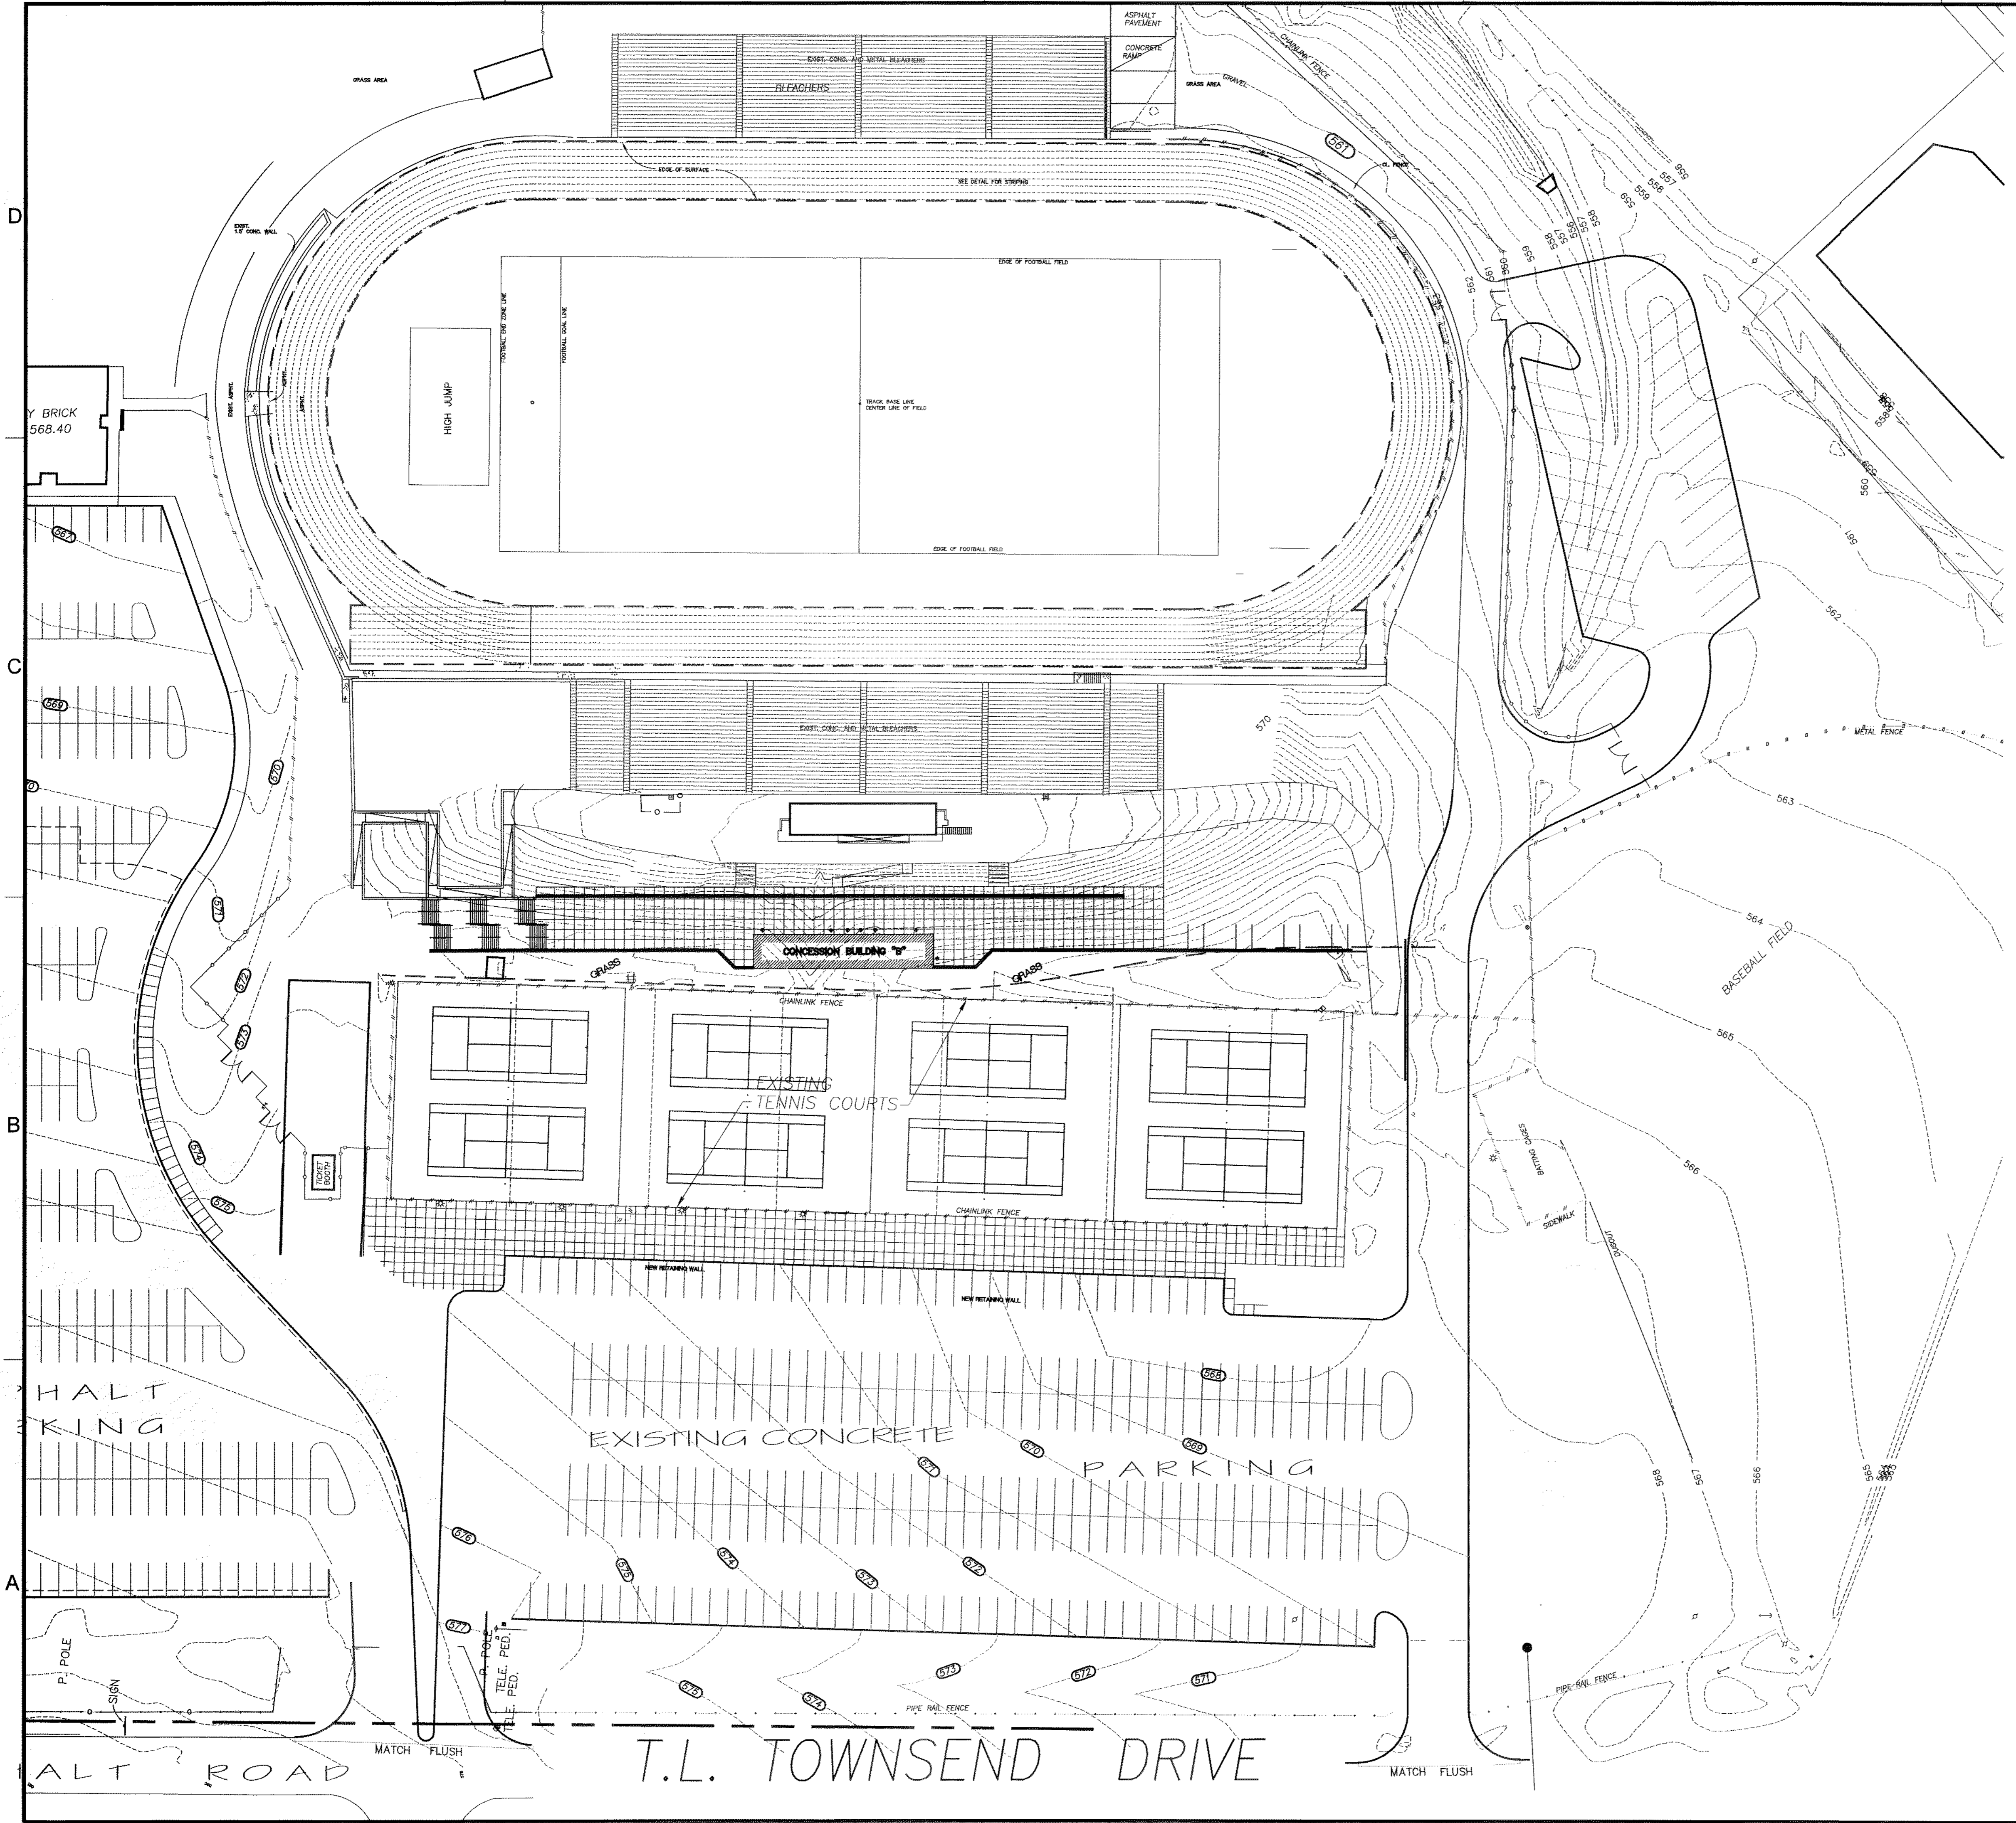

**NOTE**


UTILITIES HAVE BEEN PLOTTED FROM AVAILABLE MAPS AND RECORDS AND THEREFORE, THEIR LOCATIONS ARE APPROXIMATE ONLY. ELEVATIONS SHOWN ARE BASED ON FIELD MEASUREMENTS. THERE MAY BE OTHER UTILITIES, THE EXISTENCE OF WHICH ARE NOT KNOWN TO THE UNDERSIGNED. SIZE AND LOCATION OF ALL UNDERGROUND UTILITIES MUST BE VERIFIED PRIOR TO ANY CONSTRUCTION.

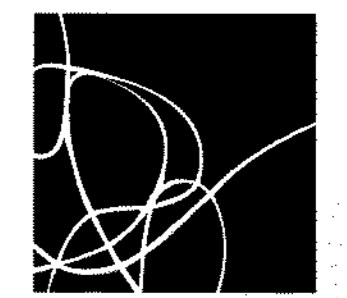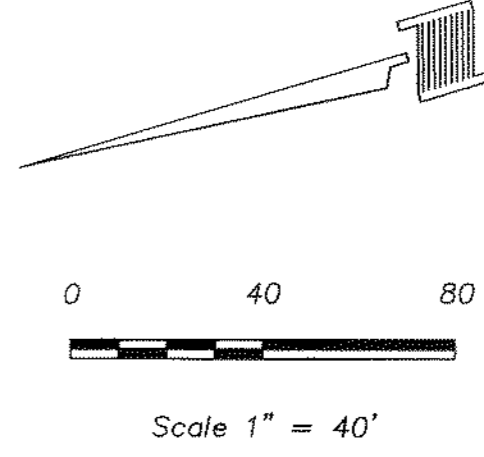

**SHW GROUP**  
ARCHITECTS | ENGINEERS | PLANNERS

- Consultants:
- CIVIL:  
GLENN ENGINEERING CORP
  - STRUCTURAL:  
SHW GROUP, LLP
  - MEP:  
ESTES McCCLURE &  
ASSOCIATES, INC.
  - FOOD SERVICE:  
JMK FOODSERVICE  
CONSULTING & DESIGN, LLC
  - LANDSCAPING:  
RAMSEY LANDSCAPE  
ARCHITECTS, LLP

Final Plans for Bidding and Construction

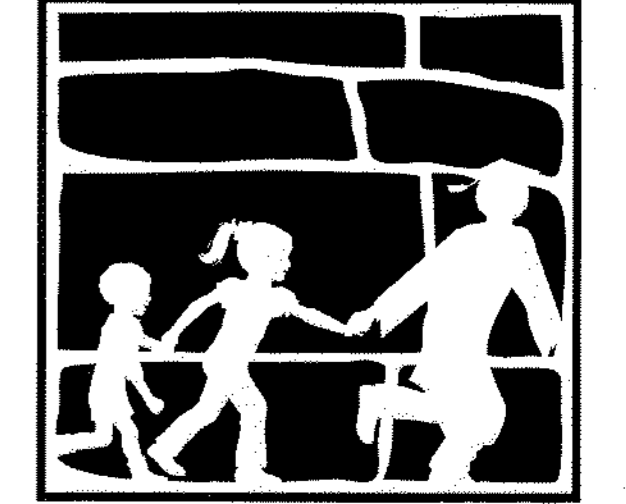

**Rockwall**  
INDEPENDENT SCHOOL DISTRICT  
**WILKERSON SANDERS**  
**STADIUM RENOVATIONS**  
**ROCKWALL, TEXAS**

Project Number: 4107.048.00  
Drawing Date: 05/29/2008  
Drawn:  
Checked:  
Scale:  
ACAD File: STADIUM-TOPO.dwg  
© 2008 SHW Group, LLP

Revisions:

1	11/05/08	CITY REVISIONS
2	12/02/08	CITY REVISIONS #2
3	12/12/08	CITY REVISIONS #3
4	12/16/08	CITY REVISIONS #4
5	01/26/09	CITY REVISIONS #5
6	08/03/09	RECORD SET

**RECORD DRAWING**

This is to certify that changes and corrections have been made to conform to the contractor's record of this project.

Signed: *U. Glenn* Date: *8-4-09*  
Glenn Engineering Corporation

Sheet Title:  
**SOUTH**  
**TOPOGRAPHIC**  
**SURVEY**

**V 1.02**

Aug 03, 2009 - 1:50pm User: Rick  
\\robertpc-drive\rock\SD\UTLEY\2008 ADDITIONS\BID SET\2008 WILKERSON-SANDERS STADIUM\STADIUM-TOPO.dwg