


# CONSTRUCTION PLANS FOR 2009 ADDITION AND RENOVATIONS ROCKWALL HIGH SCHOOL

901 YELLOW JACKET LANE  
ROCKWALL, ROCKWALL COUNTY, TEXAS 75032

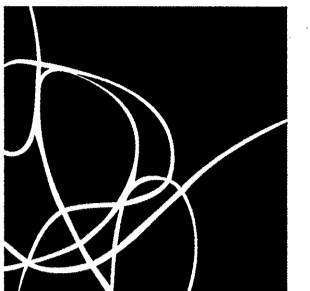

**SHW GROUP**  
ARCHITECTS | ENGINEERS | PLANNERS

CIVIL:  
GLENN ENGINEERING, INC.


STRUCTURAL:  
SHW GROUP LLP

MEP:  
ESTES, McCLURE & ASSOCIATES

LANDSCAPING:  
RAMSEY LANDSCAPE ARCHITECTS


FOOD SERVICE:  
JMK DESIGNS

FINAL PLANS FOR PERMITTING AND CONSTRUCTION

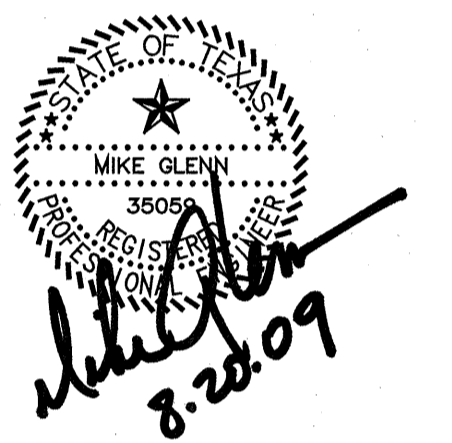

## TABLE OF CONTENTS

SHEET NO	TITLE
C 1.01	COVER SHEET
V 1.01	TOPOGRAPHIC SURVEY
CD 1.01	NORTH DEMOLITION PLAN
CD 1.02	SOUTH DEMOLITION PLAN
CD 1.03	NOT USED
CS 1.01	OVERALL SITE PLAN
CS 1.02	NORTH SITE PLAN
CS 1.03	SOUTH SITE PLAN
CS 1.04	NOT USED
CG 1.01	NORTH GRADING PLAN
CG 1.02	SOUTH GRADING PLAN
CG 1.03	FIRE LANE GRADING PLAN
CG 1.04	GRADING DETAIL - NORTH RAMPS
CG 1.05	GRADING DETAIL - EAST RAMPS
CG 1.06	NOT USED
CG 1.07	NORTH UNDERFLOOR GRADING
CG 1.08	SOUTH UNDERFLOOR GRADING
CG 1.09	NEW DRAINAGE AREA MAP
CG 1.10	EXISTING DRAINAGE AREA MAP
CG 1.11	SWPPP PLAN
CG 1.12	SWPPP DETAILS
CG 1.13	SWPPP DETAILS
CU 1.01	UTILITY PLAN
CU 1.02	NORTH STORM PLAN
CU 1.03	SOUTH STORM PLAN
CU 1.04	STORM DETAILS
CU 1.05	SANITARY DETAILS
CU 1.06	WATER DETAILS
CP 1.01	PAVING PLAN
CP 1.02	NOT USED
CP 1.03	PAVING DETAILS
CP 1.04	STAIR DETAILS
CR 1.01	RETAINING WALL DETAILS
CR 1.02	RETAINING WALL DETAILS
CT 1.01	TRACK PLAN
CT 1.02	TRACK DETAILS

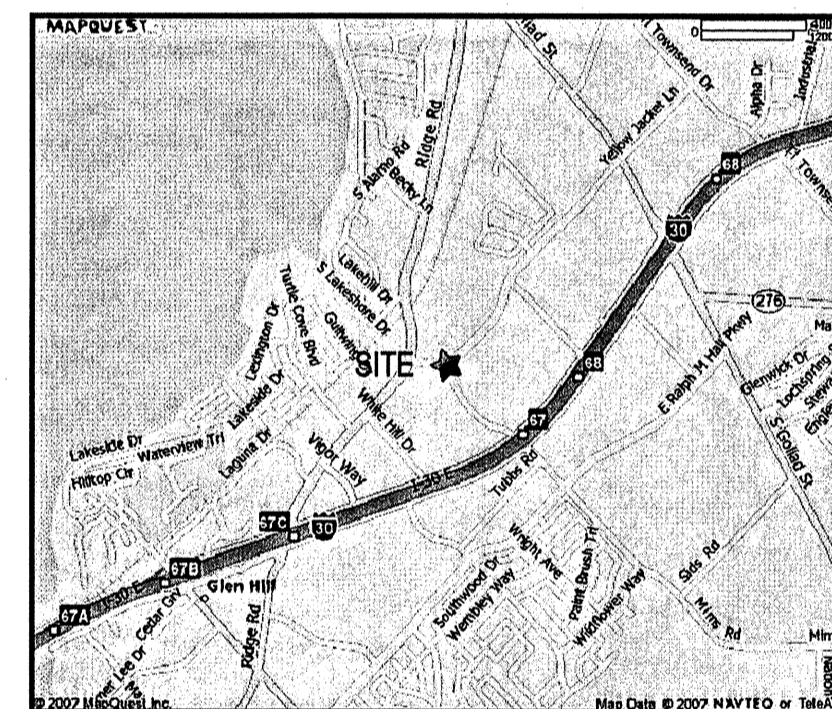

LOCATION MAP  
NTS

**GENERAL NOTE:**

CONTRACTOR TO UTILIZE CITY APPROVED CONSTRUCTION PLANS FOR CONSTRUCTION OF ALL CIVIL RELATED FACILITIES. CONTRACTOR TO NOTIFY ARCHITECT/ENGINEER IMMEDIATELY OF ANY COST DISCREPANCIES BETWEEN THE CITY APPROVED SET AND BID SET WITH LATEST ADDENDUMS.

### OWNER

ROCKWALL I.S.D.  
1050 WILLIAMS STREET  
ROCKWALL, TEXAS 75087  
972-771-0605

### ARCHITECT

SHW GROUP, INC.  
4000 McEWEN ROAD NORTH  
DALLAS, TEXAS 75244  
(972) 701-0700

### ENGINEER

GLENN ENGINEERING  
105 DECKER COURT, SUITE 910  
IRVING, TEXAS 75062  
(972) 717-5151

AUGUST 2009

**RECORD DRAWING**  
This is to certify that changes and corrections have been made to conform to the contractor's record of this project.  
Signed: *Glenn* Date: 8-22-09  
Glenn Engineering Corporation

CHECKED:

File:  
© 2008 SHW Group LLP

ISSUE: 5/27/2008

Revisions:

- 1 ADDENDA #1 - MARCH 17, 2008
- 2 ADDENDA #2 - MARCH 25, 2008
- 3 ADDENDA #3 - APRIL 1, 2008
- 4 CITY REVIEW COMMENTS - APRIL 22, 2008
- 5 CITY REVIEW COMMENTS - SEPT. 09, 2008
- 6 RECORD SET - MARCH 04, 2009
- 7 REVISED RECORD SET - JUNE 04, 2009

Sheet Title:  
**COVER SHEET**

**C 1.01**

SHW Project: 4107.049.00