


NOTE
 UTILITIES HAVE BEEN PLOTTED FROM AVAILABLE MAPS AND RECORDS AND THEREFORE THEIR LOCATIONS ARE APPROXIMATE ONLY. ELEVATIONS SHOWN ARE BASED ON FIELD MEASUREMENTS. THERE MAY BE OTHER UTILITIES, THE EXISTENCE OF WHICH ARE NOT KNOWN TO THE UNDERSIGNED. SIZE AND LOCATION OF ALL UNDERGROUND UTILITIES MUST BE VERIFIED PRIOR TO ANY CONSTRUCTION.

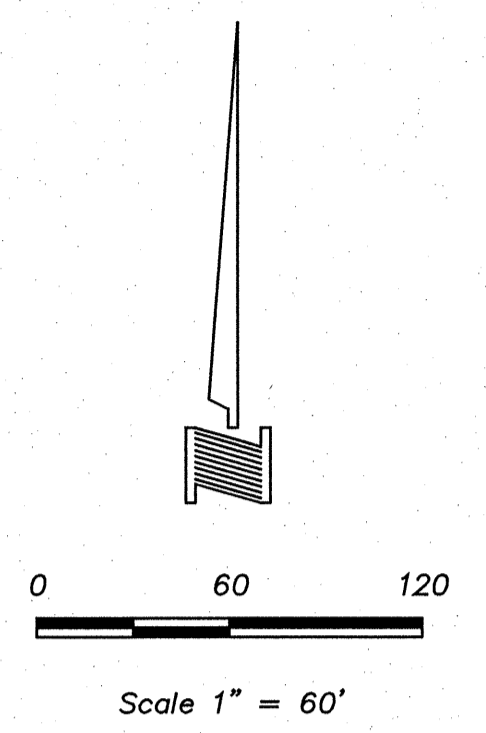

CIVIL:
GLENN ENGINEERING, INC.


STRUCTURAL:
SHW GROUP LLP

MEP:
ESTES, McCLURE & ASSOCIATES

LANDSCAPING:
RAMSEY LANDSCAPE ARCHITECTS

FOOD SERVICE:
JMK DESIGNS

FINAL PLANS FOR PERMITTING AND CONSTRUCTION

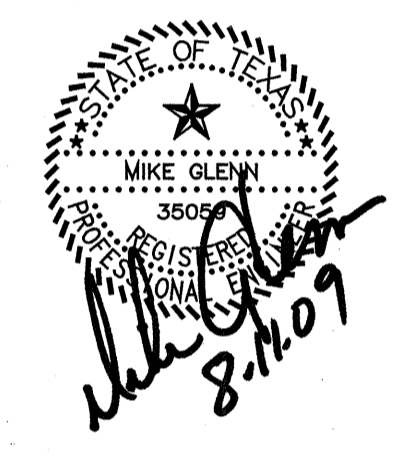

CHECKED:
File:
© 2008 SHW Group LLP

ISSUE: 5/27/2008

Revisions:

| | |
|---|---------------------------------------|
| 1 | ADDENDA #1 - MARCH 17, 2008 |
| 2 | ADDENDA #2 - MARCH 25, 2008 |
| 3 | ADDENDA #3 - APRIL 1, 2008 |
| 4 | CITY REVIEW COMMENTS - APRIL 22, 2008 |
| 5 | CITY REVIEW COMMENTS - SEPT. 09, 2008 |
| 6 | RECORD SET - MARCH 04, 2009 |
| 7 | REVISED RECORD SET - JUNE 04, 2009 |

RECORD DRAWING
 This is to certify that changes and corrections have been made to conform to the contractor's record of this project.
 Signed: *Mike Glenn* Date: 8.11.09
 Glenn Engineering Corporation

FOR INFORMATION ONLY

TOPOGRAPHIC SURVEY
 SCALE: 1"=60'

Sheet Title:
TOPOGRAPHIC SURVEY

V 1.01

Plotted: Aug 11, 2009, 1:31 PM by user: rick. Saved: 8/11/2009 by user: reagan
 \\robertphc-dive\rock\high-school\2007 ADDITIONS\ROCKWALL-HS-ADD-REV6.dwg