

SHWGROUP
ARCHITECTS | ENGINEERS | PLANNERS

CIVIL:
GLENN ENGINEERING, INC.


STRUCTURAL:
SHW GROUP LLP

MEP:
ESTES, McCLURE & ASSOCIATES


LANDSCAPING:
RAMSEY LANDSCAPE ARCHITECTS

FOOD SERVICE:
JMK DESIGNS

FINAL PLANS FOR PERMITTING AND CONSTRUCTION

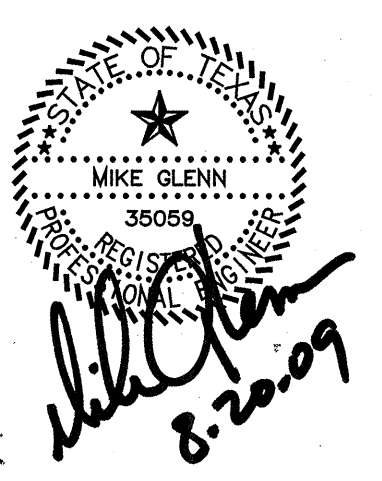

Rockwall ISD

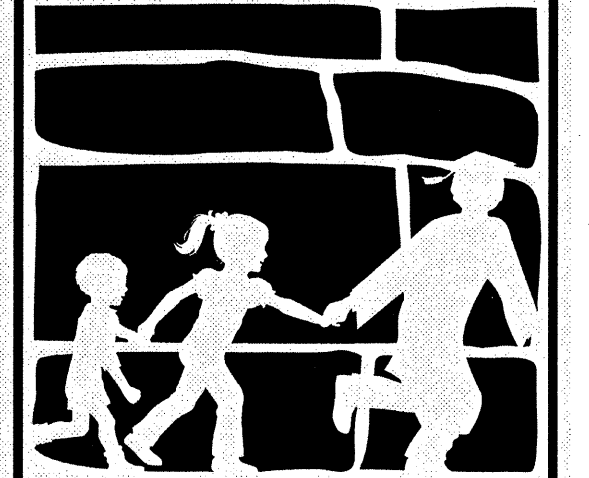

**ROCKWALL
HIGH SCHOOL
ROCKWALL, TEXAS**

CHECKED:
File:
© 2008 SHW Group LLP

ISSUE: 5/27/2008

Revisions:

1	ADDENDA #1 - MARCH 17, 2008
2	ADDENDA #2 - MARCH 25, 2008
3	ADDENDA #3 - APRIL 1, 2008
4	CITY REVIEW COMMENTS - APRIL 22, 2008
5	CITY REVIEW COMMENTS - SEPT. 09, 2008
6	RECORD SET - MARCH 04, 2009
7	REVISED RECORD SET - JUNE 04, 2009

Sheet Title:
**OVERALL
SITE
PLAN**

RECORD DRAWING
This is to certify that changes and corrections have been made to conform to the contractor's record of this project.
Signed: *[Signature]* Date: 8-20-09
Glenn Engineering Corporation

OVERALL SITE PLAN
SCALE: 1"=100'

CS 1.01
SHW Project: 4107.049.00

Plotted: Aug 20, 2009, 10:25 AM by user: reagan - Saved: 8/20/2009 by user: reagan
 W:\reagan\drive\rockwall\High-School\2007_ADDITION\ROCKWALL-HS-ADD-REV06.dwg