

**SHW GROUP**  
ARCHITECTS | ENGINEERS | PLANNERS

CIVIL:  
GLENN ENGINEERING, INC.

STRUCTURAL:  
SHW GROUP LLP

MEP:  
ESTES, McCLURE & ASSOCIATES

LANDSCAPING:  
RAMSEY LANDSCAPE ARCHITECTS

FOOD SERVICE:  
JMK DESIGNS

FINAL PLANS FOR PERMITTING AND CONSTRUCTION



**Rockwall ISD**



**ROCKWALL  
HIGH SCHOOL  
ROCKWALL, TEXAS**

CHECKED:

File:  
© 2008 SHW Group LLP




ISSUE: 5/27/2008

Revisions:

- 1 ADDENDA #1 - MARCH 17, 2008
- 2 ADDENDA #2 - MARCH 25, 2008
- 3 ADDENDA #3 - APRIL 1, 2008
- 4 CITY REVIEW COMMENTS - APRIL 22, 2008
- 5 CITY REVIEW COMMENTS - SEPT. 09, 2008
- 6 RECORD SET - MARCH 04, 2009
- 7 REVISED RECORD SET - JUNE 04, 2009

Sheet Title:

**FIRE LANE  
GRADING  
PLAN**

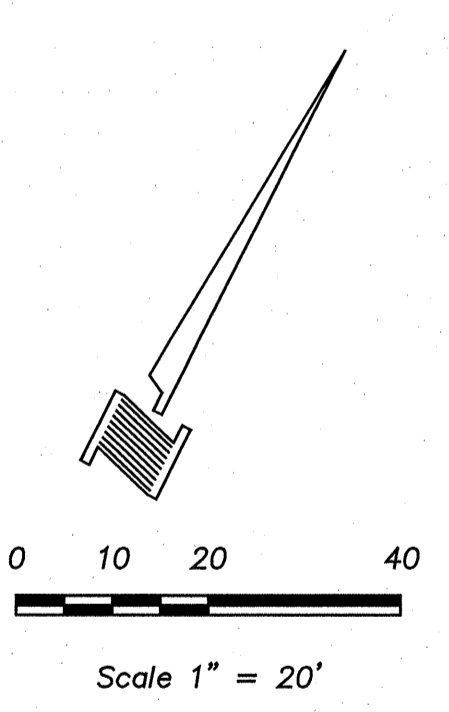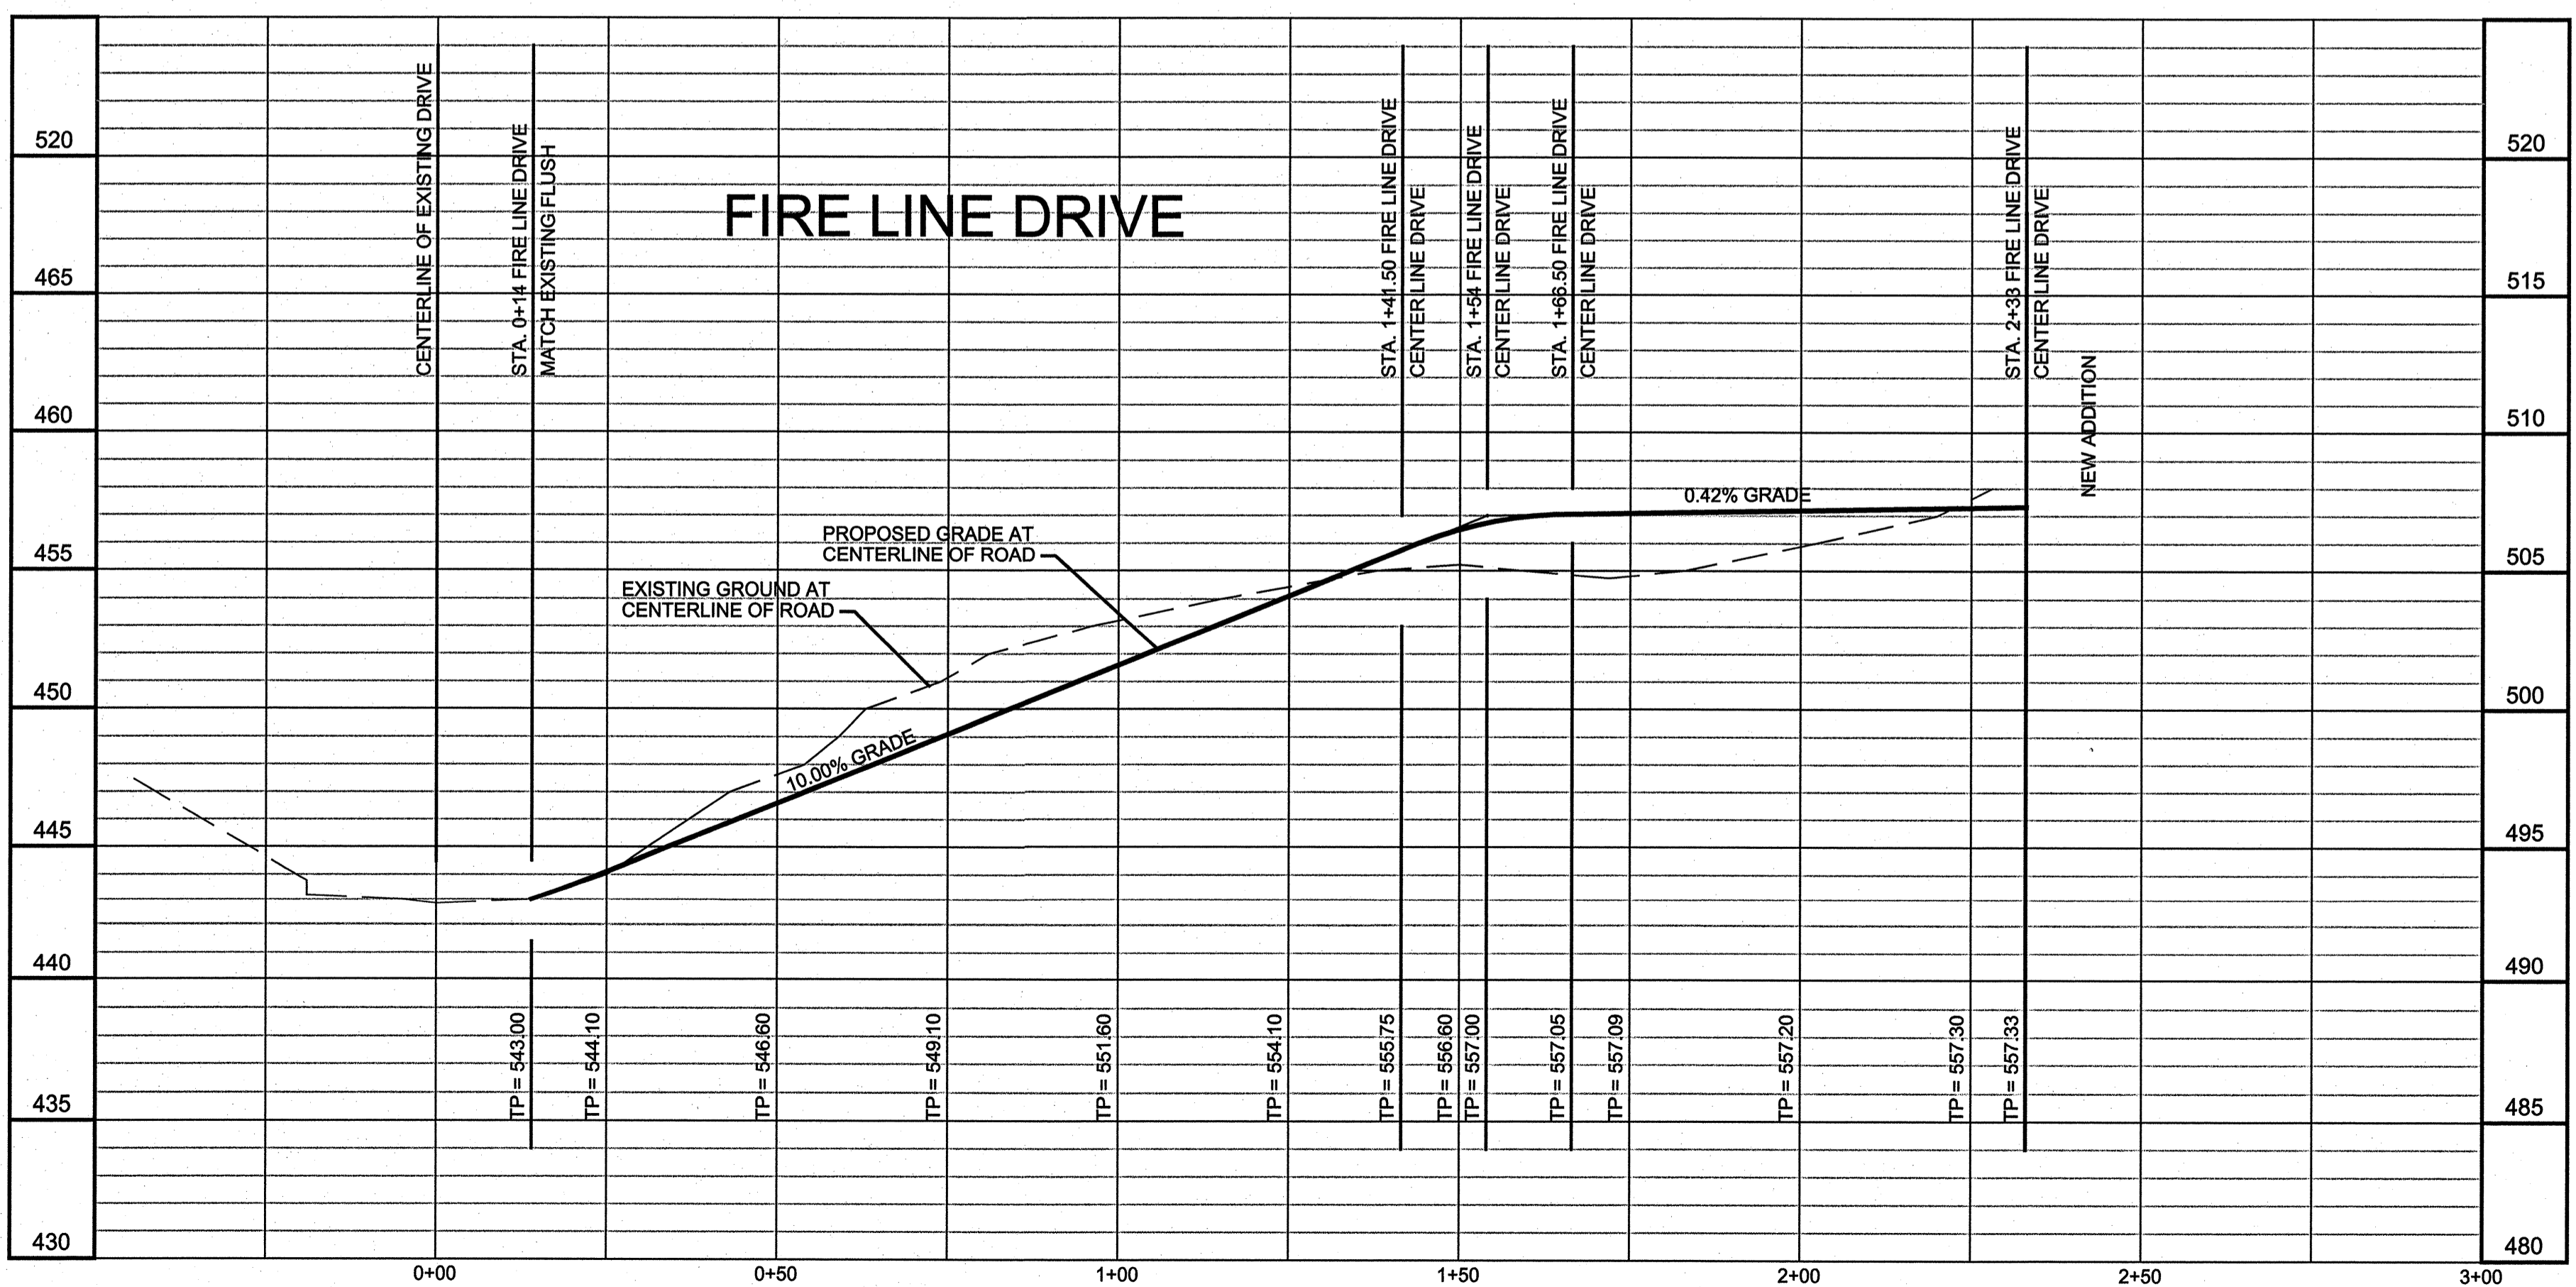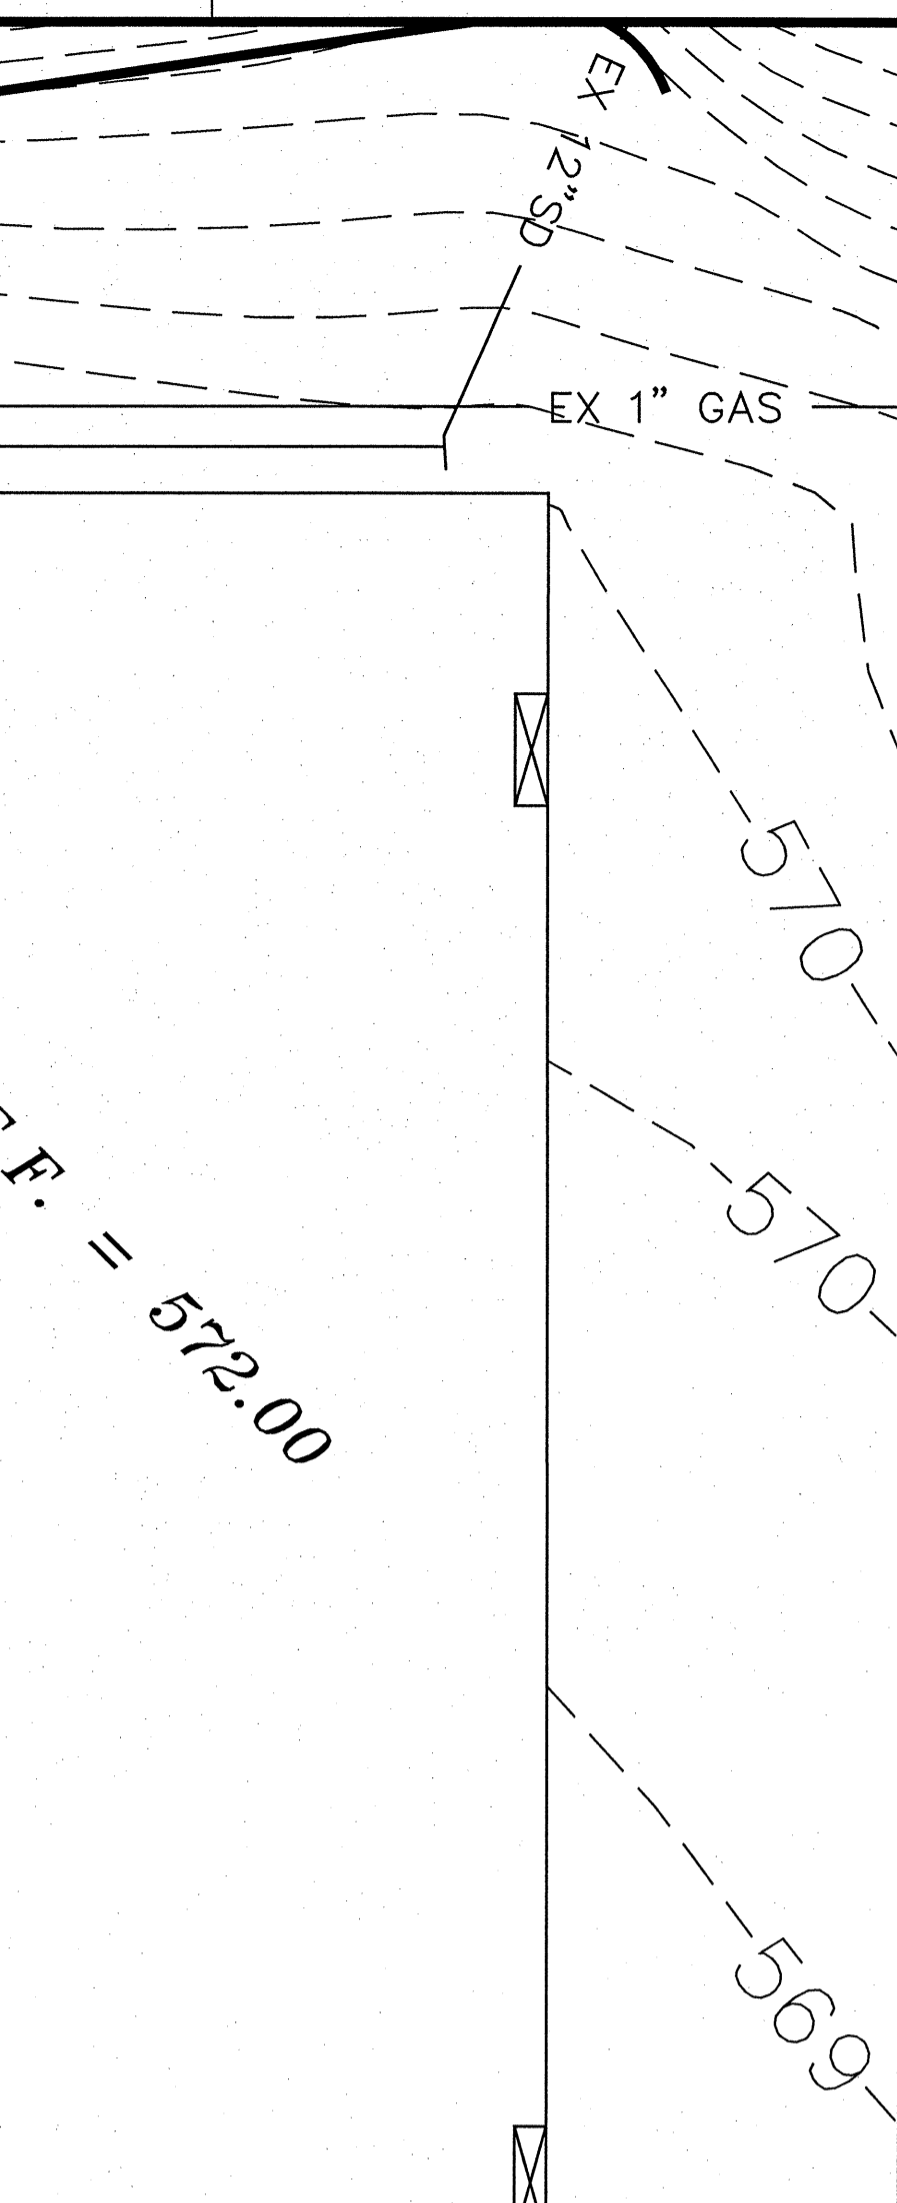

**RECORD DRAWING**

This is to certify that changes and corrections have been made to conform to the contractor's record of this project.

Signed *Mike Glenn* Date *8-11-09*  
Glenn Engineering Corporation

**FIRE LANE GRADING PLAN**  
SCALE: 1"=20'

**CG1.03**

SHW Project: 4107.049.00

Plotted: Aug 11, 2009, 1:38 PM by user: rick - Saved: 8/11/2009 by user: reagan  
\\laber\pplc-drive\rockwall-high-school\2007 ADDITIONS\ROCKWALL-HS-APP-REV6.dwg