



ARCHITECTS | ENGINEERS | PLANNERS

GLENN ENGINEERING, INC.

STRUCTURAL:

SHW GROUP LLP


ESTES, McCLURE & ASSOCIATES

LANDSCAPING: RAMSEY LANDSCAPE ARCHITECTS

FOOD SERVICE: JMK DESIGNS

FINAL PLANS FOR PERMITTING AND CONSTRUCTION



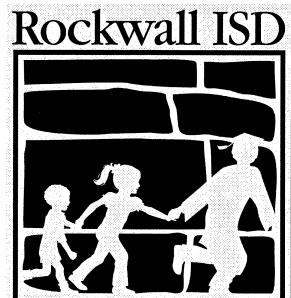

## **ROCKWALL HIGH SCHOOL ROCKWALL, TEXAS**

CHECKED:

© 2008 SHW Group LLP

-Revisions: -

1 ADDENDA #1 - MARCH 17, 2008

2 ADDENDA #2 - MARCH 25, 2008

3 ADDENDA #3 - APRIL 1, 2008

4 CITY REVIEW COMMENTS - APRIL 22, 2008 5 CITY REVIEW COMMENTS - SEPT. 09, 2008

6 RECORD SET - MARCH 04, 2009

REVISED RECORD SET - JUNE 04, 2009

UTILITY **PLAN** 

SHW Project: