


GENERAL STORM SEWER NOTES

- 1. All construction to be in accordance with these plans and City of Rockwall standards and specifications.
- 2. Prior to starting construction, the contractor shall make certain that all required permitsand approvals have been obtained. No construction or fabrication shall begin until the contractor has received and thoroughly reviewed all plans and other documents approved by all of the permitting authorities.
- 3. All work shall be performed in accordance with these plans and specifications

and the requirements and standards of the local governing authority.

- 4. In the event an item is not covered in the City of Rockwall specifications, the engineer's decision shall apply.
- 5. Barricading, traffic control, and project signs shall conform to "state department of highways and public transportation barricading and construction standards".
- 6. The general contractor and all sub-contractors shall verify the suitability of all existing and proposed site conditions including grades and dimensions before commencement of any construction. In the event of any conflict and prior to commencement of any construction, immediately notify engineer. Minor adjustments of finish grade to accomplish spot drainage are acceptable, if necessary, upon prior approval of engineer. Paving installed shall 'flush out' at any juncture with existing paving.
- 7. The locations of underground utilities shown on this plan are based on field surveys and local utility company records. It shall be the contractor's full responsibility to contact the various utility companies to locate their utilities prior
- 8. Contractor shall verify all existing inverts, rim elevations and sizes prior to con-
- 9. All PVC pipe shall be SCH 40 or approved equal.
- 10. All RCP shall be class III.
- 11. All storm sewer in public areas will be constructed to City of Rockwall standards.

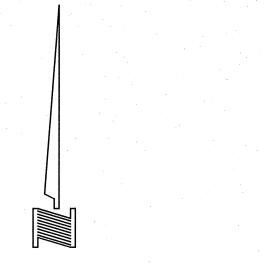

RECORD DRAWING

Glenn Engineering Corporation

SOUTH STORM PLAN

SCALE: 1"=30'

This is to certify that changes and prections have been made to conform

Scale 1" = 30



GLENN ENGINEERING, INC.

STRUCTURAL: SHW GROUP LLP


ESTES, McCLURE & ASSOCIATES

LANDSCAPING: RAMSEY LANDSCAPE ARCHITECTS

FOOD SERVICE: JMK DESIGNS

FINAL PLANS FOR PERMITTING AND CONSTRUCTION



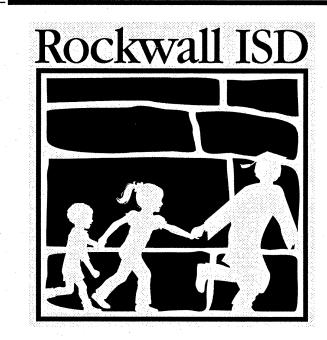

ROCKWALL HIGH SCHOOL ROCKWALL, TEXAS

CHECKED:

© 2008 SHW Group LLP

- 1 ADDENDA #1 MARCH 17, 2008
- 2 ADDENDA #2 MARCH 25, 2008 3 ADDENDA #3 - APRIL 1, 2008
- 4 CITY REVIEW COMMENTS APRIL 22, 2008

5 CITY REVIEW COMMENTS - SEPT. 09, 2008 6 RECORD SET - MARCH 04, 2009

7 REVISED RECORD SET - JUNE 04, 2009

Sheet Title: SOUTH **STORM PLAN**

SHW Project: