
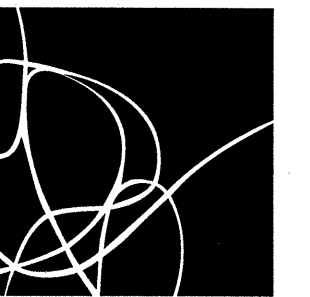
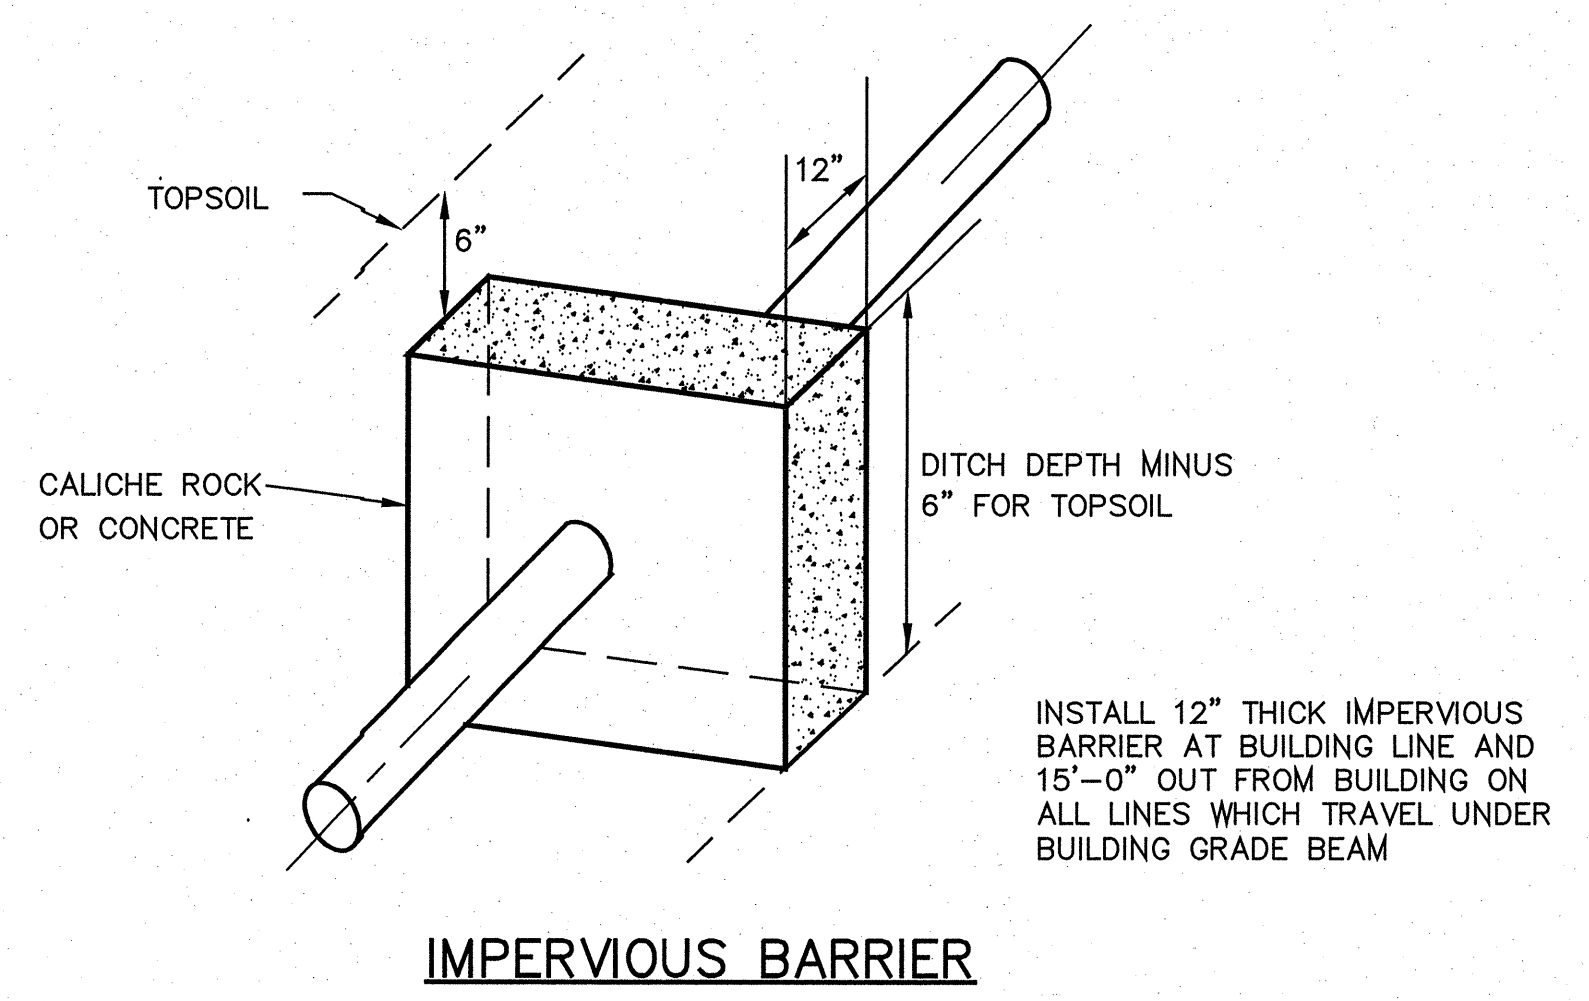


INSTALL: 4- 6" D.I. GUARD POST ANCHORED AND FILLED WITH CONCRETE SPACED 5' -0" APART (EQUAL DISTANCE FROM THE FIRE HYDRANT) MINIMUM HEIGHT EQUAL TO FIRE HYDRANT.

POST TO BE A MINIMUM OF 3' BELOW FINISHED PAVEMENT GRADE.


POST SHALL BE PAINTED YELLOW.

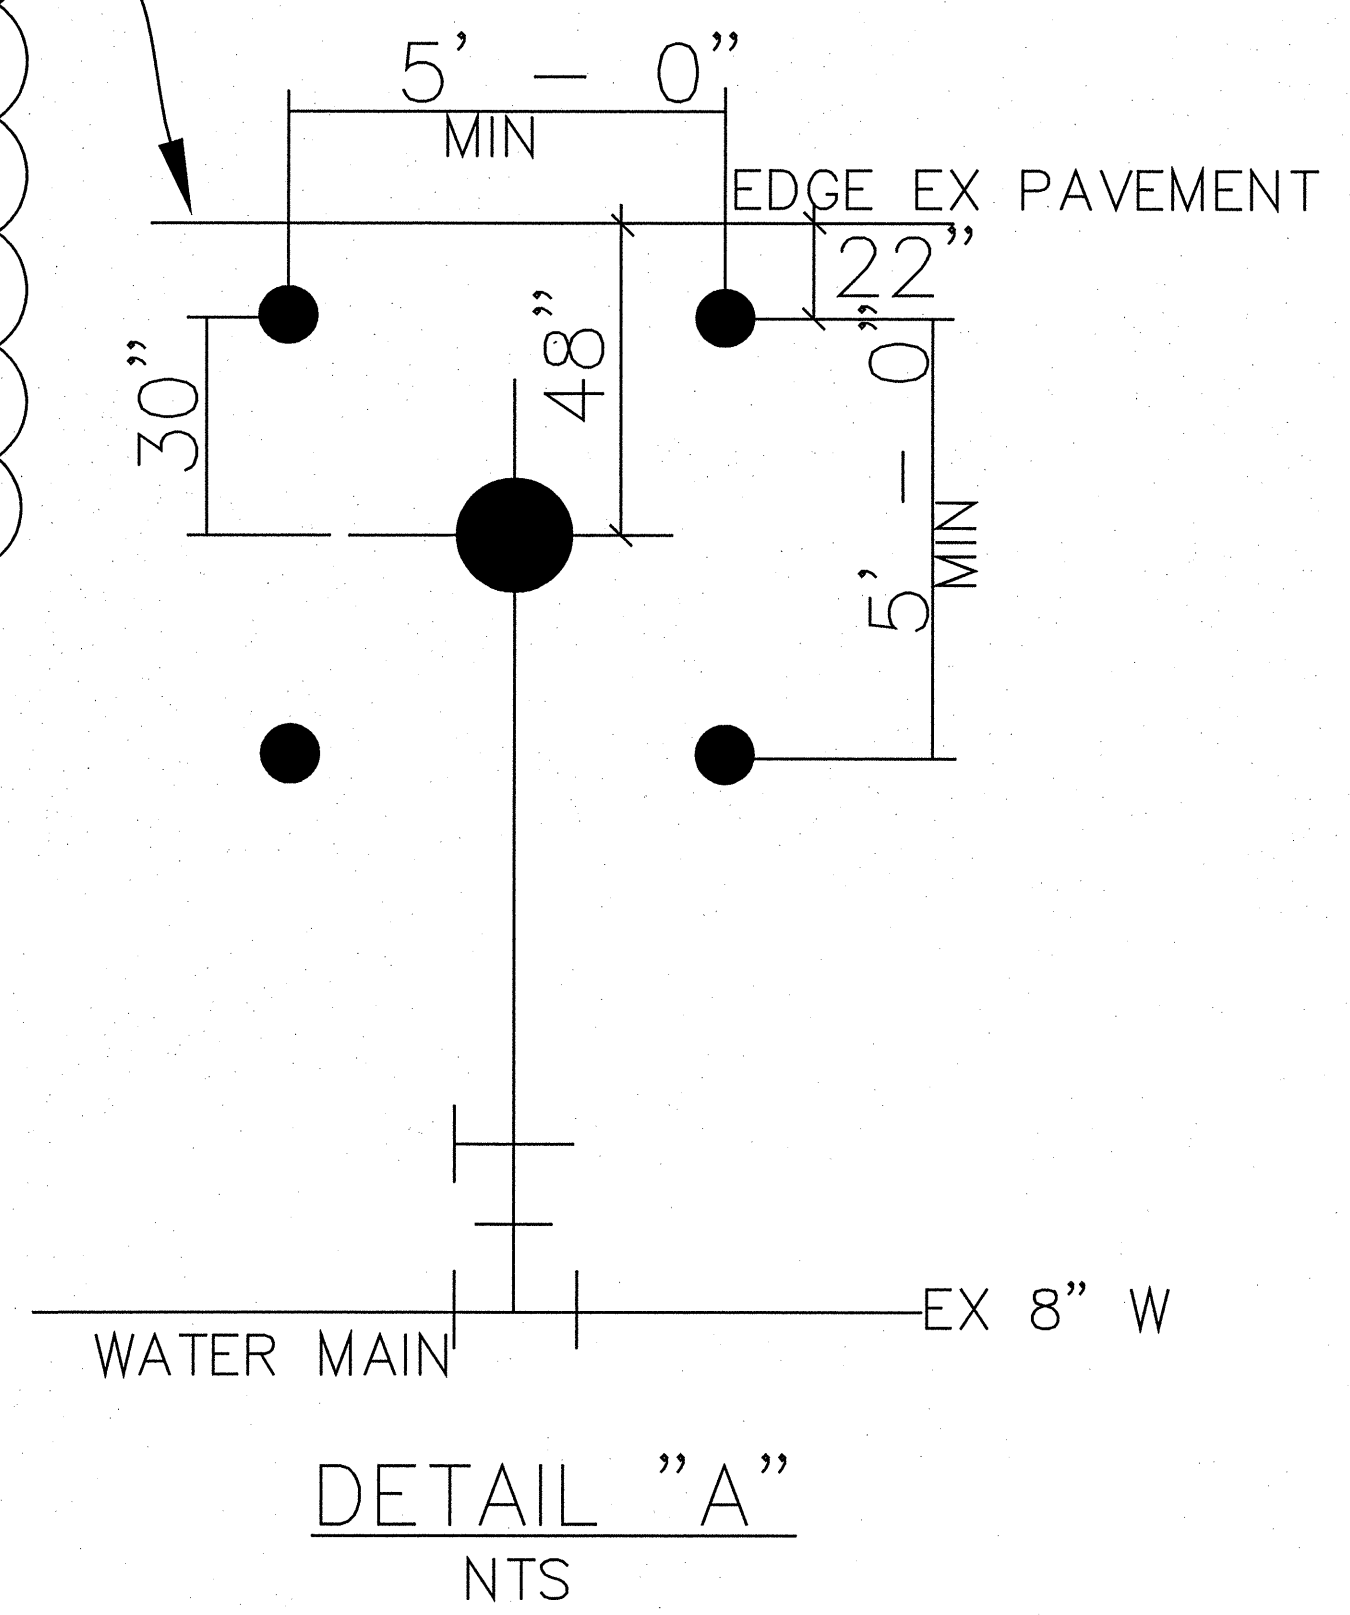


**SHWGROUP**  
ARCHITECTS | ENGINEERS | PLANNERS

- CIVIL:  
GLENN ENGINEERING, INC.
- STRUCTURAL:  
SHW GROUP LLP
- MEP:  
ESTES, McCLURE & ASSOCIATES
- LANDSCAPING:  
RAMSEY LANDSCAPE ARCHITECTS
- FOOD SERVICE:  
JMK DESIGNS

FINAL PLANS FOR PERMITTING AND CONSTRUCTION

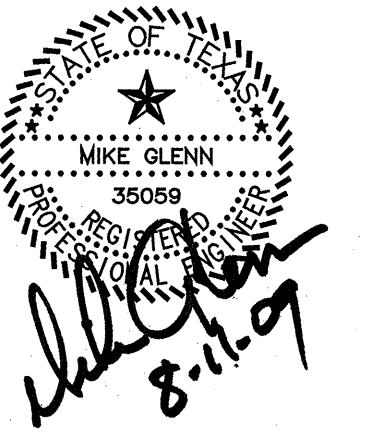

**Rockwall ISD**

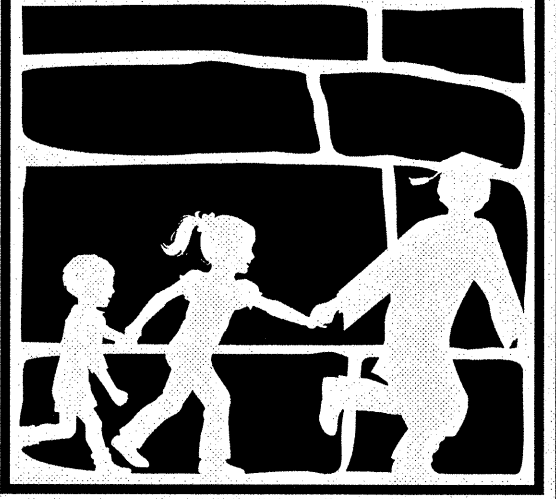

**ROCKWALL  
HIGH SCHOOL  
ROCKWALL, TEXAS**

CHECKED:  
File:  
© 2008 SHW Group LLP  
ISSUE: 5/27/2008

Revisions:

1	ADDENDA #1 - MARCH 17, 2008
2	ADDENDA #2 - MARCH 25, 2008
3	ADDENDA #3 - APRIL 1, 2008
4	CITY REVIEW COMMENTS - APRIL 22, 2008
5	CITY REVIEW COMMENTS - SEPT. 09, 2008
6	RECORD SET - MARCH 04, 2009
7	REVISED RECORD SET - JUNE 04, 2009

**RECORD DRAWING**  
This is to certify that changes and corrections have been made to conform to the contractor's record of this project.  
Signed: *M. Glenn* Date: 8-11-09  
Glenn Engineering Corporation

**WATER DETAILS**  
SCALE: AS SHOWN

Sheet Title:  
**WATER  
DETAILS**

**CU1.06**  
SHW Project: 4107.049.00

Plotted: Aug 11, 2009, 1:42 PM by user: rick - Saved: 8/11/2009 by user: rick  
\\robertpic-dm\cadd\rockwall\high-school\2007\ADDENDAS\ROCKWALL-HS-APP-REV16.dwg