


1

2

3

4

5

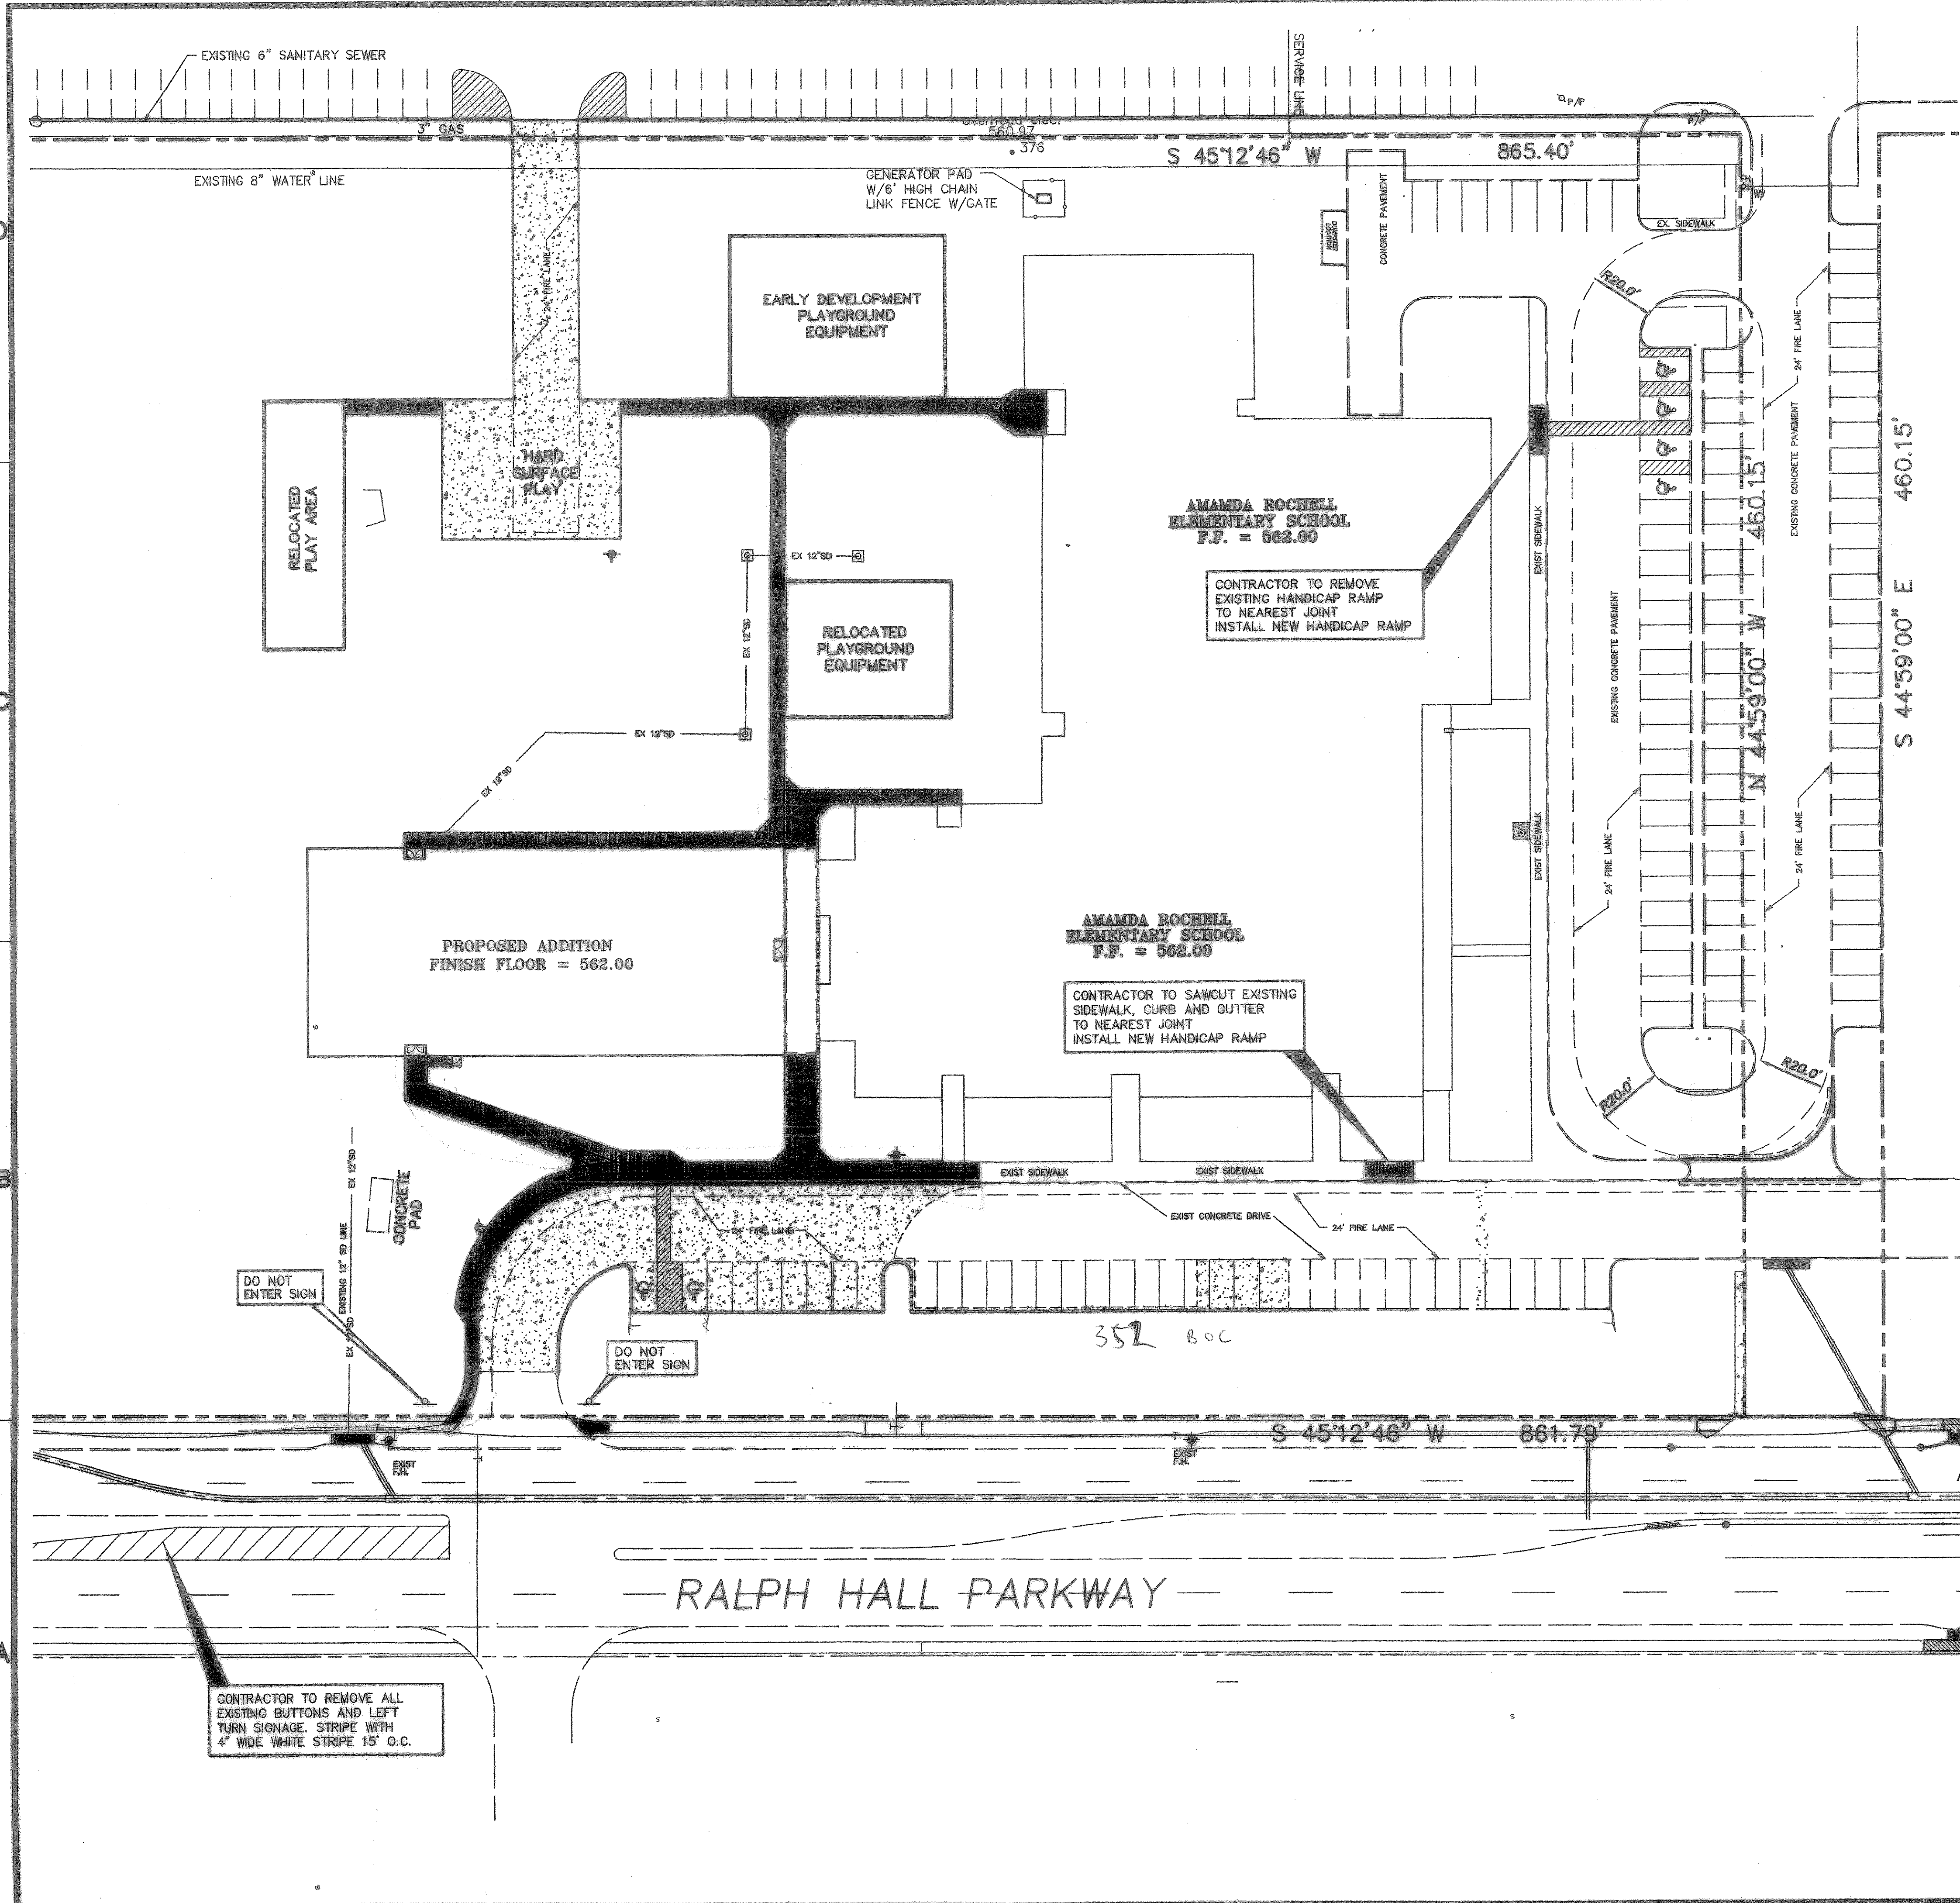

**PAVING NOTES**  
 \* IT IS THE CONTRACTOR'S RESPONSIBILITY TO CONSTRUCT ALL PAVING PER THE DIRECTION OF THE SOILS REPORT. CONTACT CIVIL ENGINEER ON ANY CONFLICTS BETWEEN THIS SHEET AND THE SOILS REPORT.

I. Pavement sub grade for A & B, below:  
 The clay soils encountered near the existing ground surface will probably constitute the sub-grade for most of the parking and drive areas. Therefore, it is recommended that these soils be improved prior to construction of the pavements.  
 It is recommended that the existing clay soils in drive and parking areas be excavated to achieve final sub-grade elevation. The exposed surface of the clay should be scarified to a depth of at least 6 inches and mixed with an estimated 7 percent of hydrated lime (by dry unit weight) in conformance with Texas Highway Department Item 200. Assuming an in-place unit weight of 100 pcf for the pavement sub-grade soils, this percentage of lime equates to about 32 lbs of lime per sq yard of sub-grade treated. The actual amount of lime required should be determined by additional laboratory tests. It is recommended that the lime stabilization procedures extend at least 4 ft beyond the edge of the pavement to minimize the effects of seasonal shrinkage upon the extreme edges of pavement. The soil-lime mixture should then be compacted to at least 95 percent of standard proctor maximum dry density (ASTM D698) within 5 percentage points of the optimum moisture content. In all areas where hydrated lime is used to stabilize the sub-grade soils, routine atterberg-limit tests should be performed to ensure that the resulting plasticity index of the soil-lime mixture is at or below 15.

The client should be aware that mechanical lime stabilization of the pavement sub-grade soils will not prevent deep seated movement of the underlying untreated materials. Future maintenance of pavements should be expected over the life of the structure.

II. Paving  
 A. Concrete driveways  
 Sub grade shall be as indicated in section I.  
 Concrete driveway approaches shall be a minimum of 6 inches thick. Concrete driveway approaches shall have a rise of not less than 6 inches nor more than 9 inches from the final line of the gutter to a point 10 feet behind the face of the gutter. Concrete for driveways shall be a minimum of 3,600 psi in 28 days concrete with 4-6 percent entrained air. The grade below the driveway, including 4 feet outside of the outer edge of the driveway shall be compacted to 95% standard proctor density, and as indicated in the "pavement sub-grade notes". Driveways shall have a bedding of 2 inches compacted. Driveways shall have construction joints not more than 15 feet, apart, both transversely and longitudinally one-half inch expansion joint shall be placed on the property lines between the approach and the driveway. The joints shall be filled with premolded grey bituminous expansion joint filler and shall extend the entire depth and length of the concrete sections.  
 Finishing shall be as indicated in section III.

Note: No concrete shall be placed for driveways until the sub-grade, reinforcement placement has been inspected and approved by the city or state (whichever is applicable).

B. Parking lots  
 Parking lot sub-grade shall be as indicated in Section I.  
 Paving shall be 6" reinforced concrete in light traffic areas and 6" reinforced concrete in heavy traffic areas 3,600 psi in 28 days concrete with 4-5% entrained air reinforced with #3 bars at 24" O.C.E.W. supported with proper support chairs. Expansion joints shall be at 60' maximum O.C. and sawcut construction joints at maximum 15' O.C.. All joints to be cleaned and filled with hot poured rubber (gray).  
 Finishing shall be as indicated in section III.


C. On-site sidewalks  
 Concrete sidewalks shall be a width as designated on site plan and a minimum of 4 inches thick, constructed of 3,600 psi, in 28 days concrete with 4-6% entrained air and reinforced with #3 bars at 24" O.C.E.W. supported with proper support chairs. Expansion joints shall be at 60' maximum O.C. and sawcut construction joints at maximum 15' O.C.. All joints to be cleaned and filled with hot poured rubber (gray) with #3 bars at 18" O.C.E.W. Tooled construction joints shall be 5'-0" O.C. one-half inch expansion joint shall be placed every 40 feet and where any work is constructed adjacent to other concrete work (walls, foundation, curbs, etc.). The joints shall be filled with 1/2-inch pre molded grey bituminous expansion joint filler and shall extend the entire depth and width of the concrete section.  
 Finish of sidewalks shall be with a broom finish per engineer. Walks shall have tooled curb edges & tooled joints.  
 Walks shall have tooled curb edges & tooled joints.

III. Finishing for concrete driveway, parking lot and street curbs  
 The exposed surface of driveways and parking lot shall have a monolithic finish by floating with a wooden float until a slight excess of sand appears on the surface. In no case shall the surface be left slick or with a glossy finish. Exposed surfaces of sidewalks shall have a monolithic finish by troweling with a steel trowel and brushed lightly with an approved broom. The edge of all concrete shall be neatly rounded to the required radii with an edging tool.  
 The exposed surface of curbs and curbs with gutter shall be shaped with a "mule" and brushed with a wet brush at right angle to the line of the curb to produce a uniform textured surface. The edges shall be neatly rounded off to the required radii. Use of grout over a rough finished texture will not be allowed.

**SHW Group, LLP**  
 Architects + Engineers + Planners

Consultants:  
 CIVIL:  
 GLENN ENGINEERING CORP.  
 STRUCTURAL:  
 SHW GROUP, LLP  
 MEP:  
 ESTES MCCLURE AND ASSOCIATES  
 LANDSCAPING:  
 GRUBBS RAMSEY

Final Plans for Bidding and Construction

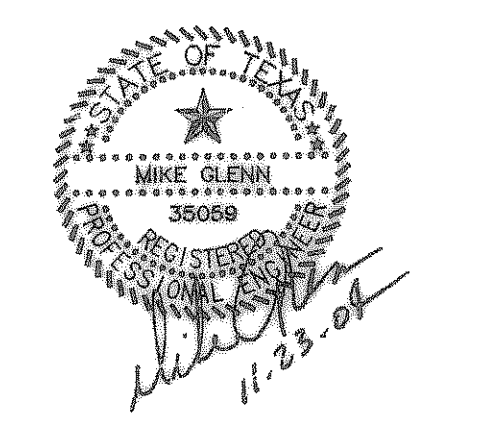

**Rockwall Independent School District**

**AMANDA ROCHELL ELEMENTARY ADDITIONS AND RENOVATIONS**

**ROCKWALL, TEXAS**

Project Number: 1441.04.01E  
 Drawing Date: 08/31/2004  
 Drawn: R.HOWMAN  
 Checked: RAI  
 Scale: AS SHOWN  
 ACAD File: ROCHELLE-ENG-ADD1-REV2 © 2004 SHW Group, LLP

Revisions:  
 1 10/12/2004 CITY COMMENTS  
 2 11/8/2004 CITY COMMENTS  
 3 11/23/2004 CITY COMMENTS

Sheet Title:  
**PAVING PLAN**

These Drawings have been modified to conform to the Construction Records.  
 Glenn Engineering Corporation  
 By: [Signature] Date: 2-23-06

**PAVING LEGEND**

	PROPOSED 6" REINFORCED CONCRETE PAVEMENT (CLASS C) 3,600 P.S.I. CONCRETE 6 1/2 SACK HAND FINISH 6 SACK MACHINE FINISH WITH #3 REBARS ON 24" CENTERS EACH WAY. (NO SAND UNDER PAVING)
	PROPOSED 4" REINFORCED CONCRETE SIDEWALK WITH #3 REBARS ON 24" CENTERS EACH WAY
NOTE: HAND POURED CONCRETE SHALL BE 3600 PSI (6 1/2 SACK) MACHINE POURED CONCRETE SHALL BE 3600 PSI (6 SACK)	

**PAVING PLAN**  
 SCALE: 1" = 30'

**GLENN ENGINEERING**  
 PHONE 972-717-5151 FAX 972-717-2176  
 105 DECKER COURT - SUITE 910 IRVING, TEXAS 75062

**CP 1.01**

Nov 23, 2004 9:22am User: Rick  
 \\Robert--xp\C-DRIVE\ROCK\SD\Rockel\BID-SET\ADDITION\BIDSET\ROCHELLE-ENG-ADD1-REV2.dwg  
 \\Robert--xp\C-DRIVE\ROCK\SD\Rockel\BID-SET\ADDITION\BIDSET\ROCHELLE-ENG-ADD1-REV2.dwg 11/23/2004 9:22:27 AM, Rick