


DATE MAY 18, 2001
 DRAWN BY JTY
 CHECKED RAH
 CDW NO 14411-01-017
 REVISION

ROCKWALL ELEMENTARY #9
ROCKWALL INDEPENDENT SCHOOL DISTRICT
ROCKWALL, TEXAS

FINAL PLANS FOR BIDDING AND CONSTRUCTION

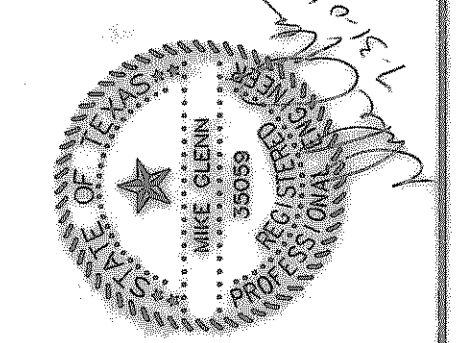

SHW Group Inc.
 Architects + Engineers

SHEET NUMBER C
 21 OF 22
2.24
 SET NUMBER

These Drawings have been modified to conform to the Construction Records.
 Glenn Engineering Corporation
 By *[Signature]* Date: 2-22-04

RETAINING WALL DETAILS
 N.T.S.