


DATE MAY 18, 2001  
DRAWN BY R. HOWMAN  
CHECKED RAH  
COMP NO 1441-01-017  
REVISED

**ROCKWALL ELEMENTARY #9**  
ROCKWALL INDEPENDENT SCHOOL DISTRICT  
ROCKWALL, TEXAS


FINAL PLANS FOR BIDDING AND CONSTRUCTION

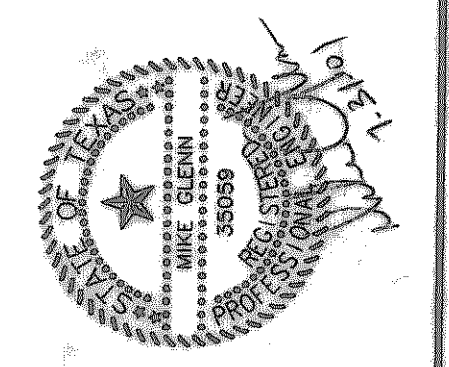

These Drawings have been modified to conform to the Construction Records.  
Glenn Engineering Corporation  
By *[Signature]* Date: 2-23-04

**STORM SEWER PROFILES**  
SCALE: H-1" = 40', V-1" = 5'

BENCH MARK:  
BRASS CAP MONUMENT NO. 10 SET IN CONCRETE IN THE CENTER OF GRASS MEDIAN IN MASTERS DRIVE BETWEEN NORTH LAKESHORE DR. AND SHORES BLVD.  
ELEV. = 524.62

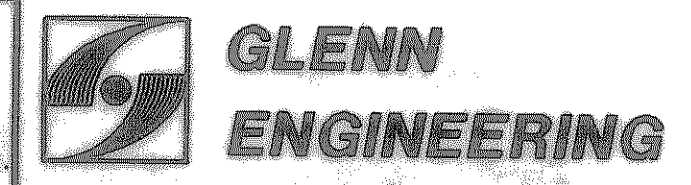

PHONE 972-717-920  
100 DECKER COURT - SUITE 200  
IRVING, TEXAS 75038

FAX 972-710-6229  
IRVING, TEXAS 75038



SHEET NUMBER **C**  
OF **23**  
SET NUMBER **2.11**

P:\ROCKWALL\VIEW-SUMMIT\NOI\BID-SET\LAKEVIEW-SUMMIT-MAY-ENG.dwg, Storm Sewer Profile, 07/20/01 09:48:15 PM, 1:1, Rock-NT