



THE SEAL APPEARING ON THIS DOCUMENT WAS JURISDICTION OF W.L. DOUPHRATE II, TEXAS P.E. NO. 00102 ON 1/1/02

DOUPHRATE & ASSOCIATES, INC.
ENGINEERING - PROJECT MANAGEMENT - SURVEYING
2236 RIDGE RD., # 200 ROCKWALL, TEXAS 75087
PHONE: (972) 771-9004 FAX: (972) 771-9005

PAVING PLAN & PROFILE
N. LAKESHORE DR. STA: 0+00 - 10+64.56
LAKEVIEW SUMMIT
CITY OF ROCKWALL, ROCKWALL COUNTY, TEXAS

REVISION:
- REVISIONS PER CITY COMMENTS 6/7/01
- REVISIONS PER CITY COMMENTS 8/8/01
- REVISIONS PER DEVELOPER 12/1/01

W.L.D.
CHECKED
K.E.B.
DRAWN
6/01
DATE
9918LAKESHORE-REV
PROJECT
6

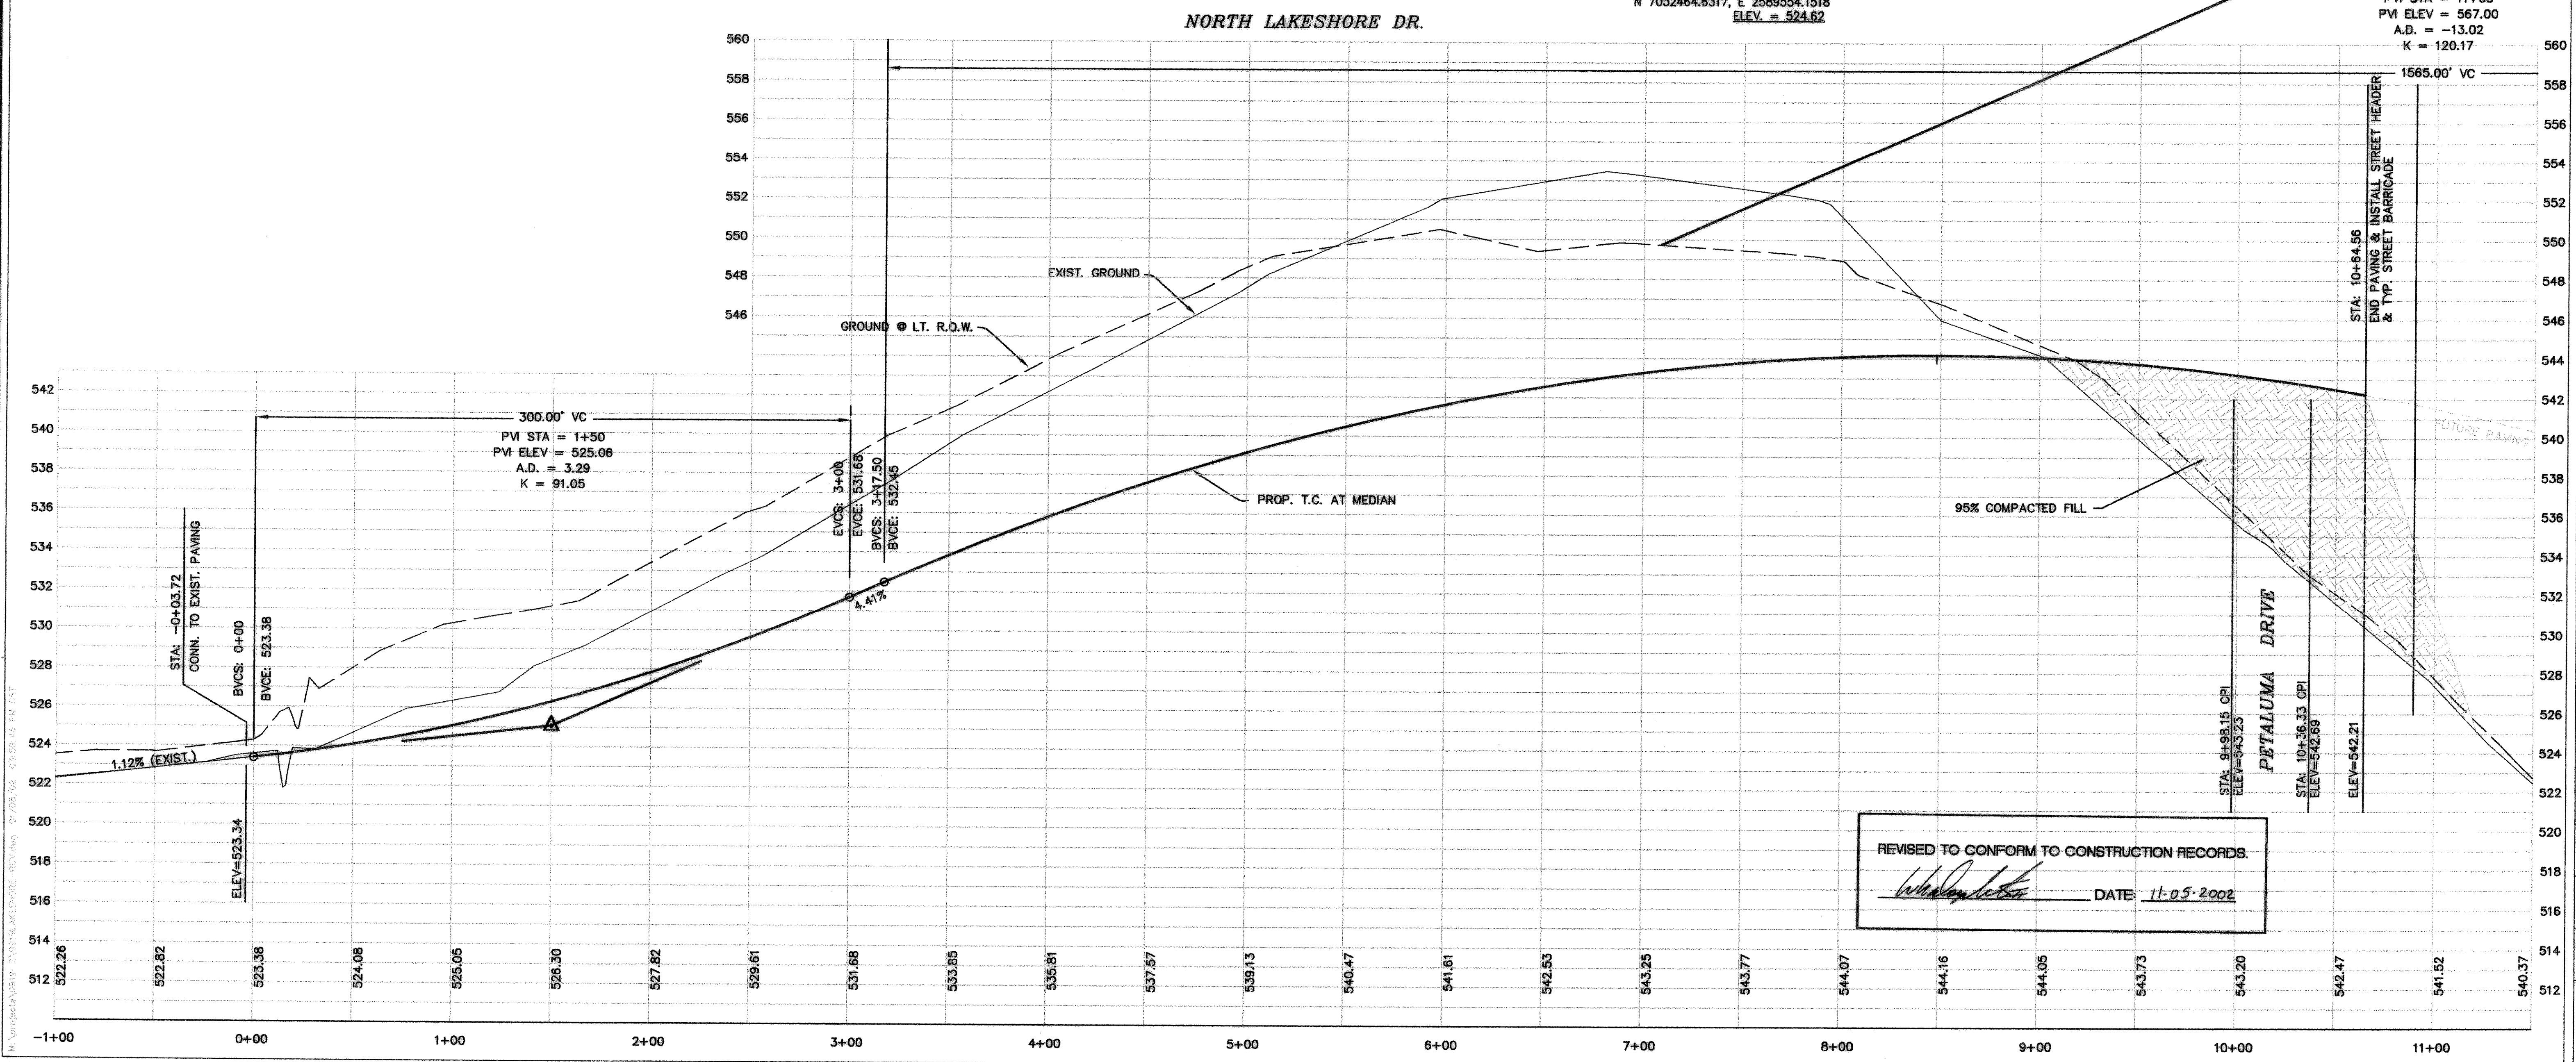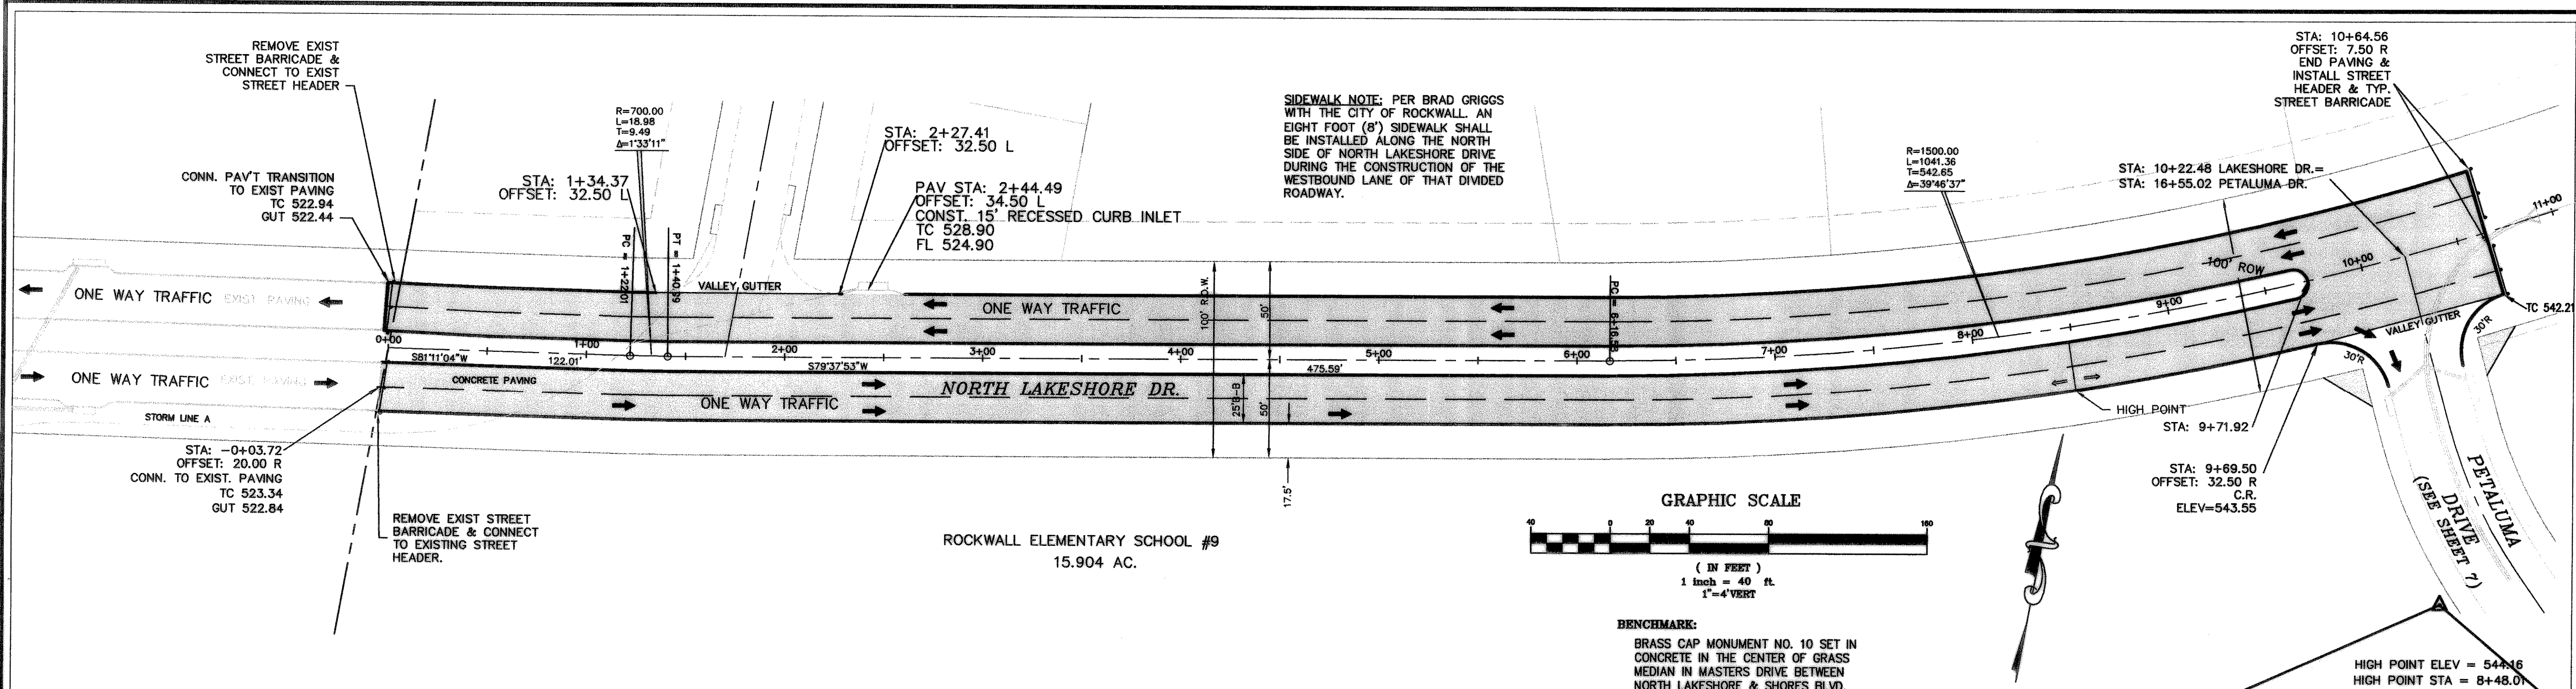

W:\Projects\9918LAKESHORE-REV.dwg 07/28/02 09:52:42 AM ACT