

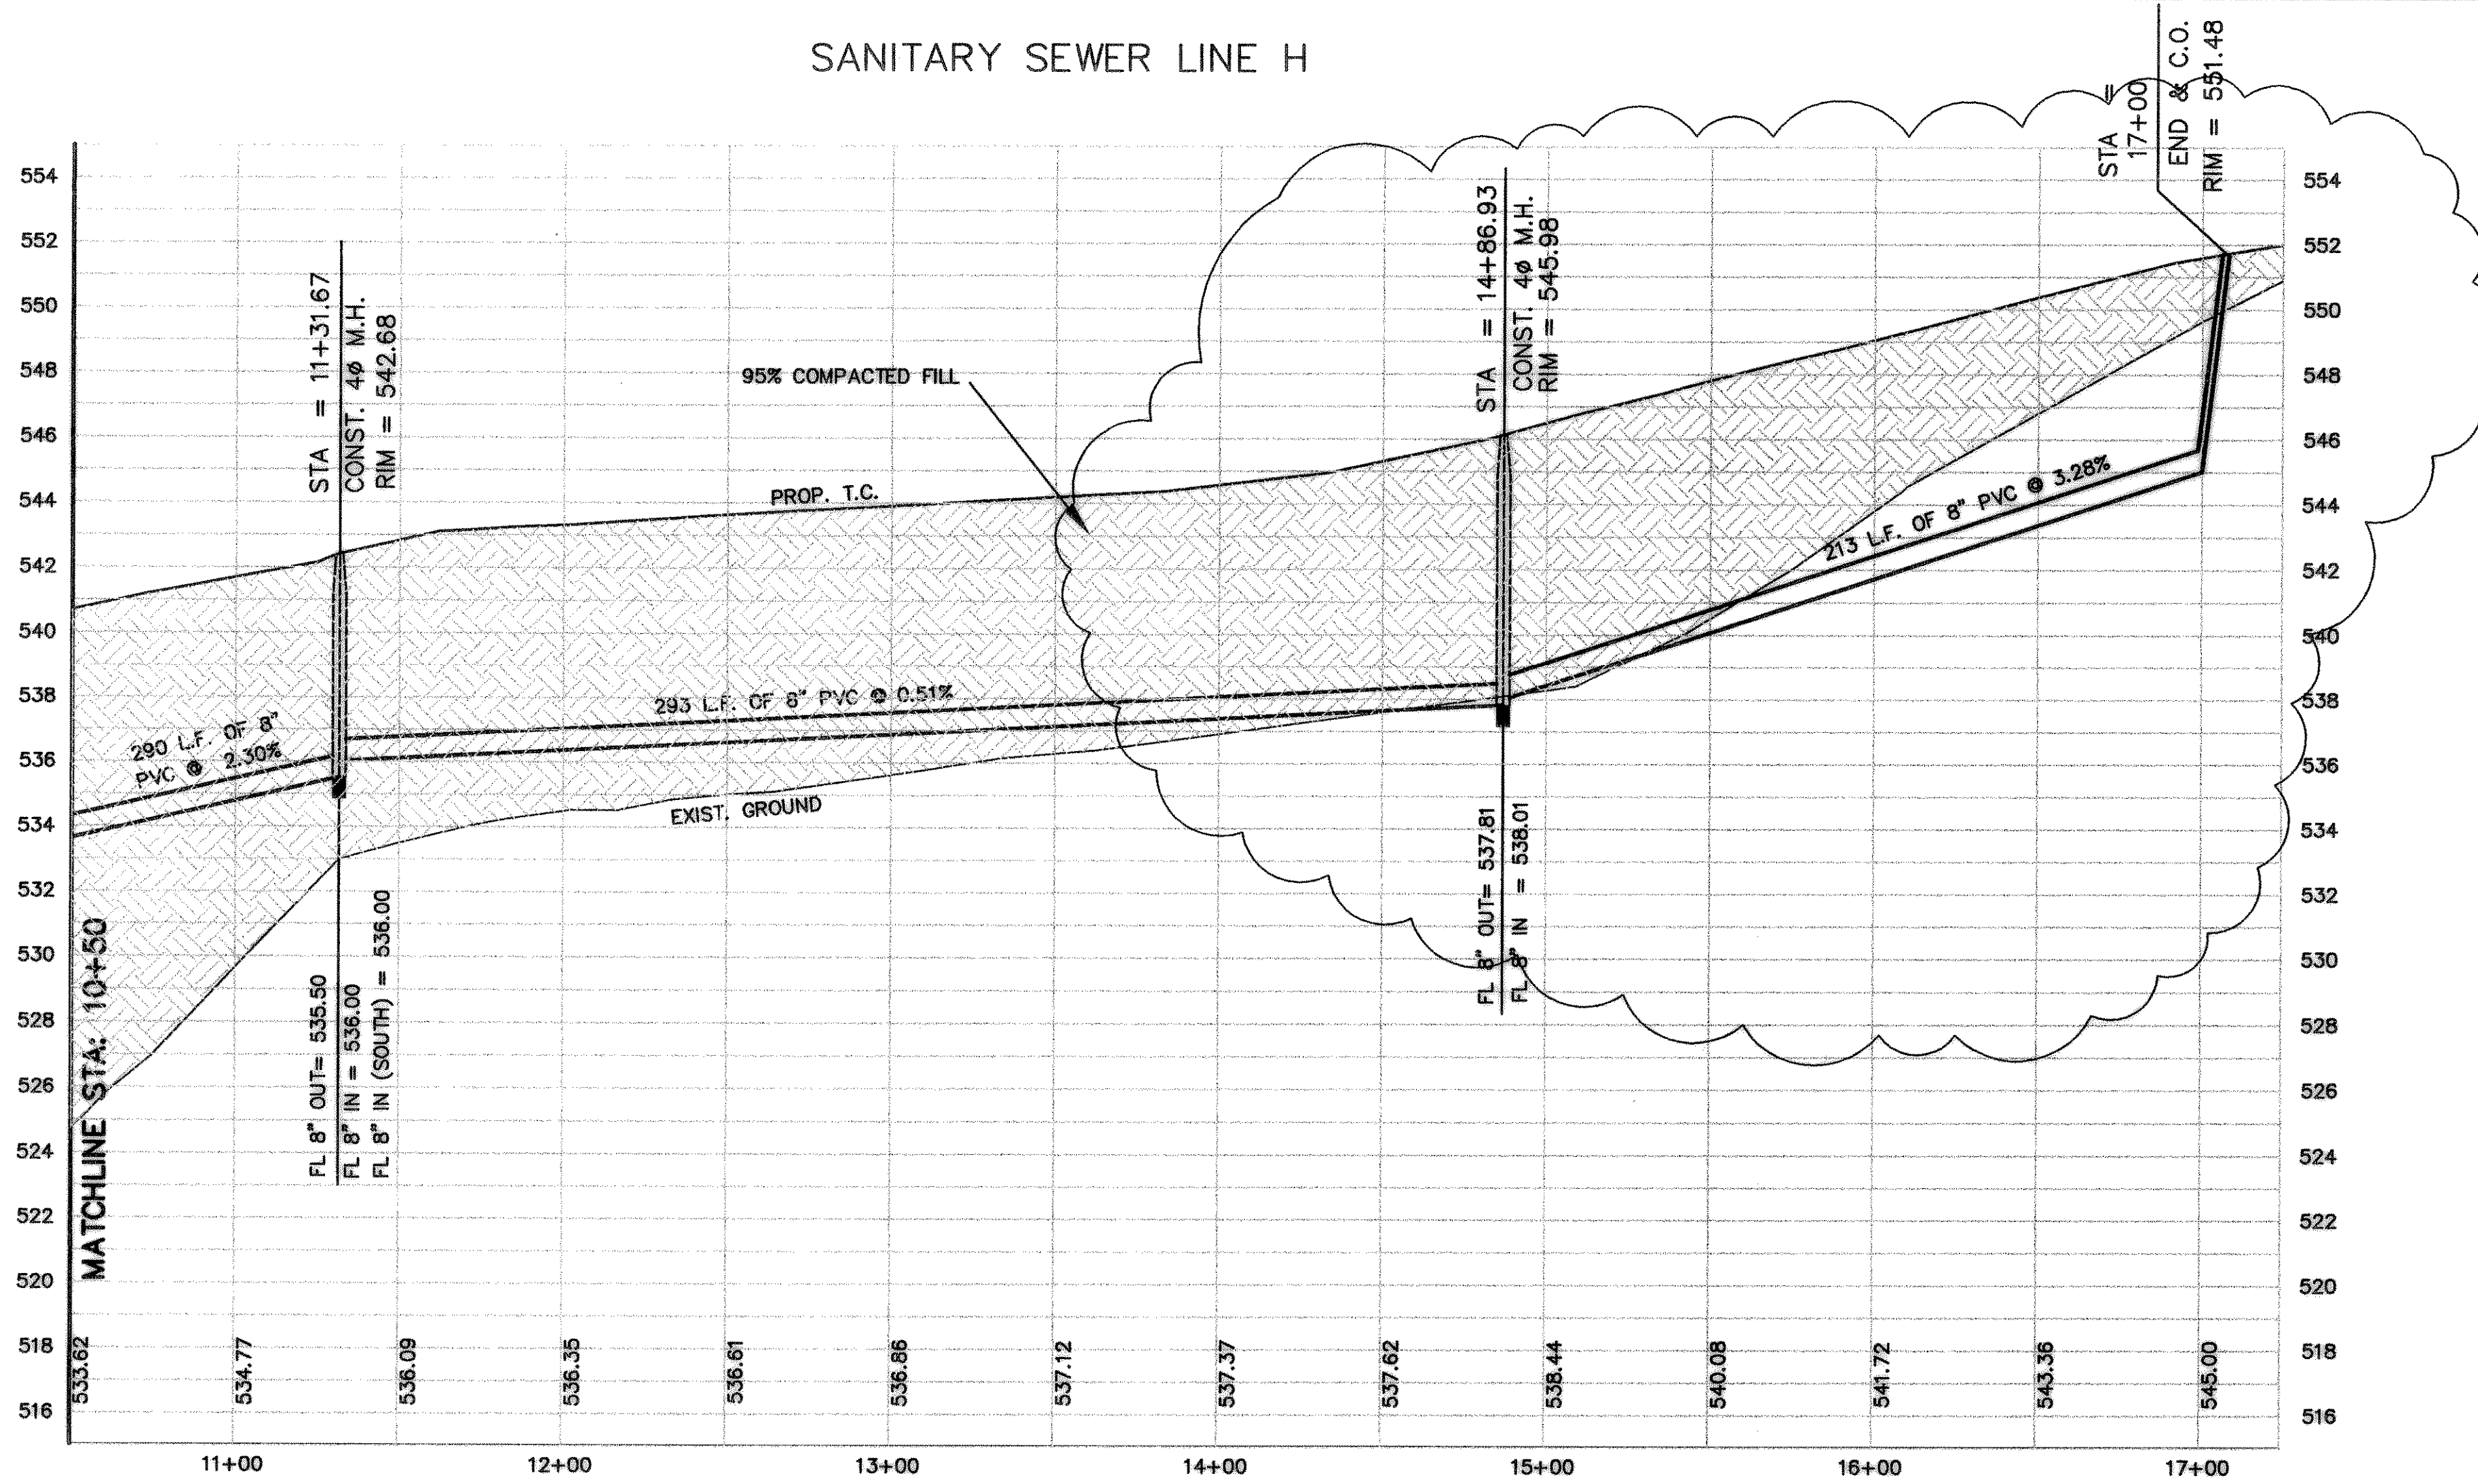


SANITARY SEWER LINE H

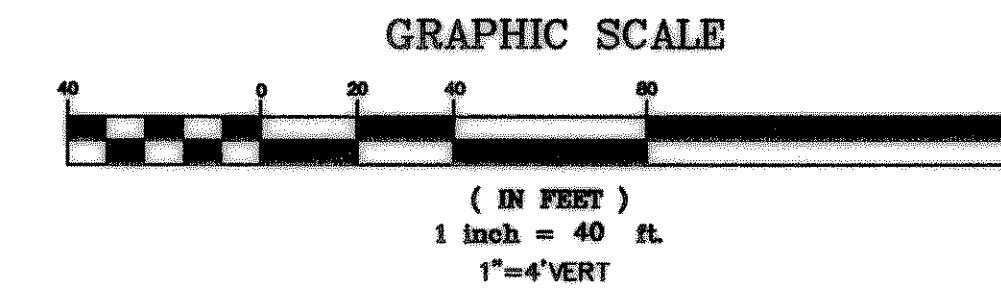


SANITARY SEWER LINE A-1

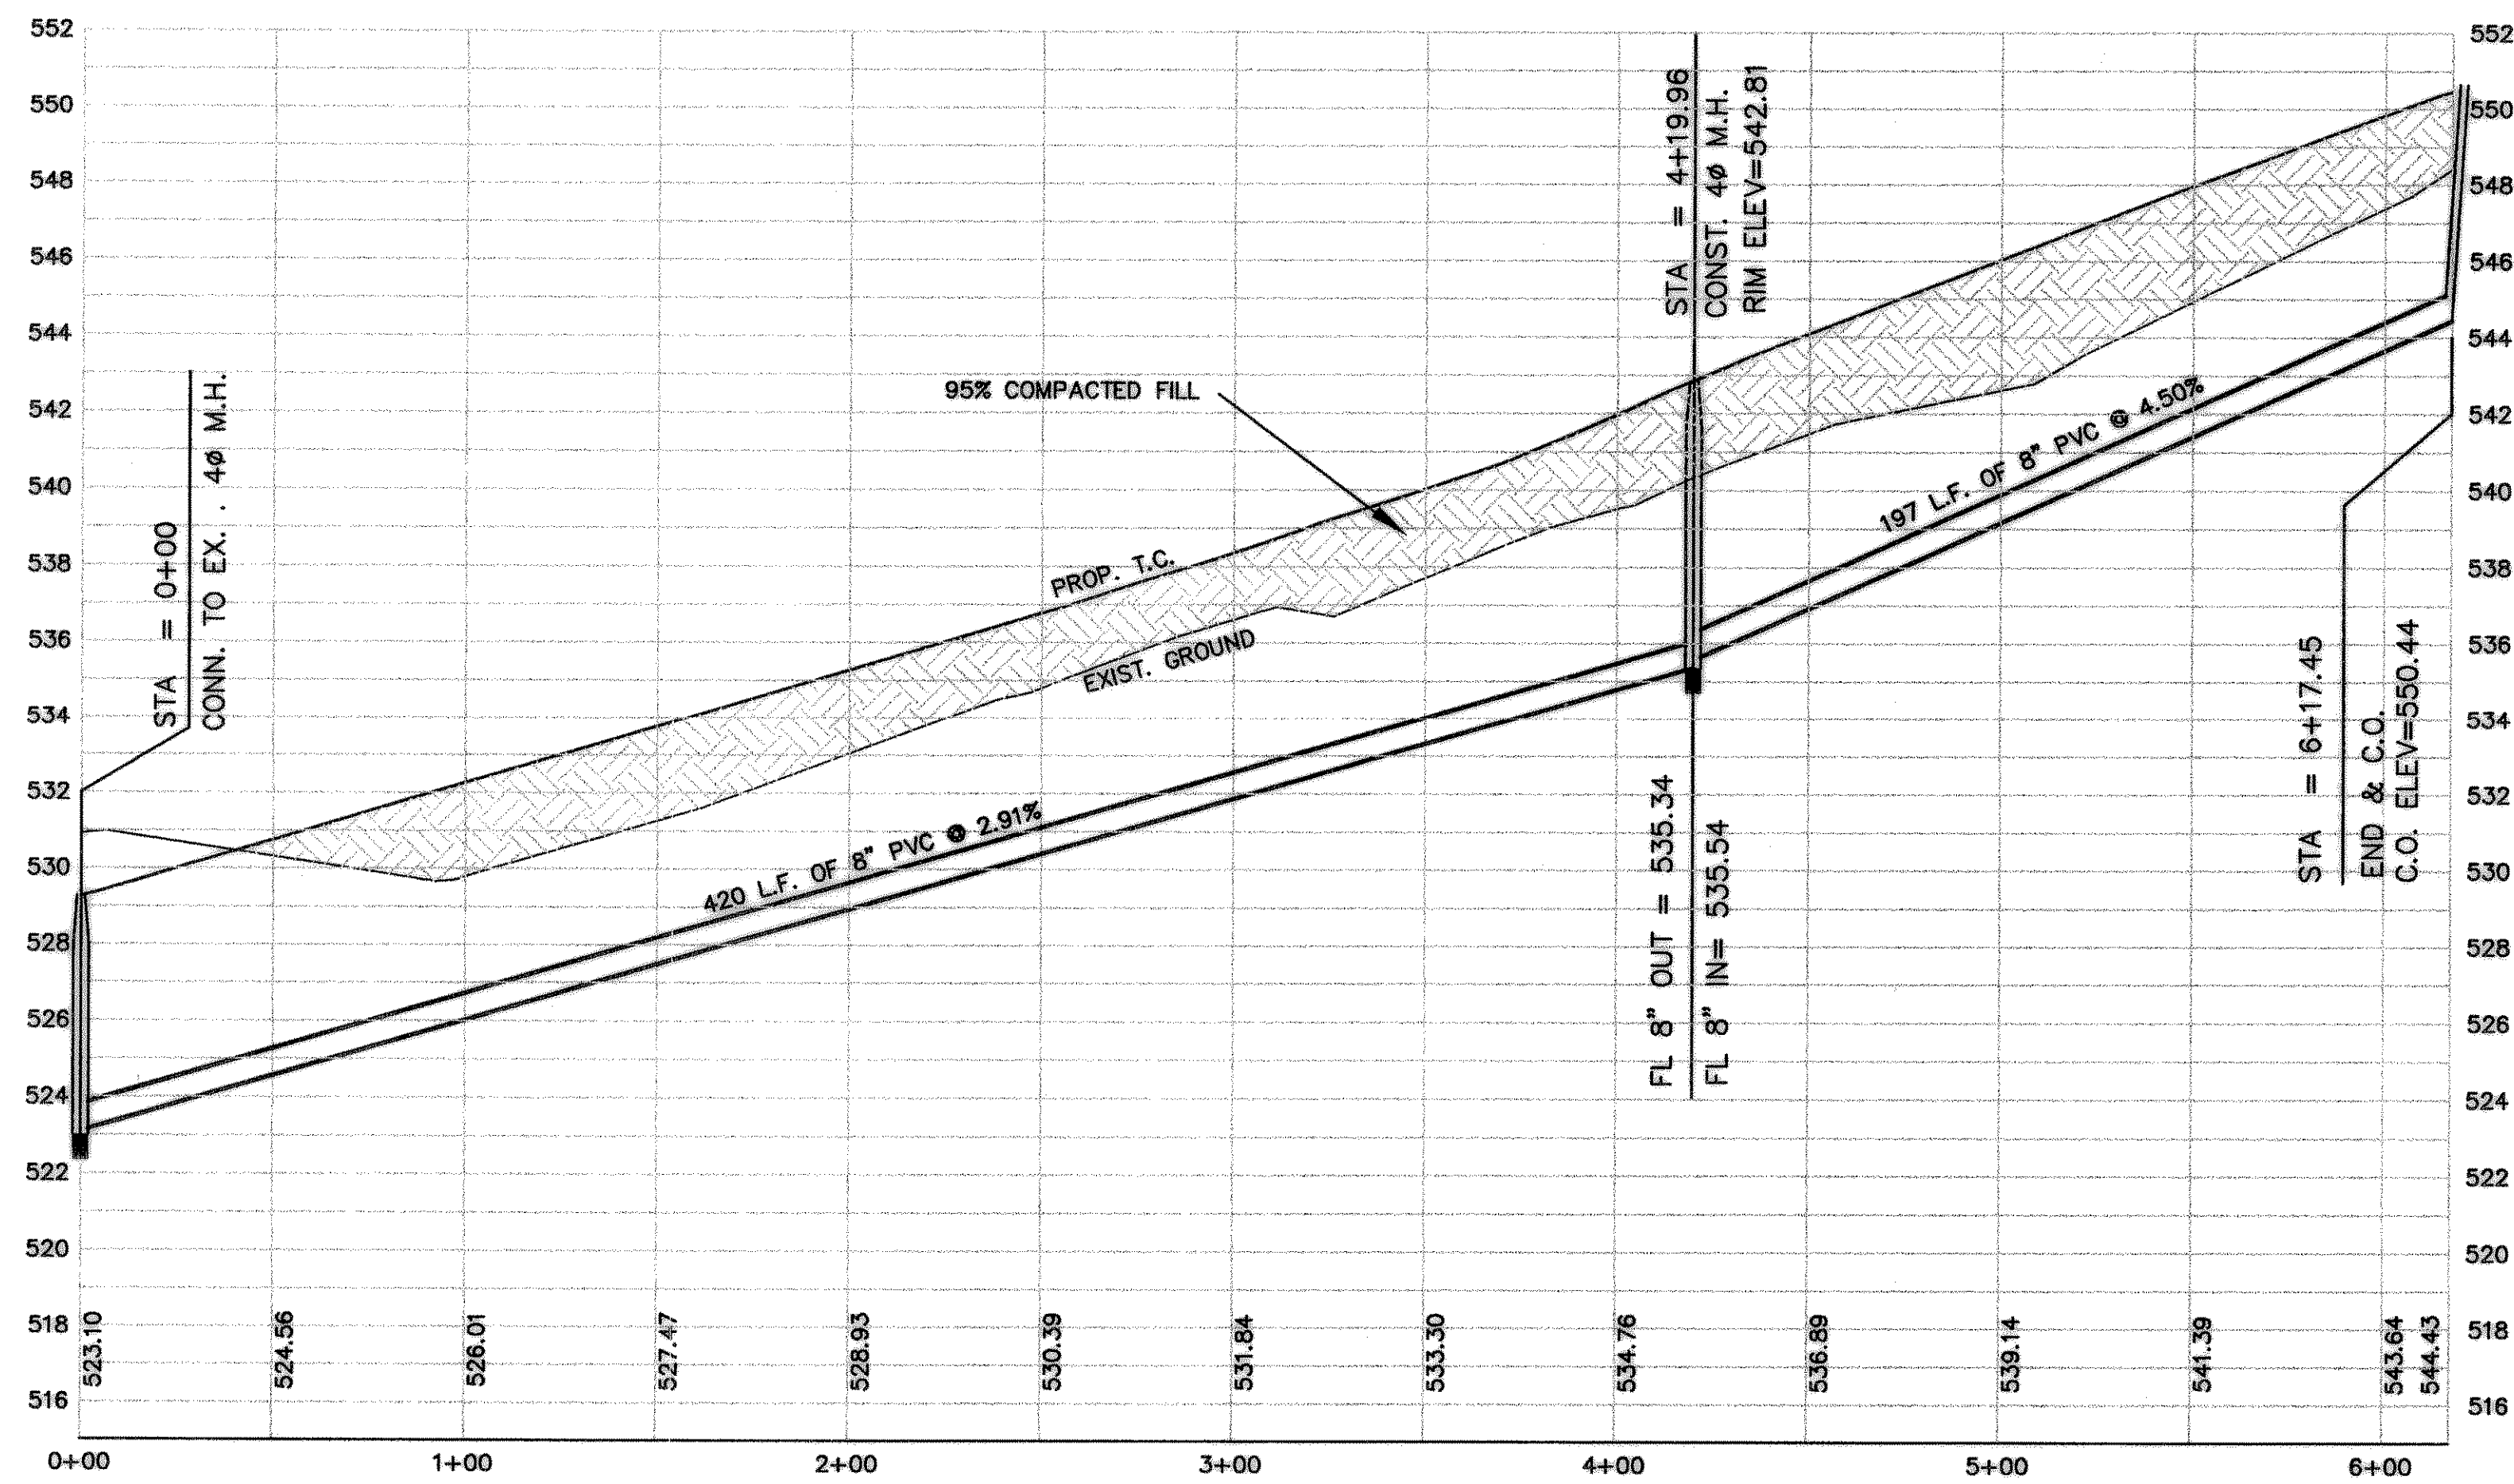

REVISED TO CONFORM TO CONSTRUCTION RECORDS.  
*[Signature]* DATE: 11-05-2002

BENCHMARK:  
 BRASS CAP MONUMENT NO. 10 SET IN  
 CONCRETE IN THE CENTER OF GRASS  
 MEDIAN IN MASTERS DRIVE BETWEEN  
 NORTH LAKESHORE & SHORES BLVD.  
 N 7032464.6317, E 2589554.1518  
 ELEV. = 524.62

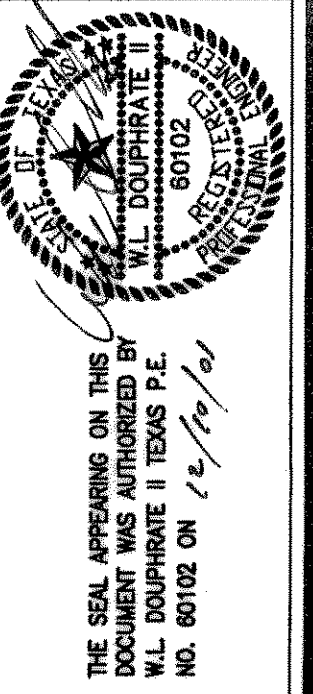

DOUPHRATE & ASSOCIATES, INC.  
 ENGINEERING - PROJECT MANAGEMENT - SURVEYING  
 2235 RIDGE RD., # 200 ROCKWALL, TEXAS 75087  
 PHONE: (972)771-9004 FAX: (972)771-9005

SANITARY SEWER PROFILE  
 LINES H & A-1  
 ROCKWALL ELEMENTARY SCHOOL #9 AREA  
 CITY OF ROCKWALL, ROCKWALL COUNTY, TEXAS

W.L.D.
CHECKED
K.E.B.
DRAWN
10/01
DATE
9919-S-SSP1
PROJECT
12
OF