


- SANITARY SEWER NOTES:**
- CONTRACTOR SHALL NOTIFY ALL UTILITY COMPANIES AND OTHERS WHO MAY HAVE BURIED EQUIPMENT OR PIPELINES IN THE VICINITY OF CONSTRUCTION PRIOR TO COMMENCING CONSTRUCTION. DAMAGE TO EXISTING UTILITIES SHALL BE REPAIRED AT THE CONTRACTOR'S EXPENSE.
 - CONTRACTOR SHALL VERIFY THE LOCATION AND DEPTH OF TIE-IN TO EXISTING SEWER SYSTEM. GRADES NEED REVISING DUE TO UNFORESEEN CONFLICTS. CONTRACTOR SHALL NOTIFY THE ENGINEER PRIOR TO LAYING PIPE.
 - UNLESS OTHERWISE REQUIRED, ALL SANITARY SEWER PIPE, MANHOLES, AND RELATED APPURTENANCES SHALL CONFORM TO THE MATERIAL AND CONSTRUCTION SPECIFICATIONS AS SET FORTH IN THE CITY OF ROCKWALL STANDARD SPECIFICATIONS.
 - PARTICULAR ATTENTION SHALL BE PAID TO THE INSTALLATION, EMBEDMENT, AND BACKFILL OF SEWER PIPE. ALL EMBEDMENT SHALL CONFORM TO CITY OF ROCKWALL CLASS 'B'.
 - SPECIAL CARE SHALL BE TAKEN IN ADHERING TO THOSE SPECIFICATIONS REGARDING PIPE JOINTS, PIPE EMBEDMENT AND TESTING OF INSTALLED WATER AND SANITARY SEWER PIPES.
 - SEWER PIPE SHALL BE PVC SDR 35.
 - SERVICES SHALL BE 4" PVC, SDR 35, AND SHALL BE INSTALLED AS SHOWN.
 - CONTRACTOR SHALL MEET ALL O.S.H.A. REQUIREMENTS REGARDING TRENCH SAFETY IN THE CONSTRUCTION OF THIS SEWER SERVICE.
 - GREEN EMS DISKS SHALL BE INSTALLED ON SANITARY SEWER LINES AT EVERY MANHOLE, CLEANOUT, CHANGE OF DIRECTION AND SERVICES.
 - ALL WORK SHALL CONFORM TO THE CITY OF ROCKWALL SPECIFICATIONS, STANDARDS, AND DETAILS.

BENCH MARKS:

BENCHMARK 1: USGS MONUMENT - STAMPED BOREN 1986
 LOCATED APPROXIMATELY 1.25 MILES EAST OF ROCKWALL AT THE ROCKWALL MUNICIPAL AIRPORT, IN THE NORTH END OF A CIRCULAR GRASS AREA AT THE END OF A TAXIWAY.
 ELEVATION = 573.94

BENCHMARK 2: USGS MONUMENT - 5" CAP STAMPED N 1495/1986
 LOCATED 24.6 FEET WEST OF THE CENTER OF A PAVED ROAD LEADING TO THE ROCKWALL MUNICIPAL AIRPORT, 16.4 FEET SOUTH OF A UTILITY POLE WITH A TRANSFORMER AND LIGHT, 2 FEET WEST OF THE NORTH LEG OF A SIGN. ACCESS TO DATUM POINT IS THROUGH A 5 INCH LOGO CAP.
 ELEVATION = 566.70

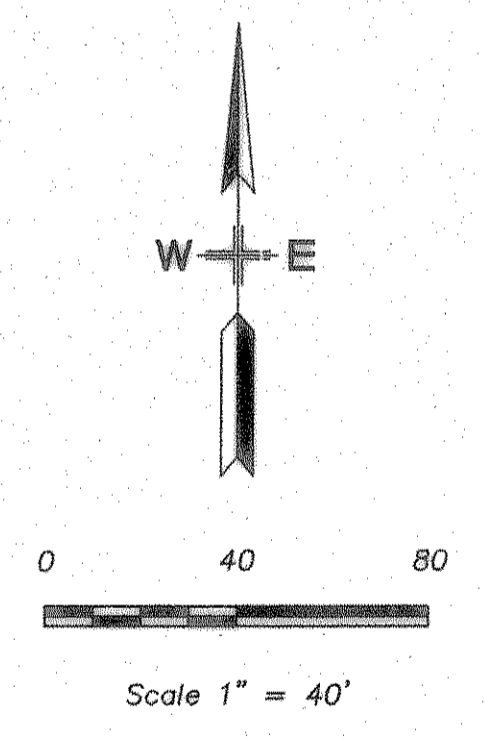

RECORD DRAWING


This is to certify that changes and corrections have been made to conform to the contractor's record of this project.

[Signature] 8.7.07
 Signed Date
 Glenn Engineering Corporation

SANITARY SEWER PLAN
 SCALE: 1" = 40'


GLENN ENGINEERING

PHONE 972-777-8811 FAX 972-777-8776
 105 DECKER COURT - SUITE 810 IRVING, TEXAS 75062

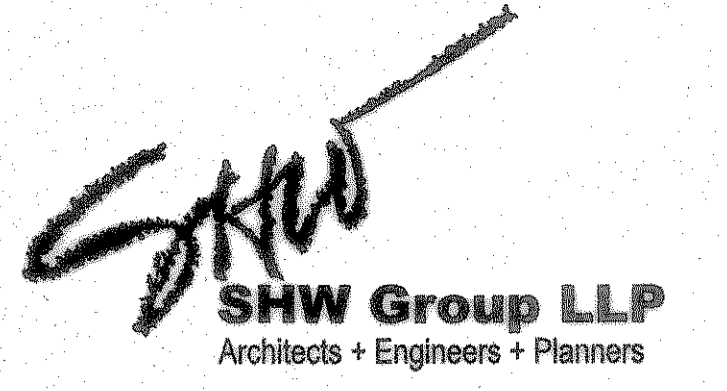

- Consultants:
- CIVIL: GLENN ENGINEERING CORP
 - STRUCTURAL: SHW GROUP, LLP
 - MEP: ESTES MCLURE AND ASSOCIATES.
 - FOOD SERVICE: H. G. RICE Inc.
 - LANDSCAPING: GRUBBS RAMSEY

FINAL PLANS FOR BIDDING AND CONSTRUCTING

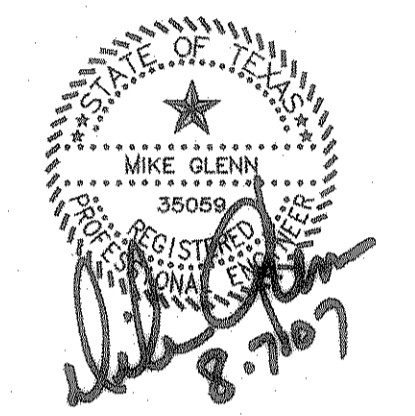

Rockwall Independent School District

ROCKWALL ELEMENTARY SCHOOL #11
 RISD, TEXAS

Project Number: 1441.05.021
 Drawing Date: 3/09/2006
 Drawn: R.HOWMAN
 Checked: RAH
 Scale: AS SHOWN
 ACAD File: BUSIEK-ENG-SITE2_CITYREV3.dwg
 © 2006 SHW Group, LLP

- Revisions:
- 07/20/2006 CITY COMMENTS
 - 08/15/2006 CITY COMMENTS
 - 10/17/2006 REVISED BOX ELEVATIONS
 - 10/23/2006 WATER REVISIONS

Sheet Title:
SANITARY SEWER PLAN

CU 1.02

Aug 07, 2007 3:28pm User: Rick
 \\Roberthp\C-DRIVE\ROCKKISD\DALTON RANCH BUSIEK ELEM\FINAL SET\BUSIEK-ENG-SITE2_CITYREV3.dwg