

**LINE TABLE**

LINE	BEARING	LENGTH
L1	S29°54'12"E	75.61
L2	S00°10'34"W	758.26
L3	N89°49'26"W	72.50
L4	S71°22'51"W	40.00
L5	S68°23'40"W	320.76
L6	N21°36'20"W	287.30
L7	N45°19'51"E	20.00
L8	N00°42'31"E	239.45
L9	S89°17'29"E	166.57
L10	N00°45'53"E	298.56
L11	N79°45'29"E	171.35
L12	S83°17'21"E	9.87

**CURVE TABLE**

CURVE	D=	R=	L=	CB=	LC=
C1	18°43'41"	625.00	204.29	S77°45'30"W	203.38
C2	23°03'49"	325.00	130.82	N33°08'15"W	129.94
C3	5°52'18"	1949.86	199.82	N82°41'37"E	199.73
C4	9°36'53"	1105.92	185.58	N84°44'32"E	185.37

**GENERAL TOPOGRAPHIC NOTES**

1. TOPOGRAPHIC SURVEY BY DOWDEY, ANDERSON & ASSOCIATES, INC. 5225 VILLAGE CREEK DRIVE, STE 200, PLANO TEXAS, (972)-931-0694
2. LIMESTONE HILL LANE TO BE CONSTRUCTED BY OTHERS IN ACCORDANCE WITH PLANS PREPARED BY DOWDEY, ANDERSON & ASSOCIATES, INC..
3. SPOT GRADES SHOWN ON LIMESTONE HILL LANE AND ADJACENT RESIDENTIAL SUBDIVISION, HICKORY RIDGE PHASE FOUR, LOTS 12, 13, 14, 15 & 16 BASED ON GRADING PLANS PREPARED BY DOWDEY, ANDERSON & ASSOCIATES, INC..


**RECORD DRAWING**  
 This is to certify that changes and corrections have been made to conform to the contractor's record of this project.  
 Signed: *Glenn* Date: 8-7-07  
 Glenn Engineering Corporation

**TOPOGRAPHIC SURVEY**  
 SCALE: 1" = 60'

**GLENN ENGINEERING**  
 PHONE 972-717-8081 FAX 972-717-2076  
 106 DECKER COURT - SUITE 910 IRVING, TEXAS 75062

- Consultants:
- CIVIL: GLENN ENGINEERING CORP
  - STRUCTURAL: SHW GROUP, LLP
  - MEP: ESTES McCLURE AND ASSOCIATES.
  - FOOD SERVICE: H. G. RICE Inc.
  - LANDSCAPING: GRUBBS RAMSEY

FINAL PLANS FOR BIDDING AND CONSTRUCTING

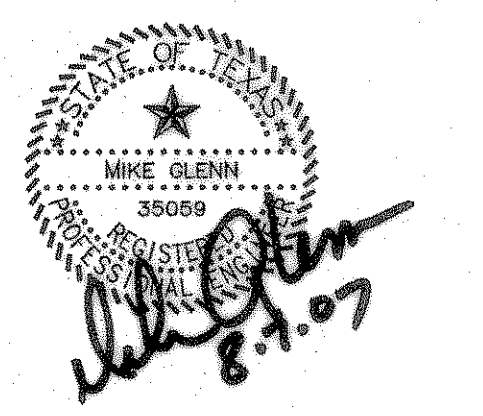

**Rockwall Independent School District**

**ROCKWALL ELEMENTARY SCHOOL #11**  
 RISD, TEXAS

Project Number: 1441.05.021  
 Drawing Date: 3/09/2006  
 Drawn: R.HOWMAN  
 Checked: RAH  
 Scale: AS SHOWN  
 ACAD File: BUSIEK-ENG-SITE2\_CITYREV3.dwg  
 © 2006 SHW Group, LLP

- Revisions:
- 1 07/20/2006 CITY COMMENTS
  - 2 08/15/2006 CITY COMMENTS
  - 3 10/17/2006 REVISED BOX ELEVATIONS
  - 4 10/23/2006 WATER REVISIONS

Sheet Title:  
**TOPOGRAPHIC SURVEY**

**V 1.01**

Aug 07, 2007 3:47pm User: Rick  
 \\Roberthp\C-DRIVE\ROCKISD\DALTON RANCH BUSIEK ELEM\FINAL SET\BUSIEK-ENG-SITE2\_CITYREV3.dwg