

Consultants:

CIVIL:
GLENN ENGINEERING CORP


STRUCTURAL:
SHW GROUP, LLP

MEP:
ESTES McCLURE AND ASSOCIATES.

FOOD SERVICE:
H. G. RICE Inc.

LANDSCAPING:
GRUBBS RAMSEY

FINAL PLANS FOR BIDDING AND CONSTRUCTING

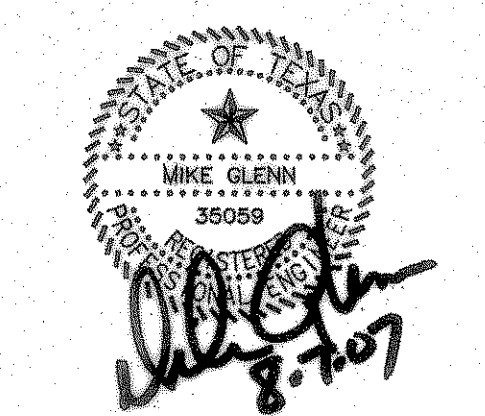

Rockwall Independent School District


ROCKWALL ELEMENTARY SCHOOL #11
RISD, TEXAS

Project Number: 1441.05.021
Drawing Date: 3/09/2006
Drawn: R.HOWMAN
Checked: RAH
Scale: AS SHOWN
ACAD File: BUSIEK-Details-ALL.dwg
© 2006 SHW Group, LLP

Revisions:

- 07/20/2006 CITY COMMENTS
- 08/15/2006 CITY COMMENTS
- 10/17/2006 REVISED BOX ELEVATIONS
- 10/23/2006 WATER REVISIONS

Sheet Title:
WALL DETAILS

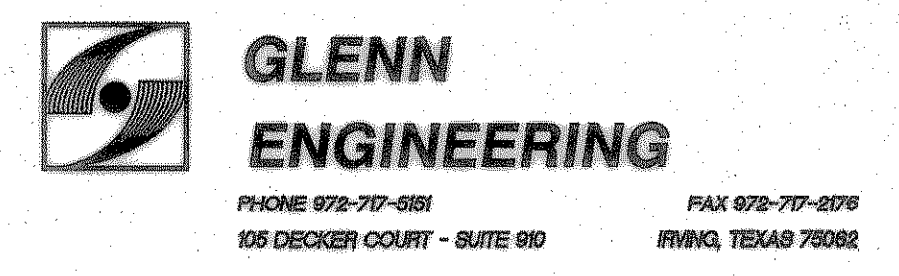

CP 1.03

User: Rick Aug 07, 2007 - 3:34pm \\Roberthp\C-DRIVE\ROCKISD\DALTON RANCH BUSIEK ELEM\FINAL SET\DETAILS\BUSIEK-Details-ALL.dwg