



RECORD DRAWING
 This is to certify that changes and corrections have been made to conform to the contractor's record of this project.
 Signed: *[Signature]* Date: 8.7.07
 Glenn Engineering Corporation

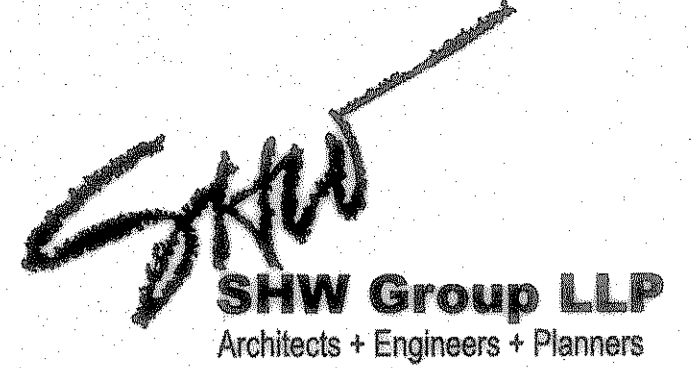

Consultants:
 CIVIL: GLENN ENGINEERING CORP
 STRUCTURAL: SHW GROUP, LLP
 MEP: ESTES McCLURE AND ASSOCIATES.
 FOOD SERVICE: H. G. RICE Inc.
 LANDSCAPING: GRUBBS RAMSEY

FINAL PLANS FOR BIDDING AND CONSTRUCTING

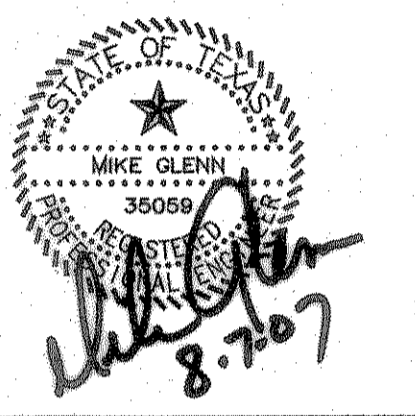

Rockwall Independent School District

ROCKWALL ELEMENTARY SCHOOL #11
 RISD, TEXAS

Project Number: 1441.05.021
 Drawing Date: 3/09/2006
 Drawn: R.HOWMAN
 Checked: RAH
 Scale: AS SHOWN
 ACAD File: BUSIEK-ENG-SITE2_CITYREV3.dwg
 © 2006 SHW Group, LLP

- Revisions:
- 1 07/20/2006 CITY COMMENTS
 - 2 08/15/2006 CITY COMMENTS
 - 3 10/17/2006 REVISED BOX ELEVATIONS
 - 4 10/23/2006 WATER REVISIONS

Sheet Title:
WATER PROFILES

GLENN ENGINEERING
 PHONE 972-717-3151 FAX 972-717-2716
 105 DECKER COURT - SUITE 910 IRVING, TEXAS 75038

WATER PROFILES
 SCALE: 1" = 40'

CU 1.01A