


BENCH MARKS:
□ CUT: ON NORTHEAST CURB BETWEEN HIGHPOINT BOULEVARD AND SUMMIT DRIVE. ELEVATION = 679.03
□ CUT: ON SOUTH TOP OF CURB OF WILKETH RD. AT STUB OUT 181' WEST OF PENNAKLE DRIVE. ELEVATION = 681.22




DRAINAGE AREA MAP
SCALE: 1" = 100'

These Drawings have been modified to conform to the Construction Records of Glenn Engineering Corporation.
By *[Signature]* Date: 2-23-04

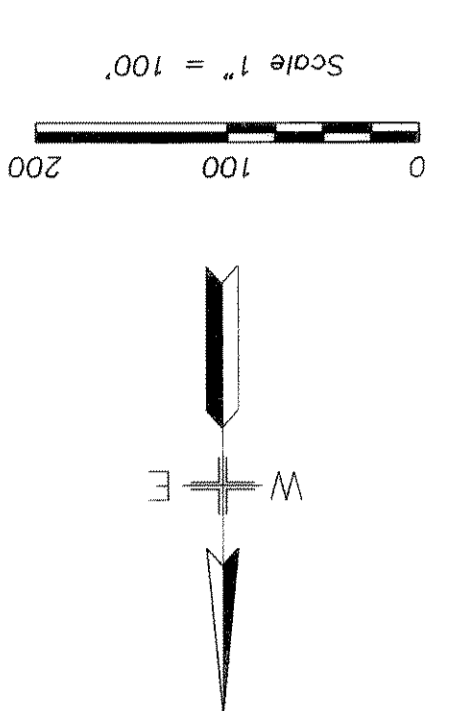

SET NUMBER
OF SHEET NUMBER
2.9

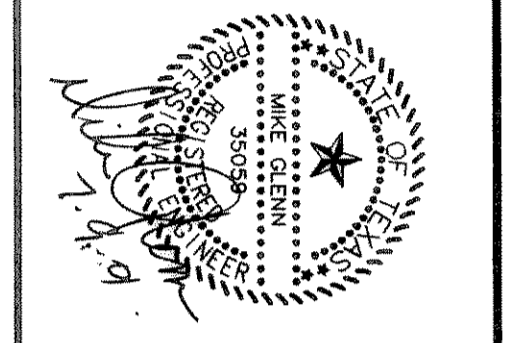

FINAL PLANS FOR BIDDING AND CONSTRUCTION

ROCKWALL ELEMENTARY #8

ROCKWALL INDEPENDENT SCHOOL DISTRICT

ROCKWALL, TEXAS

DATE: MAY 2, 2001
DRAWN BY: R. HOWMAN
CHECKED: RAH
COMM NO: [blank]
REVISED: [blank]