

STORM SEWER PROFILE

SCALE: H-1" = 40', V-1" = 5'


These Drawings have been modified to conform to the
 Clean Engineering Records.
 Clean Engineering Corporation
 By *J. Glenn* Date: 2.23.04



PHONE 972-717-5151
 100 DICKER COURT - SUITE 250 IRVING, TEXAS 75062
 FAX 972-719-4229

SET NUMBER
 OF SHEET NUMBER
 2.13

SHW Group Inc.
 Architects + Engineers

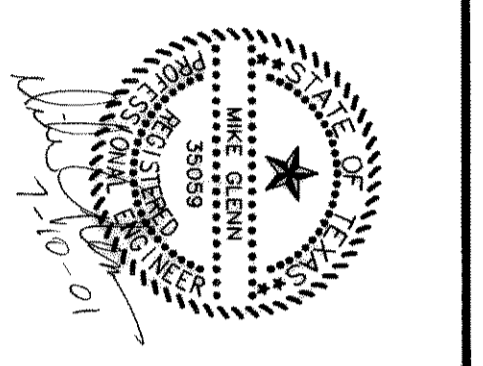

FINAL PLANS FOR BIDDING AND CONSTRUCTION

ROCKWALL ELEMENTARY #8
ROCKWALL INDEPENDENT SCHOOL DISTRICT
ROCKWALL, TEXAS

DATE: MAY 2, 2001
 DRAWN BY: R. HOWMAN
 CHECKED: TJC
 COMM. NO.
 REVISIONS