


Bruce couldn't find this map on T-drive

Curtis

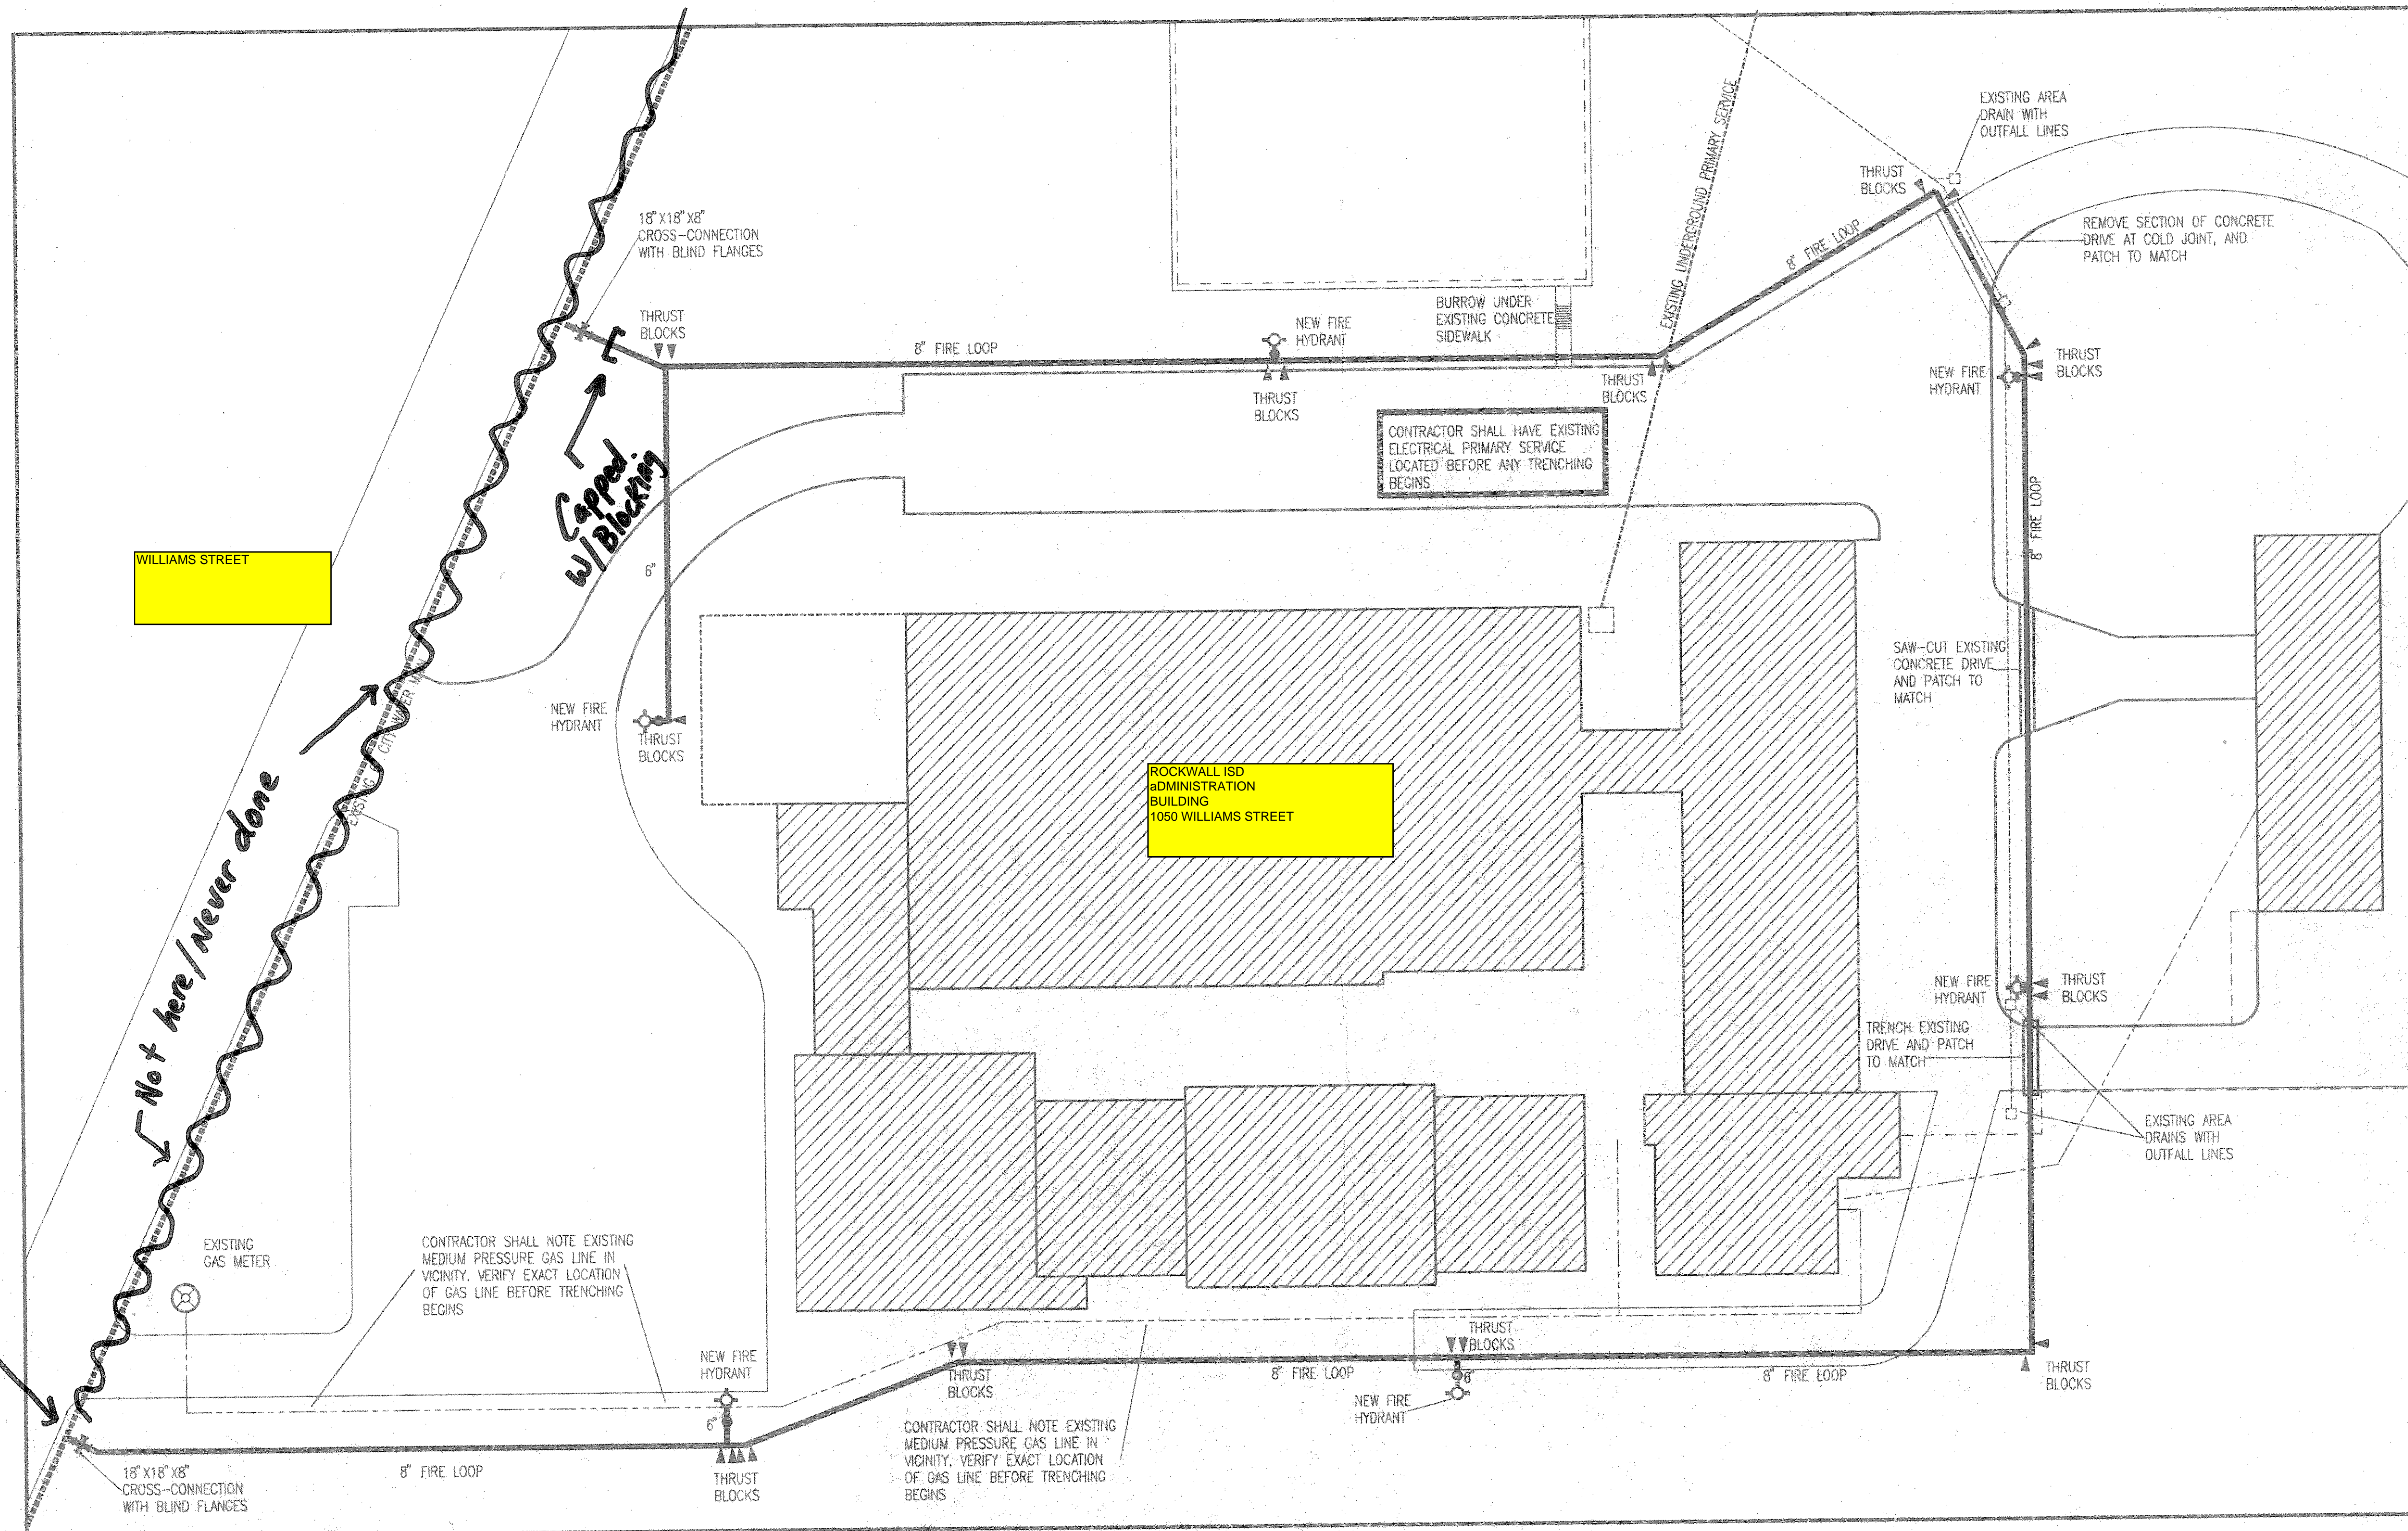

90° bend or Tee with End Cap

Not here / Never done

Capped w/ Block

MECHANICAL & PLUMBING SITE PLAN

1
8.0 1"=40'-0"

DATE	9 SEPT. 1994
DRAWN BY	BAJ
CHECKED	DAJ
DATE	10-1-94
BY	DAJ
REVISION	10-94/14

WILLIAMS MIDDLE SCHOOL
 PHASE 2 - 1994 RENOVATIONS & ADDITION
 ROCKWALL I.S.D. ROCKWALL, TEXAS

10.51
 1-4-1995
 Delmar H. Long
 Owner

KEY PLAN

FINAL PLANS FOR BIDDING AND CONSTRUCTION

SHW
 ARCHITECTS
 ENGINEERS
 SHW Group Inc

SHEET NUMBER
 MP
8.0

EM Estes, McClure & Assoc., Inc.
 CONSULTING ENGINEERS
 3805 West Way
 Tyler, Texas 75703
 903-661-2677

260 S. Stoneman Freeway
 Suite 100
 Lewisville, Texas 76007