


- LEGEND**
- EXISTING ASPHALT PAVEMENT
  - PROPOSED CONCRETE PAVEMENT
  - PROPOSED ASPHALT PAVEMENT
  - PROPOSED 2" ASPHALT OVER-LAY
  - PROPOSED 4" SIDEWALK
  - TACK COAT AND SEAL COAT
  - 2-4" PVC SLEEVES



DATE: MAY 15, 1998  
 DRAWN BY: R. HOWMAN  
 CHECKED: R.A.H.  
 COUN. NO: 0494453  
 REVISION: JUNE 15, 1998

**ROCKWALL I.S.D. 1998 PAVING IMPROVEMENTS**  
**WILKERSON SANDERS STADIUM PAVING IMPROVEMENTS**  
**ROCKWALL, TEXAS**

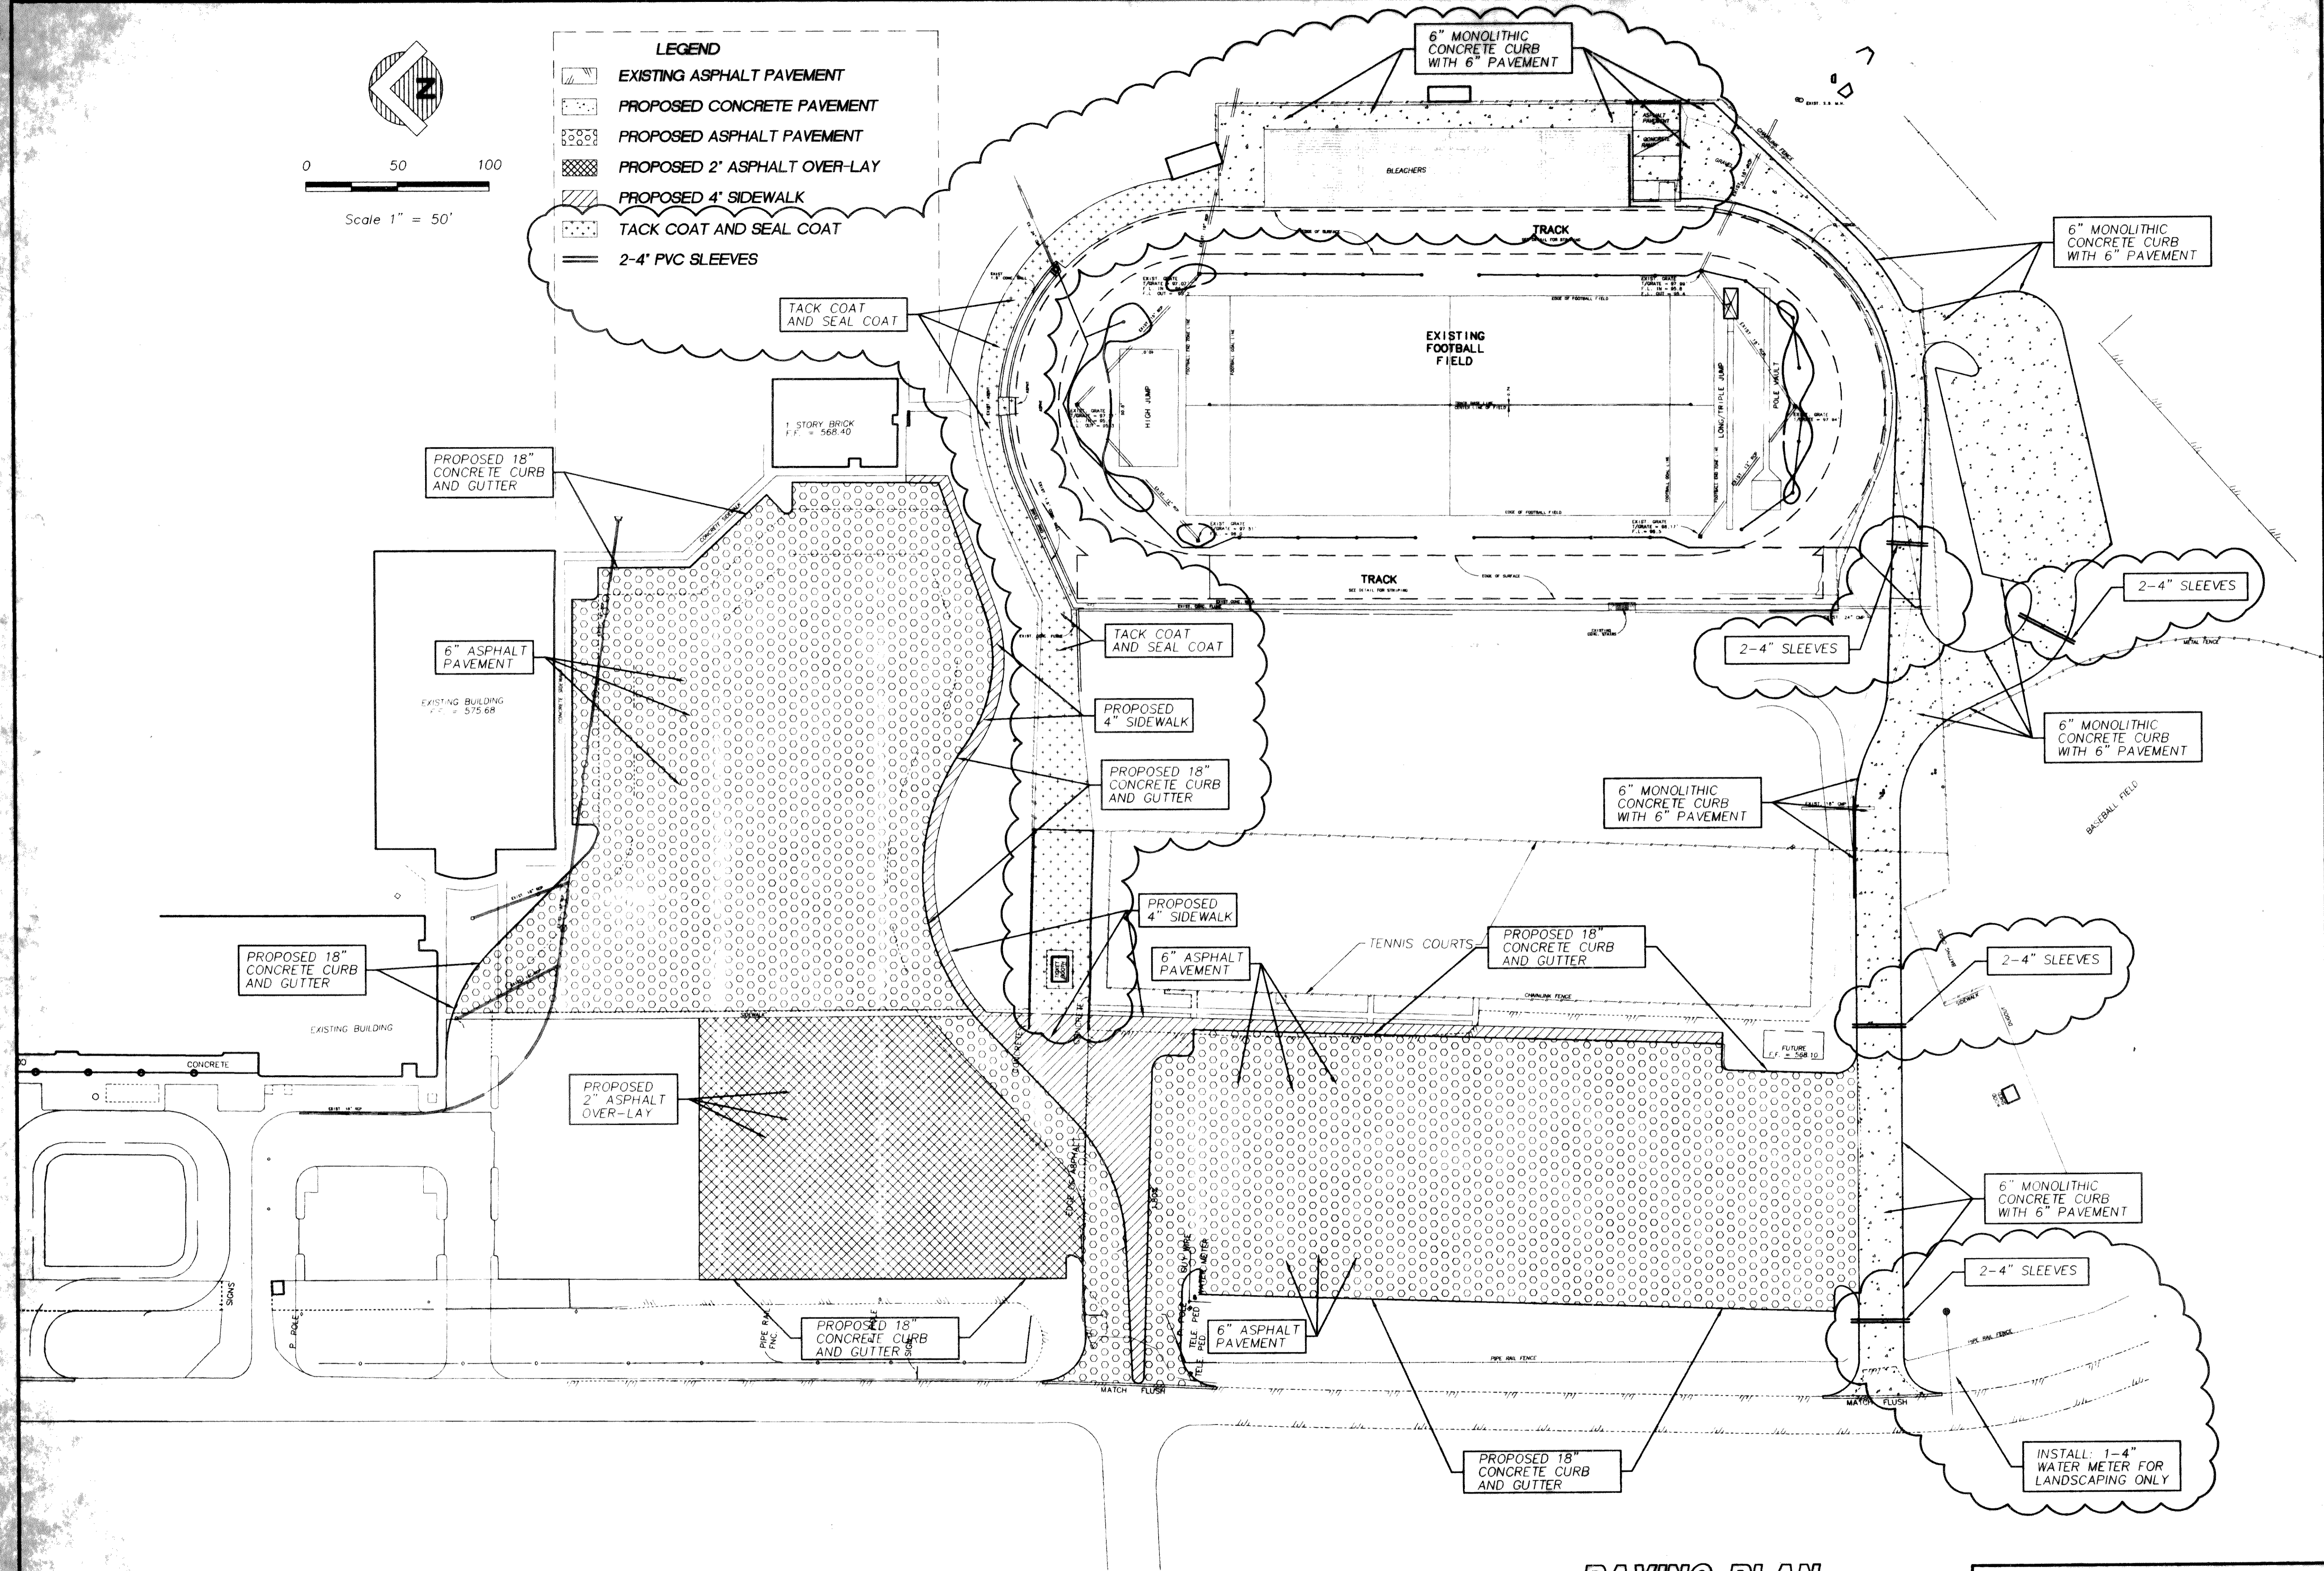

**PAVING PLAN**  
 SCALE: 1"=50'

**GLENN ENGINEERING**  
 PHONE 94-77-981 FAX 94-77-929  
 100 DECKER COURT - SUITE 250 FARMING, TEXAS 76046

SHEET NUMBER	C
OF	4
SET NUMBER	2.3R

C:\WORK\SOFT\LE\plans.dwg Tue Jun 16 13:51:33 1998