


DATE: APRIL 29, 1998
 DRAWN BY: R. HOWMAN
 CHECKED: R.A.H.
 CDAM NO: 0494453
 ISSUED: JULY 8, 1998


ROCKWALL I.S.D. 1998 PAVING IMPROVEMENTS
ROCKWALL STADIUM PARKING IMPROVEMENTS
ROCKWALL I.S.D. ROCKWALL, TEXAS

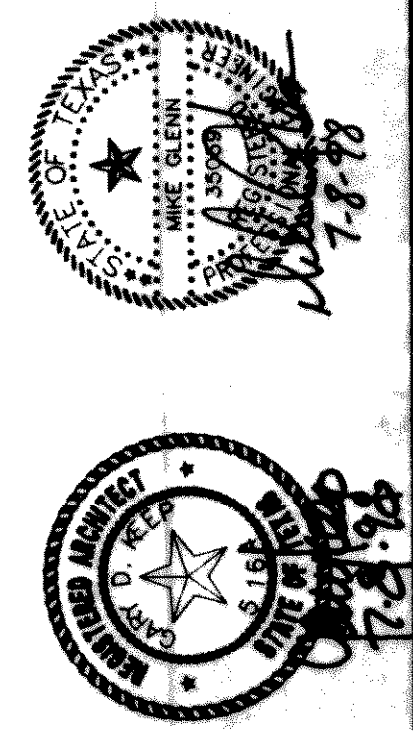

SHEET NUMBER: C
 OF 16: 2.4A
 SET NUMBER

GLENN ENGINEERING
 PHONE 214-770-8881 FAX 214-770-8880
 120 DECKER COURT - SUITE 250 FARGO, TEXAS 75046

WATER PLAN
 SCALE: 1"=40'

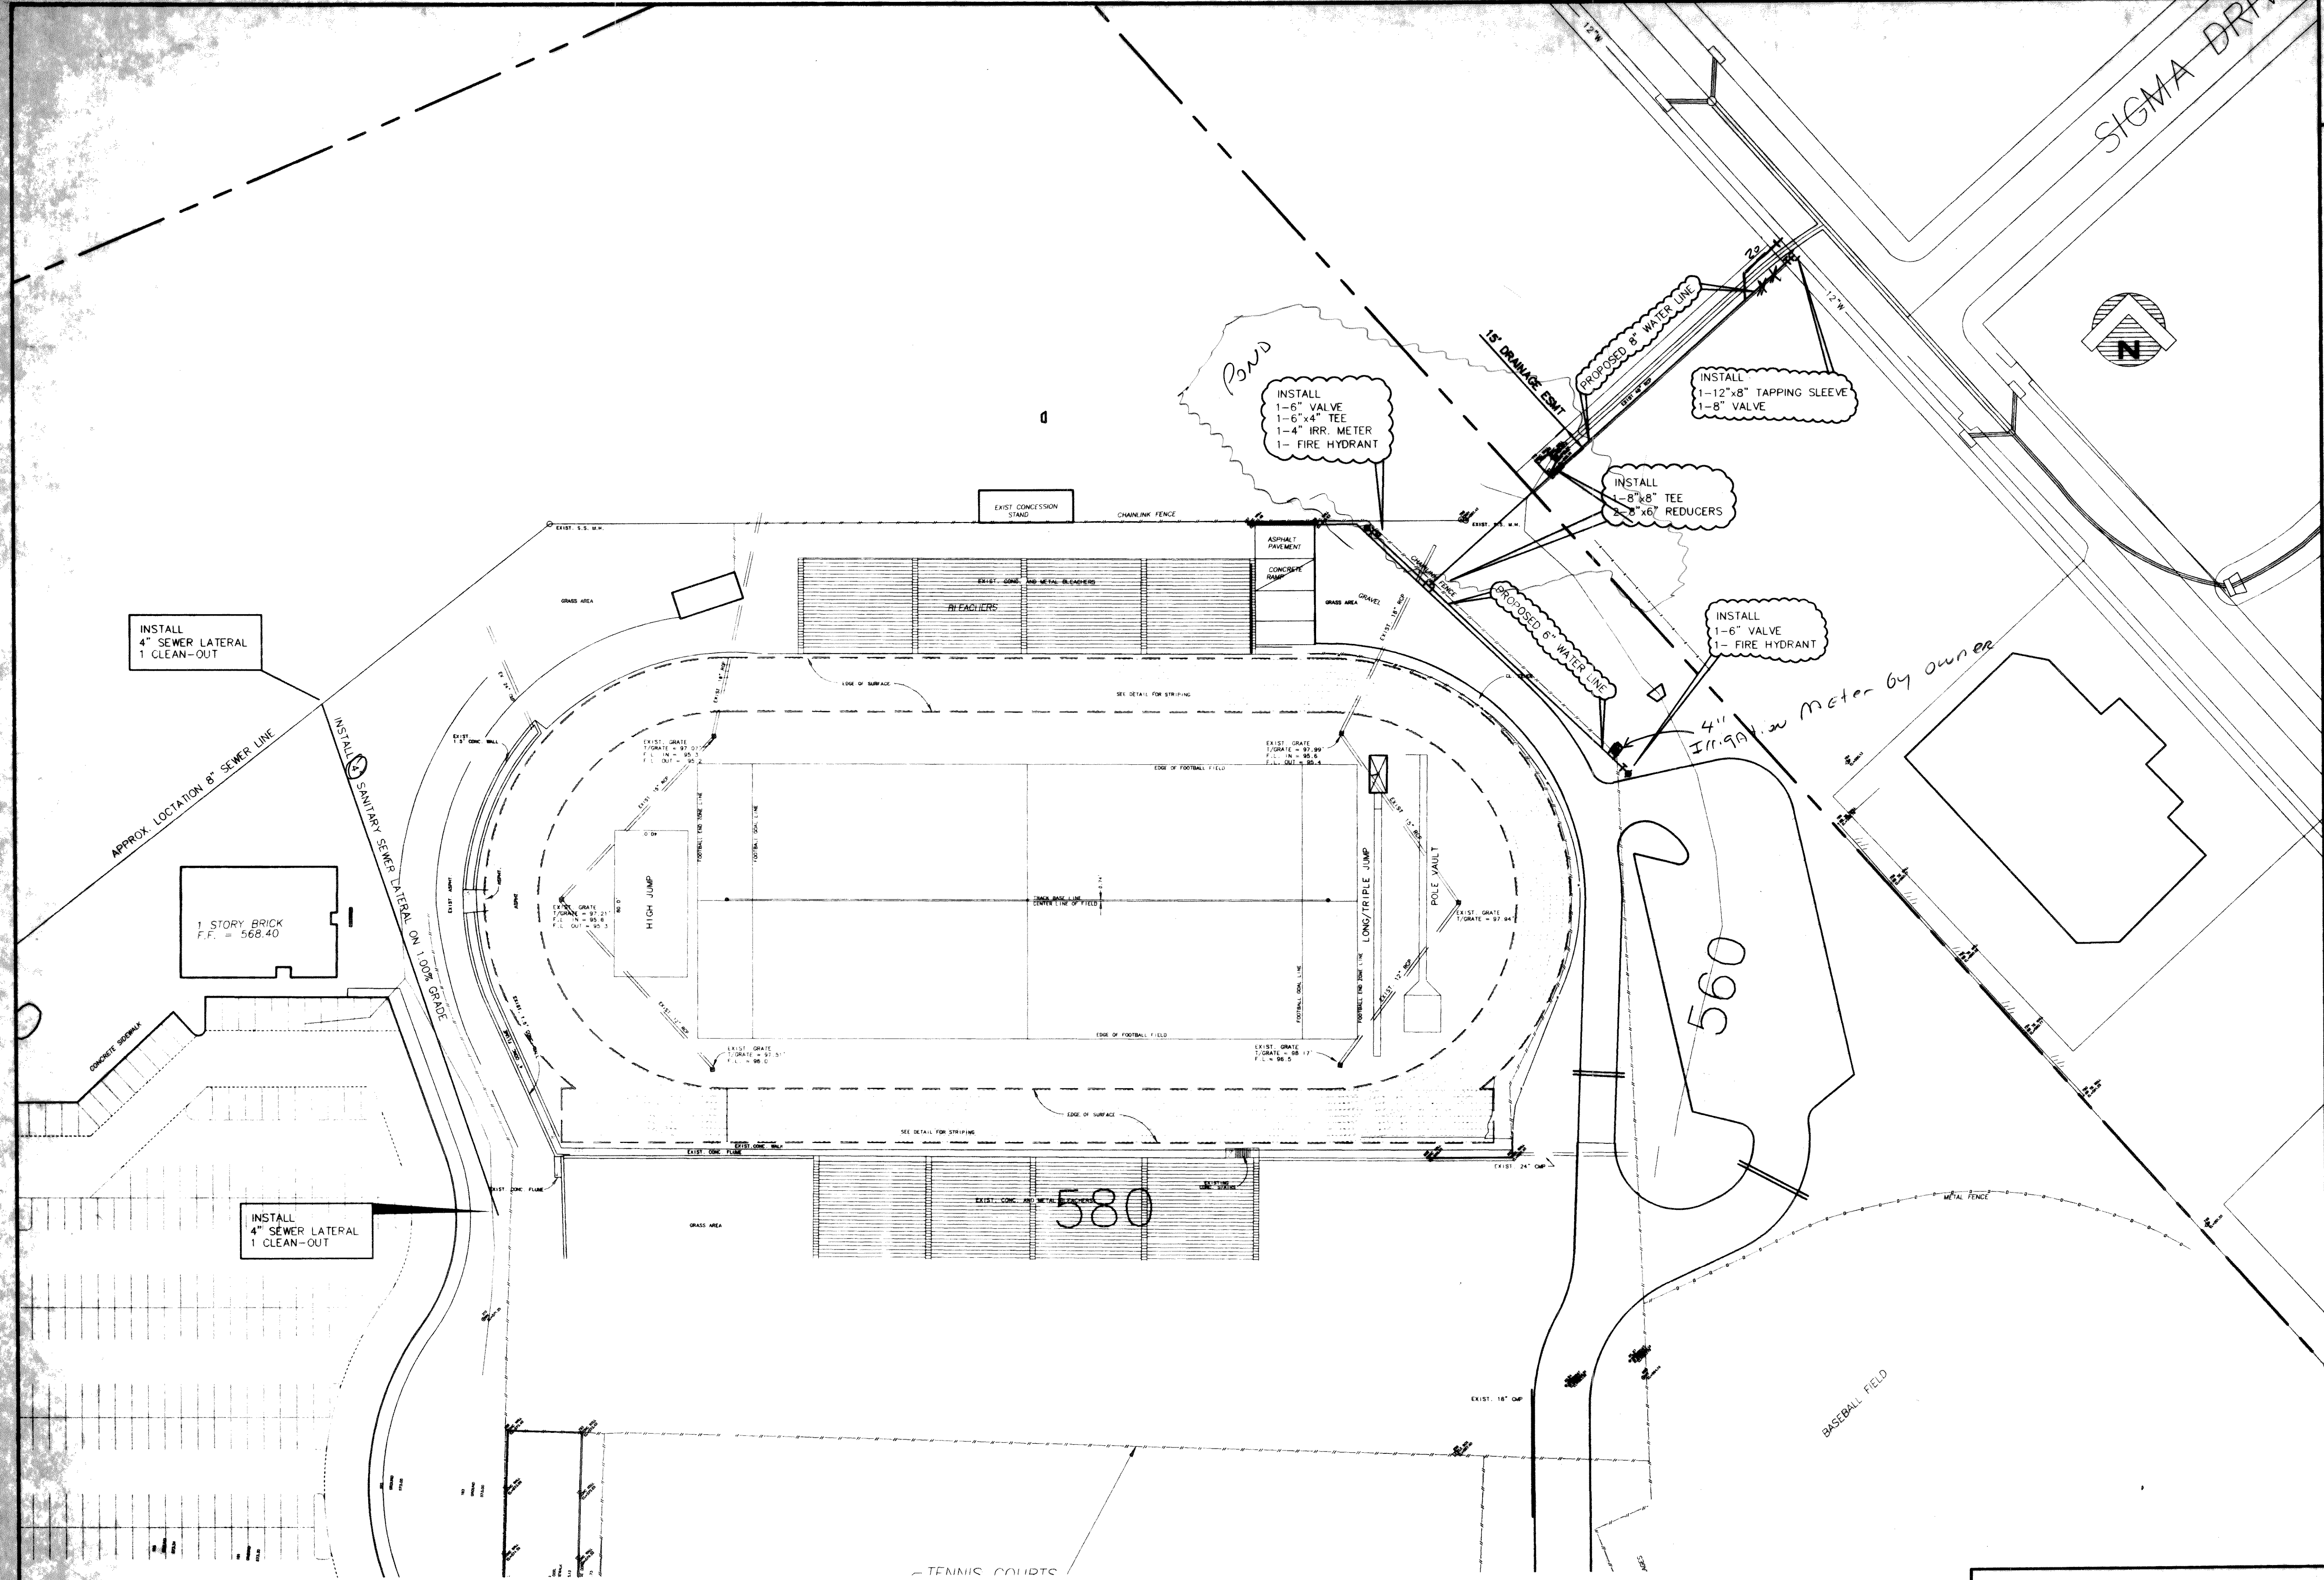

D. WOODS/WILEY/LURLEY-ENG. INC. REG. ALL. 08.17.48.57.1998 ROBERT-AT