
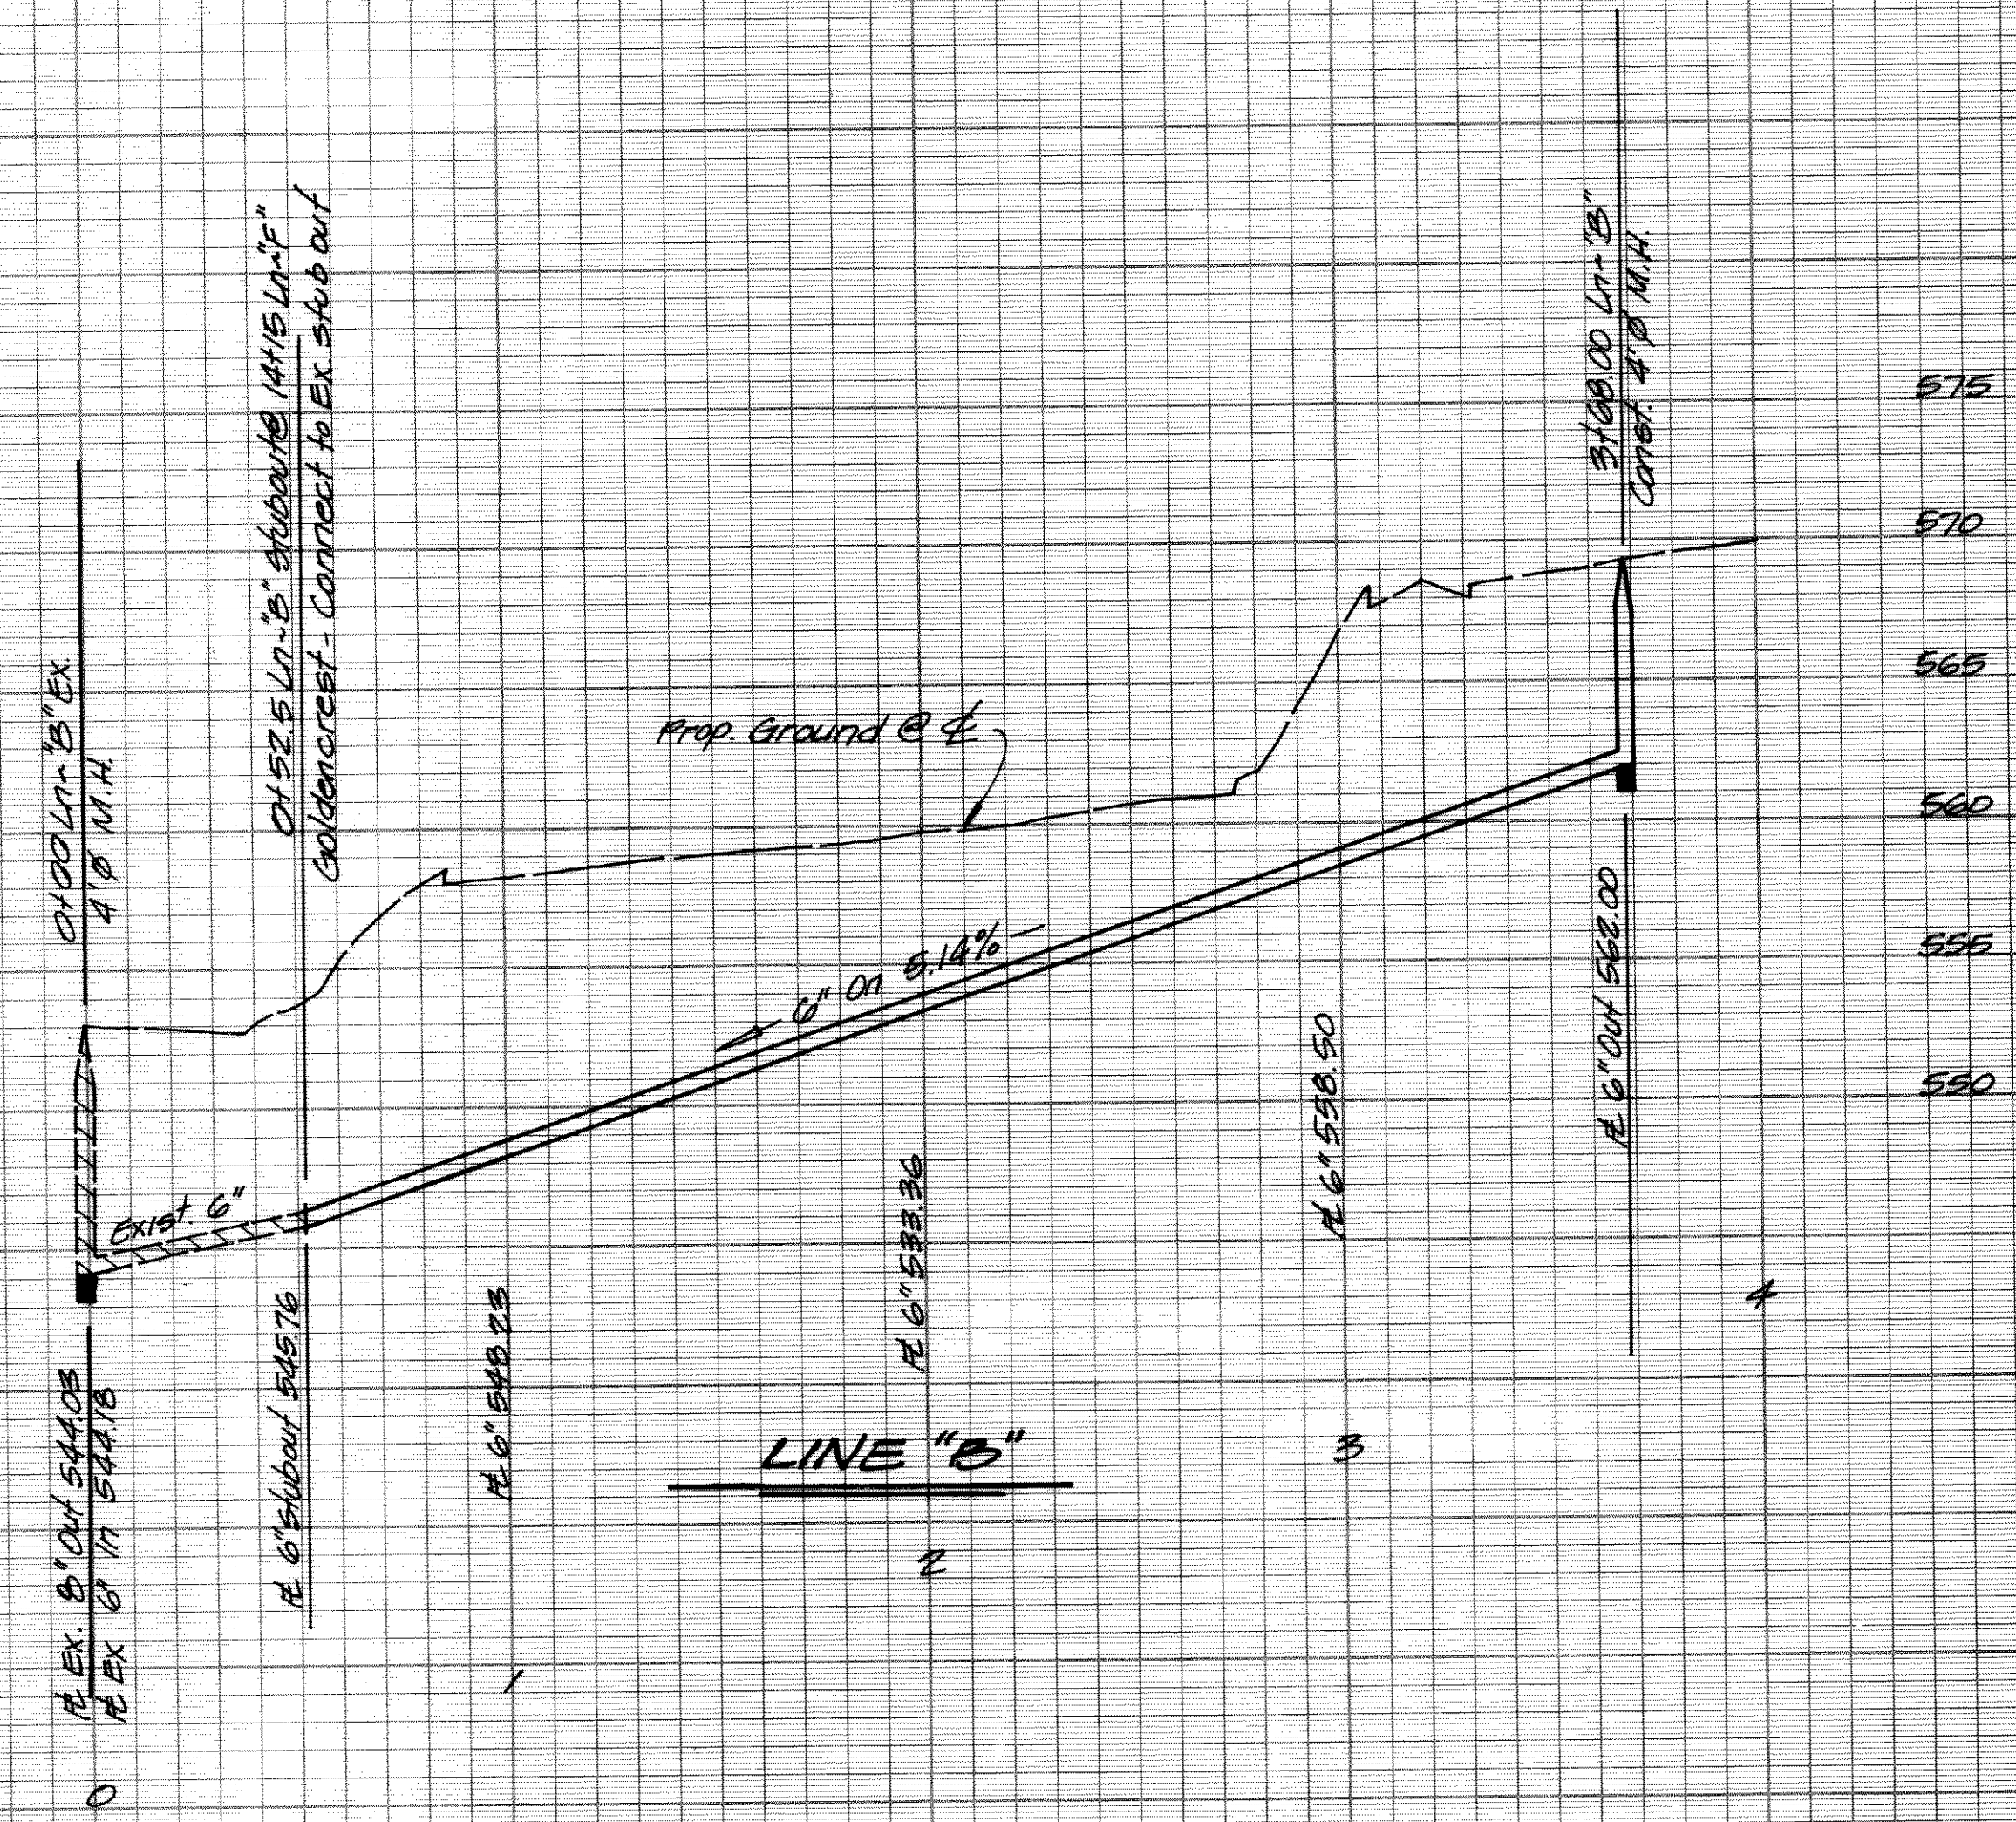
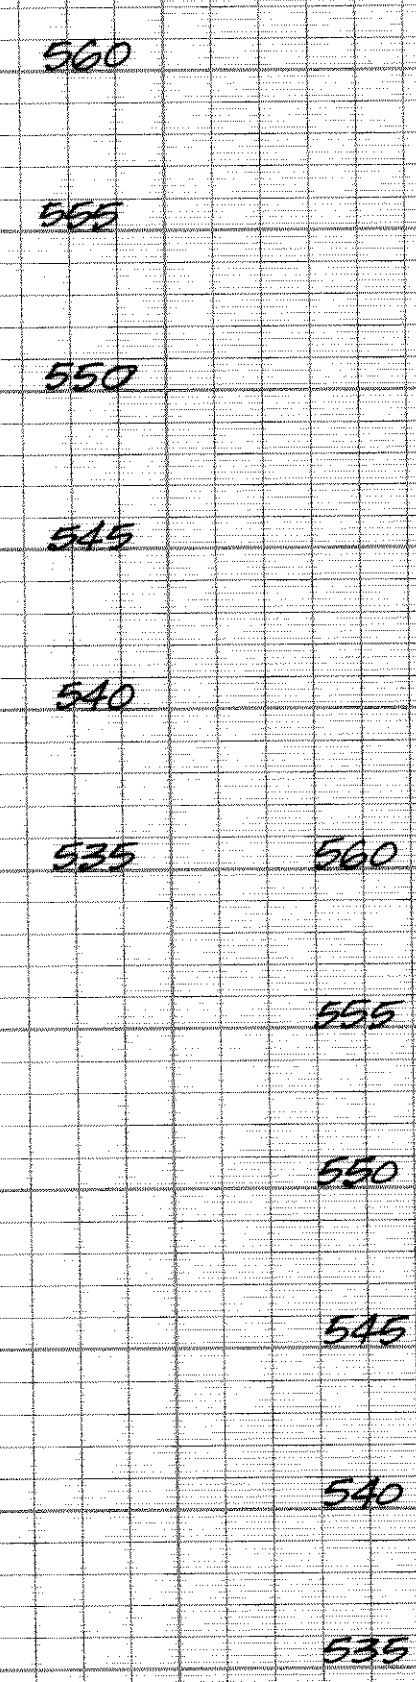
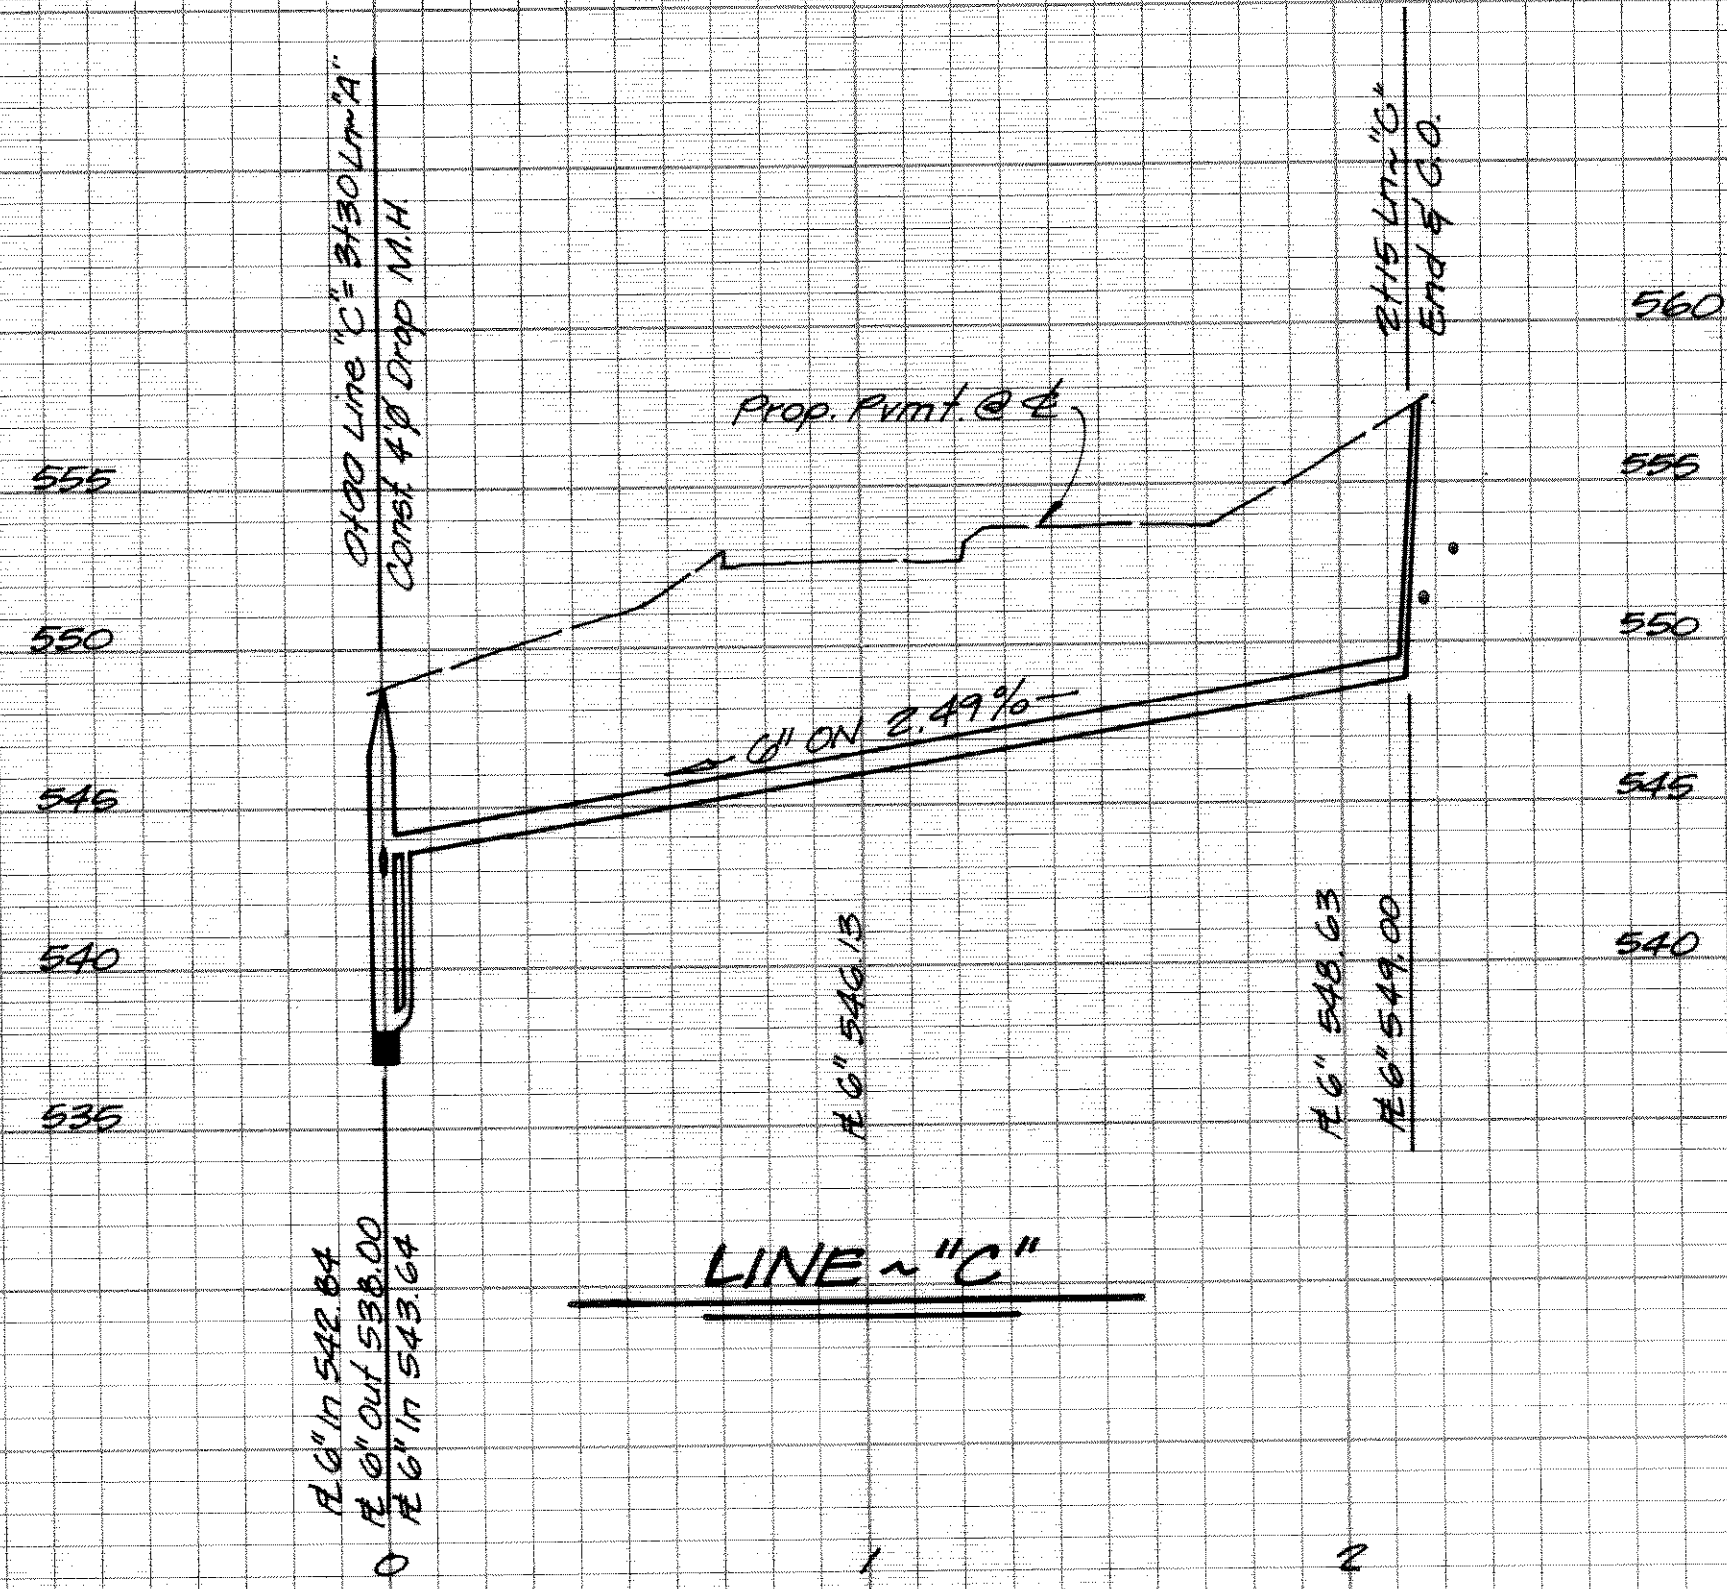


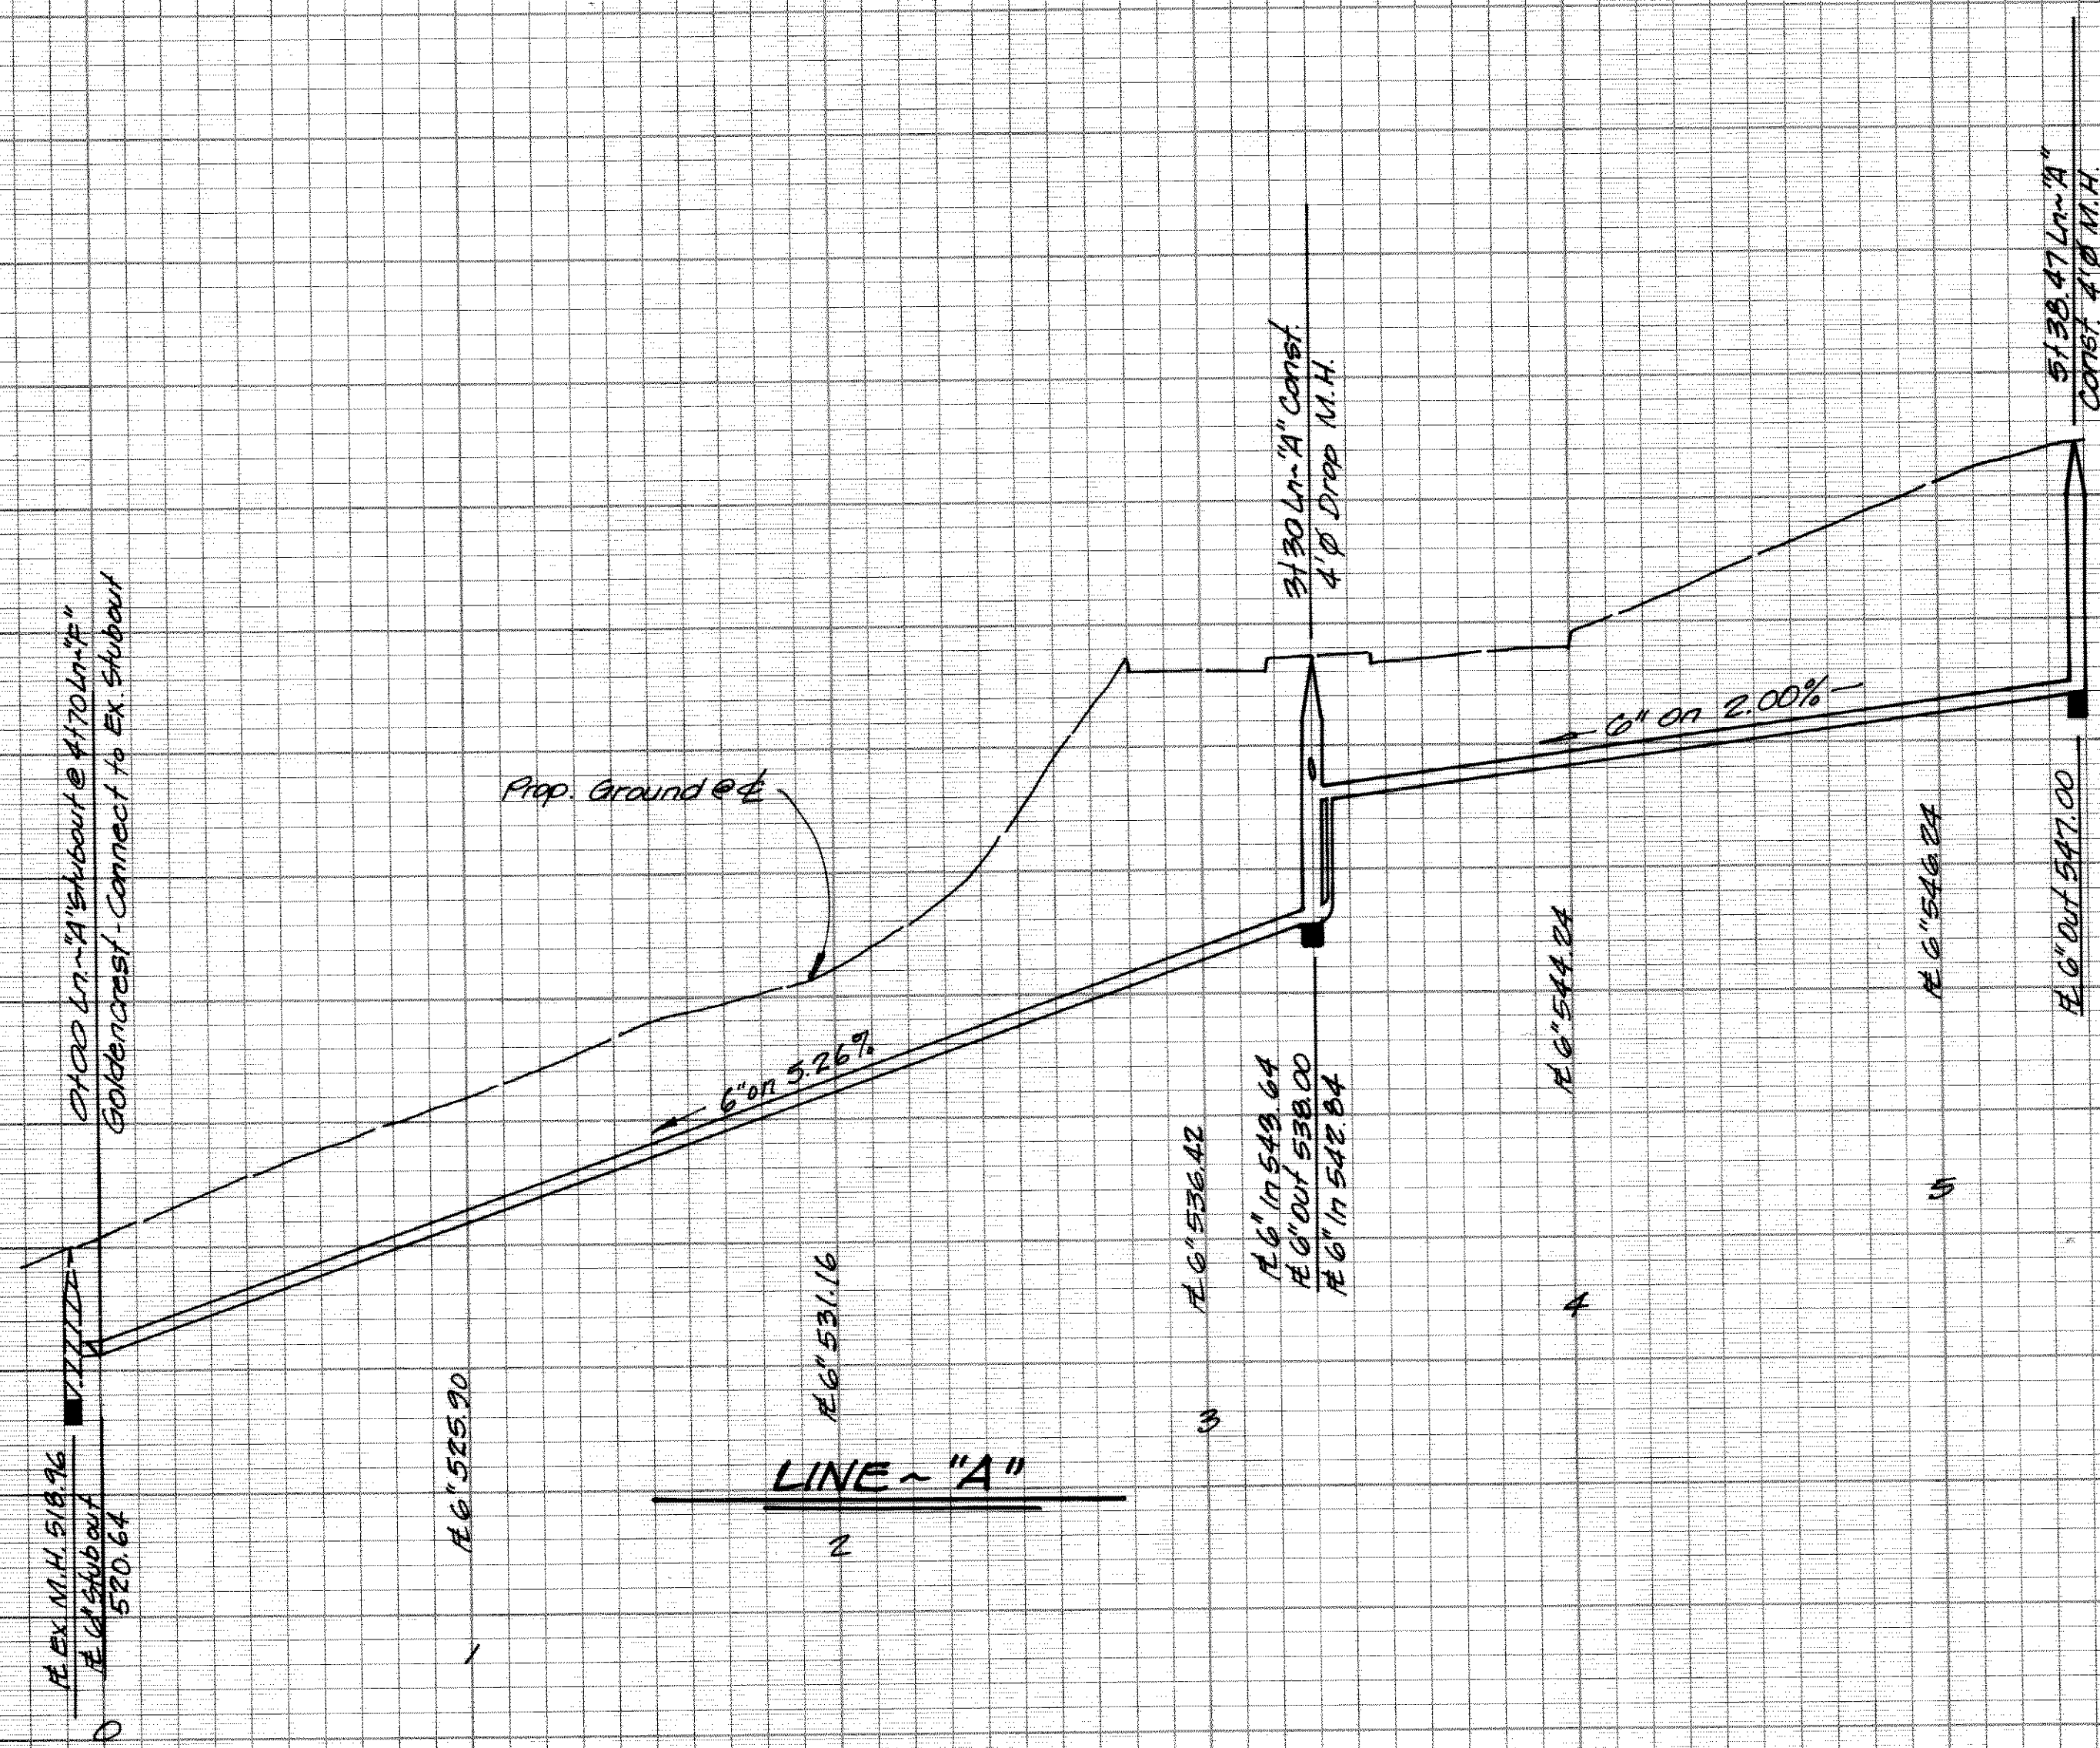

BENCH MARK:
 Top quartering nut of fire hydrant at the intersection of Yellowjacket Lane and Kyle Drive.
 Elev.: 529.26
 Centerline of a 15 foot inlet on the Southwest side of Greencrest Blvd. at the intersection of Greencrest Blvd. and Suncrest Drive.
 Elev.: 524.80

HAROLD L. EVANS CONSULTING ENGINEER 2331 GUS THOMASSON RD. SUITE 102 DALLAS, TEXAS 75228 PHONE (214) 328-8133			SANITARY SEWER PROFILES ROCKWALL HIGH SCHOOL ADDITION CITY OF ROCKWALL ROCKWALL COUNTY, TEXAS	
SCALE	DATE	JOB NO.		
1"=40' H&V	7-12-91	90134		