


MATCH LINE - SEE SHEET NO. 7/11

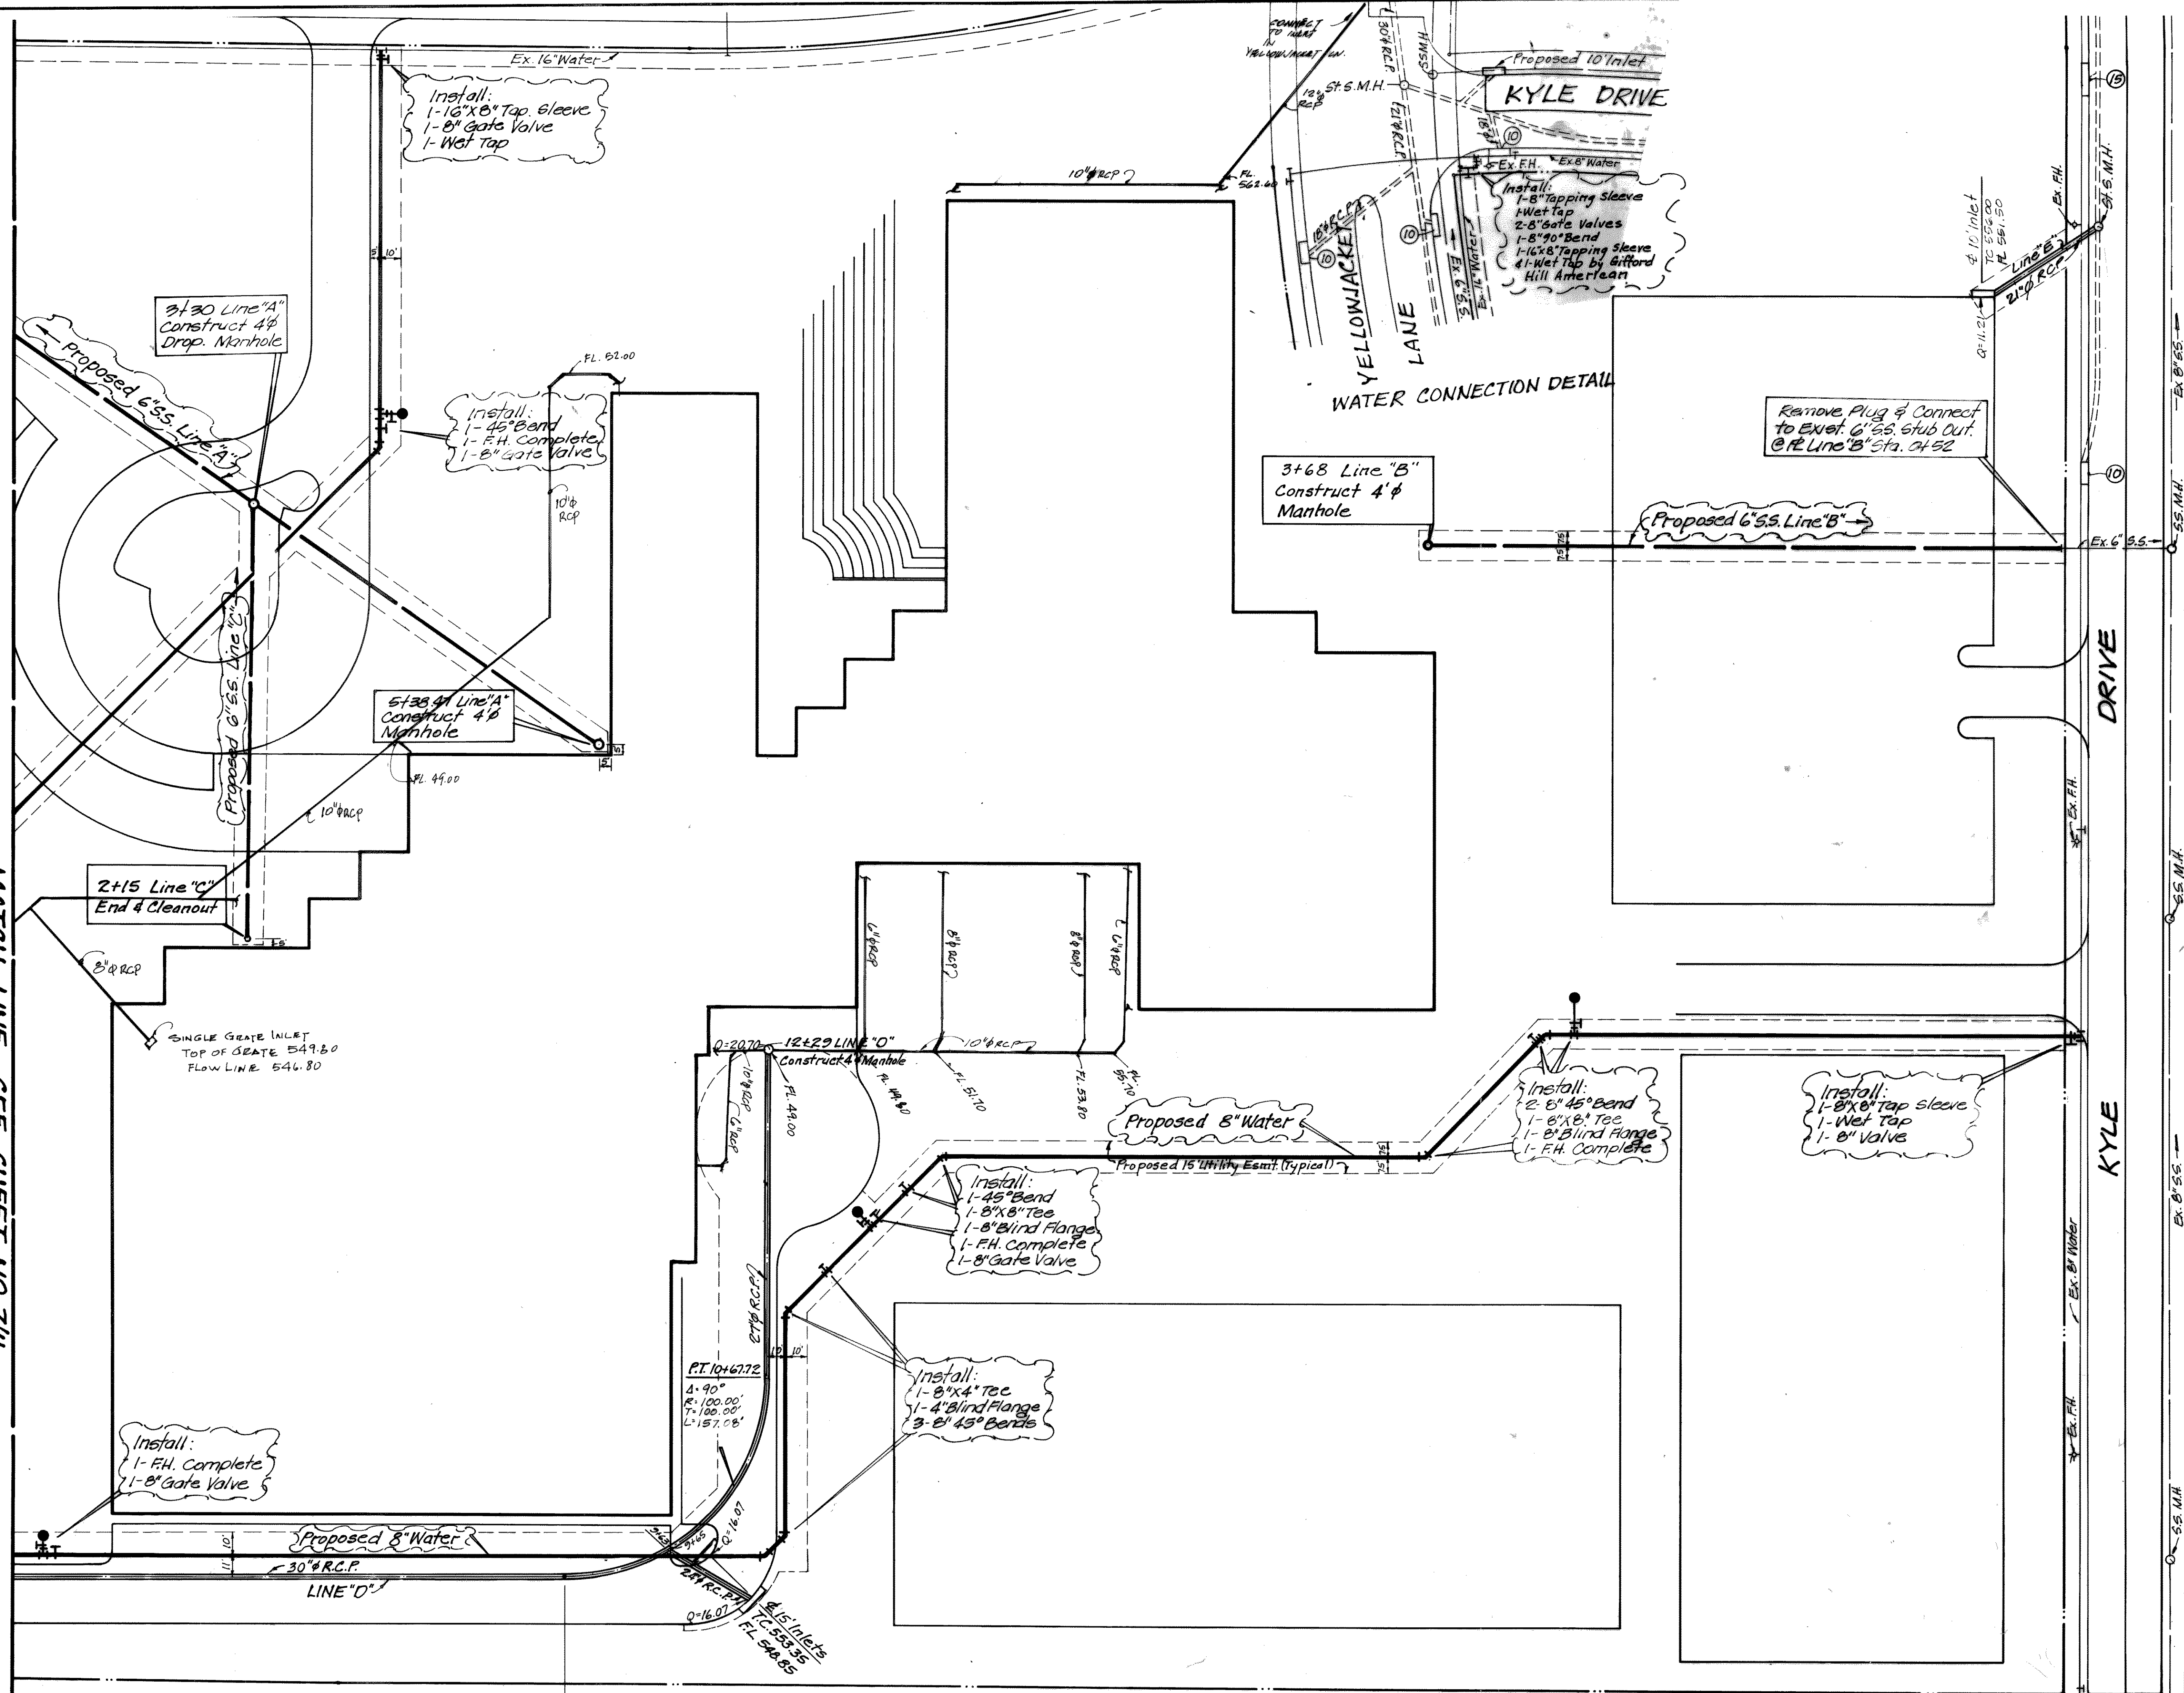

BENCH MARK:

Top operating nut of fire hydrant at the intersection of Yellowjacket Lane and Kyle Drive.
Elev: 529.26

Centerline of a 15 Foot inlet on the Southwest side of Greencrest Blvd. at the intersection of Greencrest Blvd. and Suncrest Drive.
Elev: 524.80

HAROLD L. EVANS CONSULTING ENGINEER		
2331 GUS THOMASSON RD. SUITE 102 DALLAS, TEXAS 75228		
PHONE (214) 328-8133		
SCALE	DATE	JOB NO.
1"=40'	7-12-91	90134

Rev. 8-07-91

WATER, SANITARY & STORM SEWER PLANS
ROCKWALL HIGH SCHOOL ADDITION
CITY OF ROCKWALL, ROCKWALL COUNTY, TEXAS

