

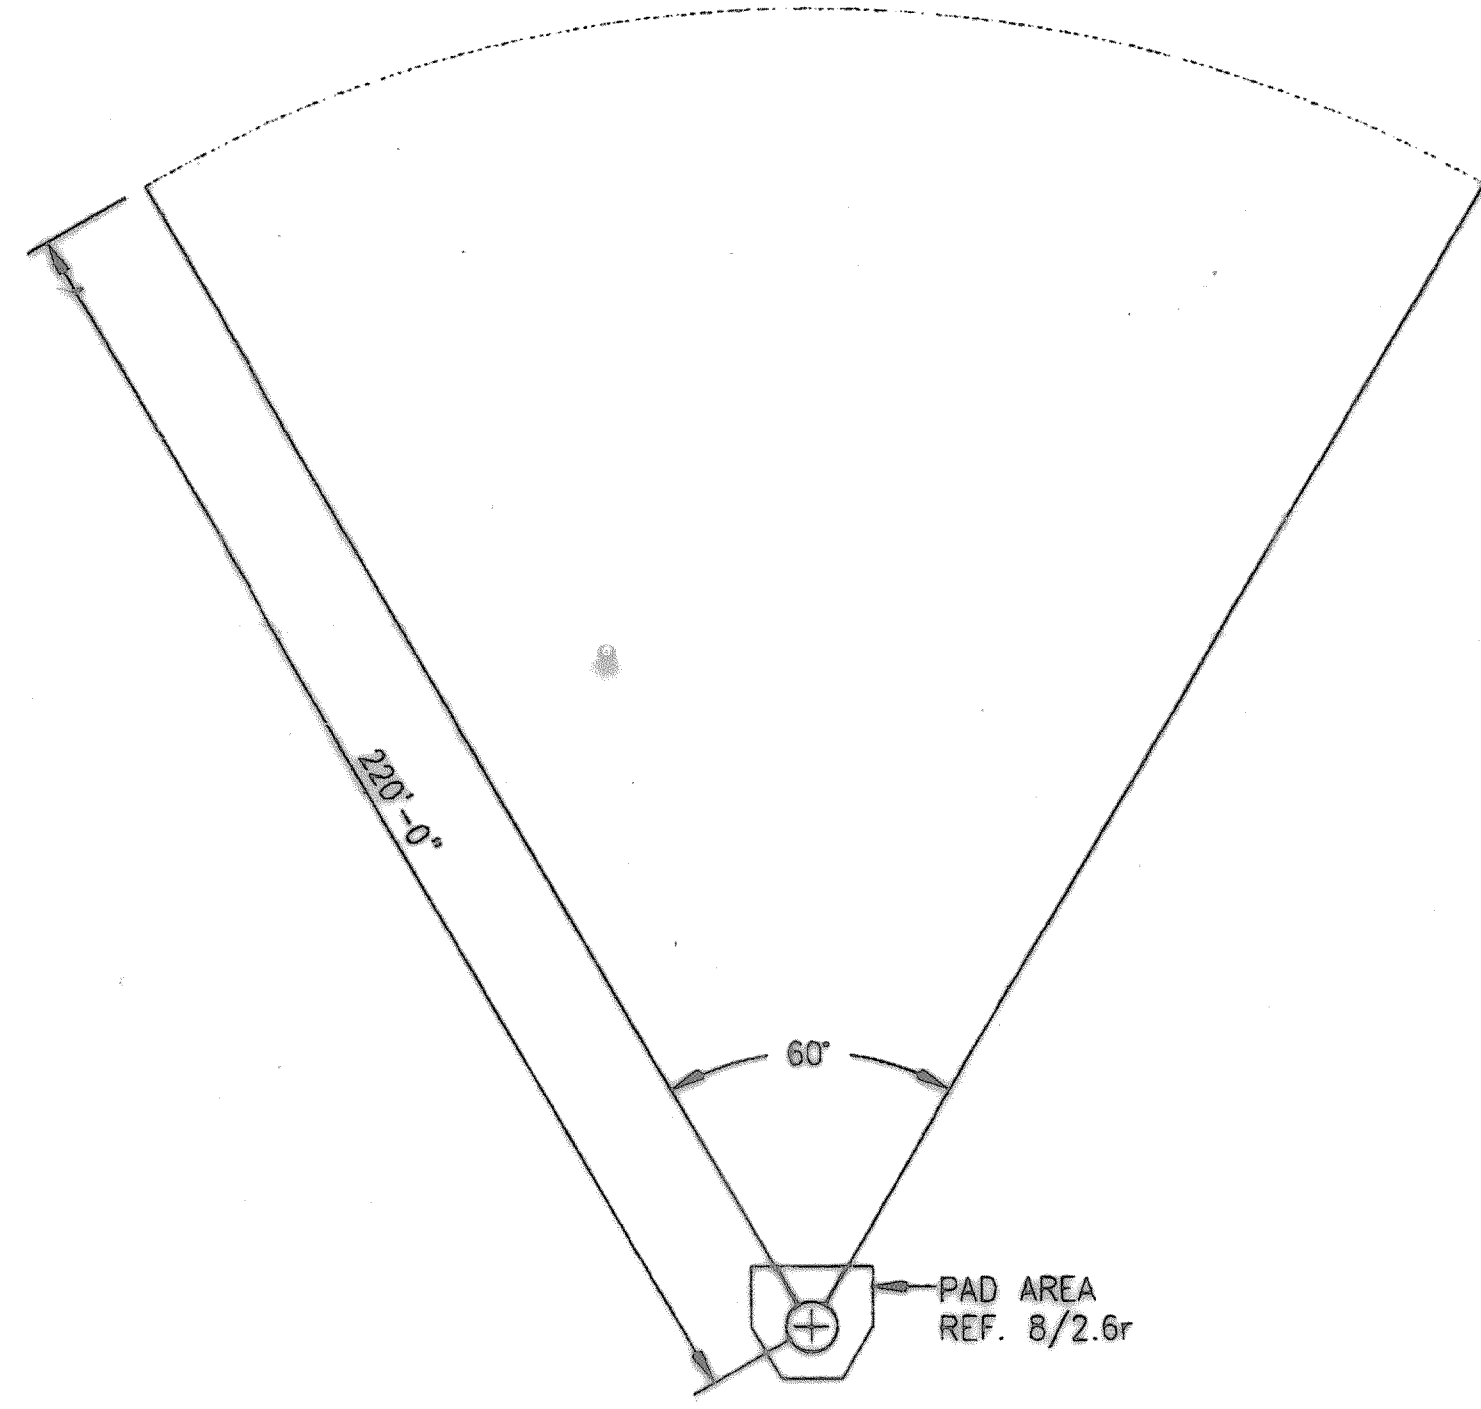



RHS2_gr.dwg 11-21-98 2:24:36 pmCST

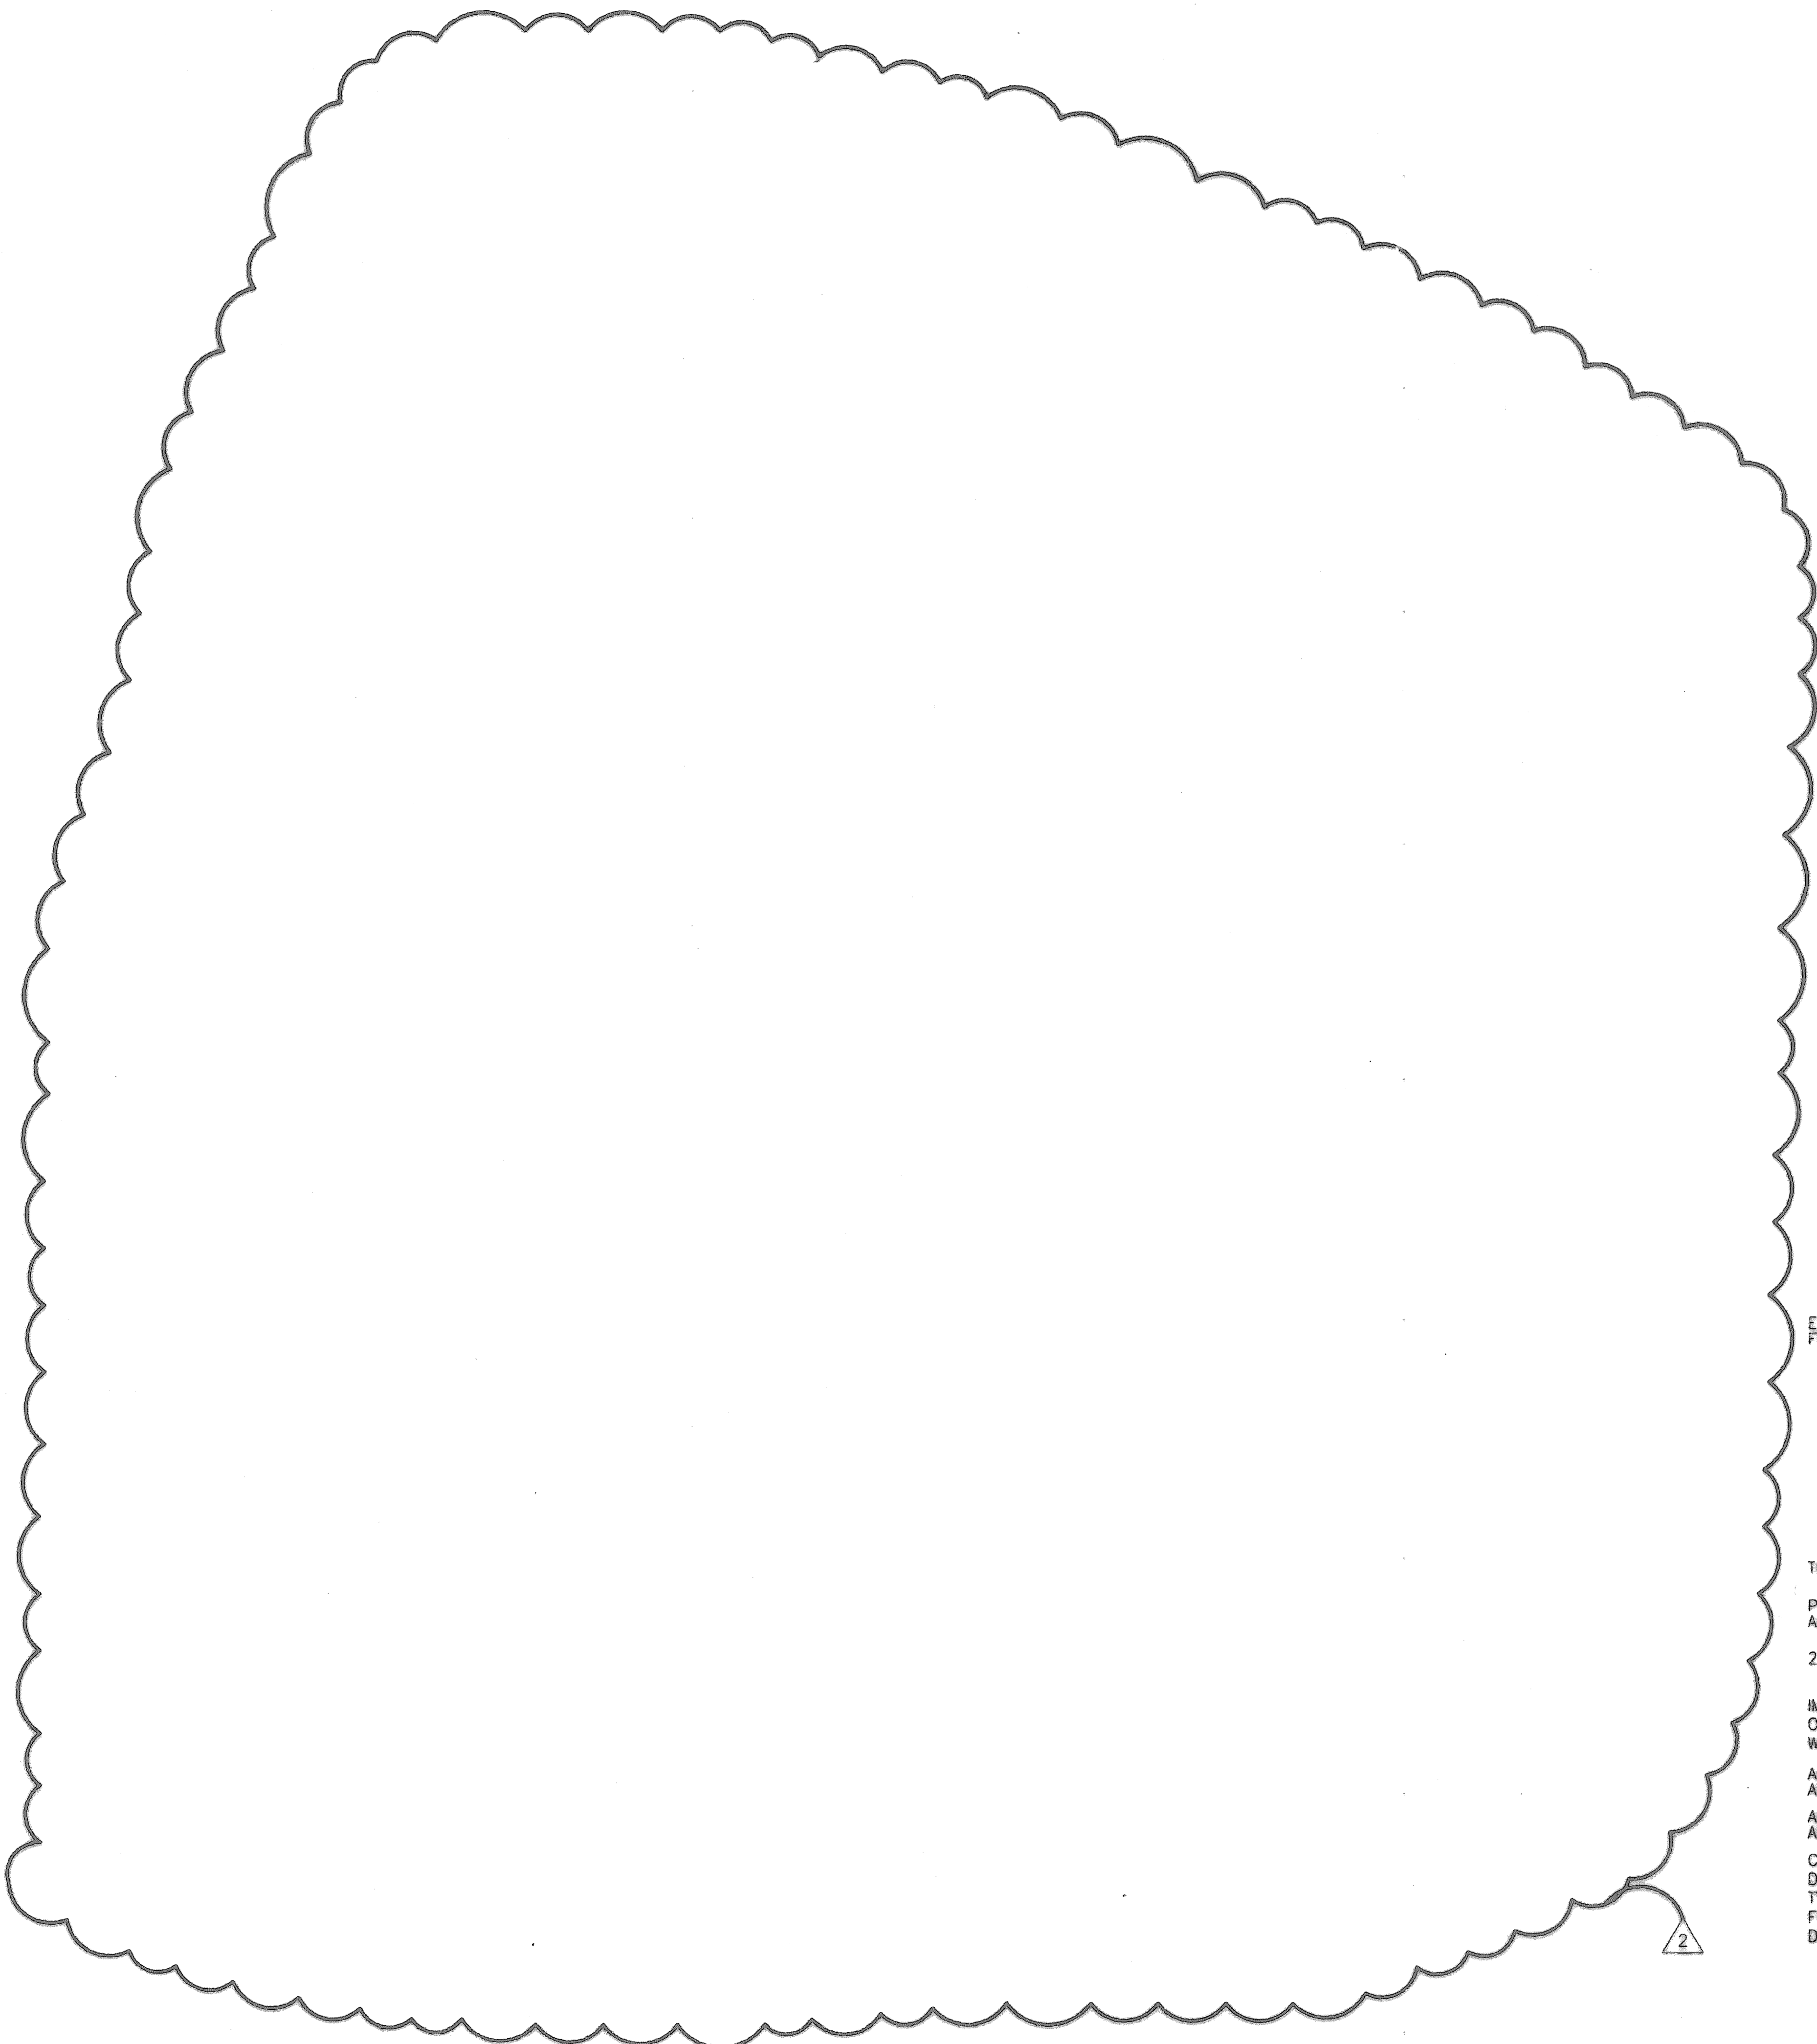

9 DISCUS AREA *OMIT*
2.6r 1/32"=1'-0"

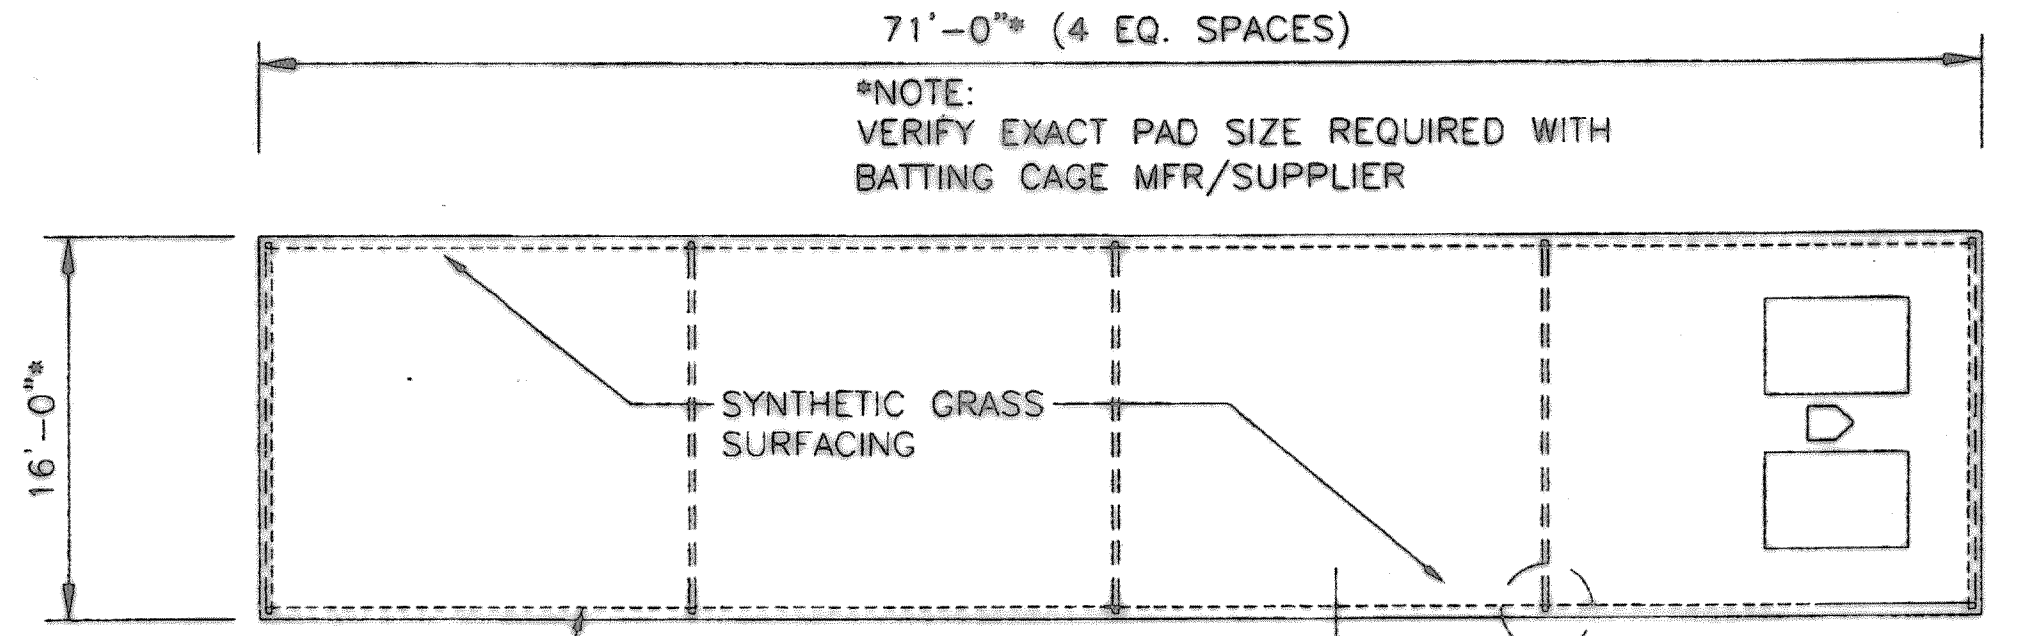

10 BATTING CAGE
2.6r 1/8"=1'-0"

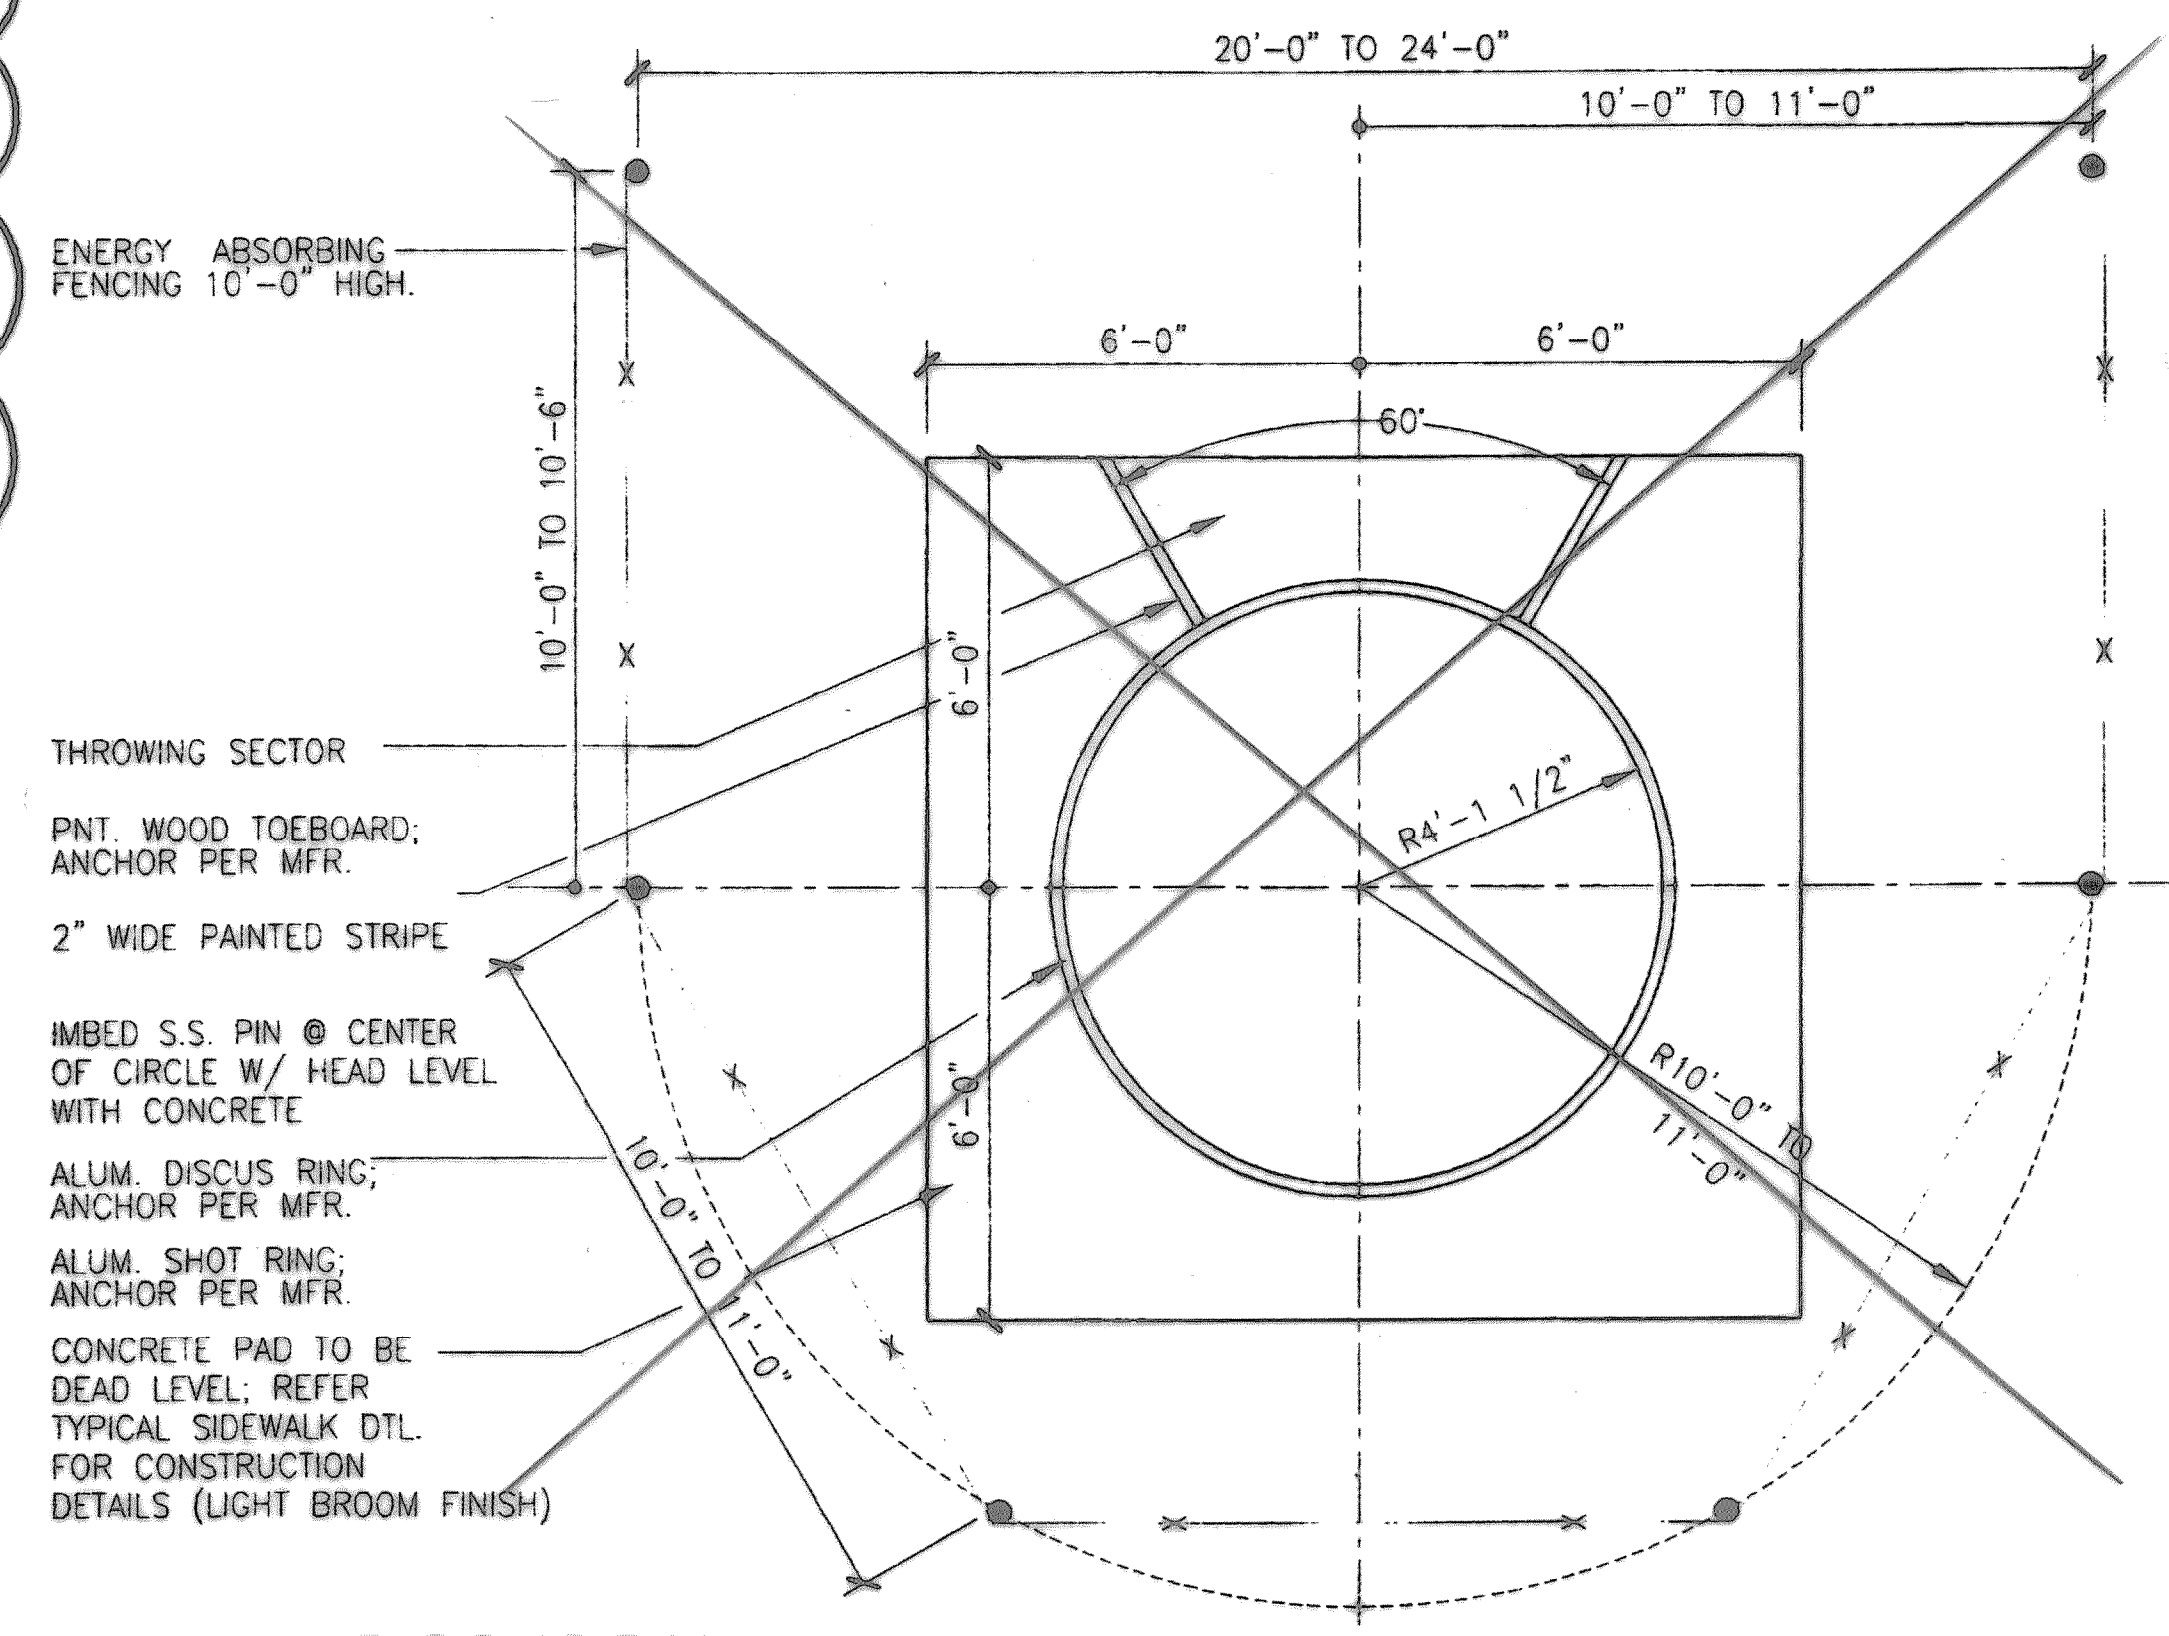


8 DISCUS PAD *OMIT*
2.6r 3/8"=1'-0"

DATE AUGUST 31, 1998
DRAWN BY GLF
CHECKED DJR
COMM NO 1499416
REVISED
NOV. 19, 1998

ROCKWALL HIGH SCHOOL ADDITIONS ROCKWALL INDEPENDENT SCHOOL DISTRICT ROCKWALL, TEXAS

FINAL PLANS FOR BIDDING AND CONSTRUCTION

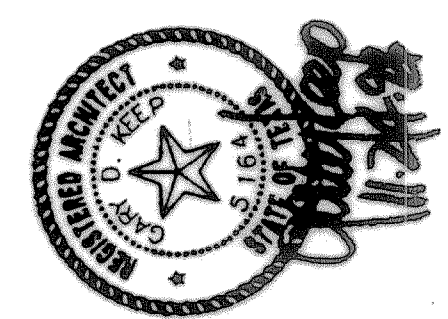

SHEET NUMBER C
OF 29 2.6r

SET NUMBER