

**SANITARY SEWER  
PROFILE**



SCALE: 1" = 5' V  
1" = 40' H



GLENN

PHONE 782-77-9181  
500 DICKER COURT - SUITE 200  
MINNIE, TEXAS 75082

SET NUMBER  
2.15f  
SHEET NUMBER  
19 OF 22  
C

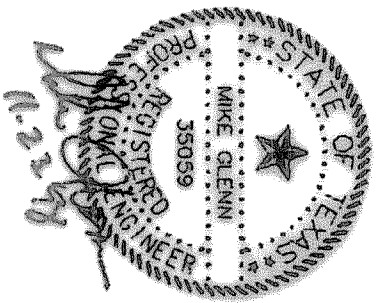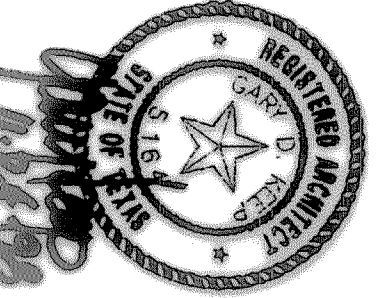

**ROCKWALL HIGH SCHOOL ADDITIONS  
ROCKWALL INDEPENDENT SCHOOL DISTRICT  
ROCKWALL,  
TEXAS**

DATE: 31 AUGUST, 1998  
DRAWN BY: JLV  
CHECKED: RAH  
CADD NO: 1498416  
DESIGNED: 19 NOV., 1998