


DATE: 31 AUGUST, 1998
 DRAWN BY: R.A.H.
 CHECKED: C.M.G.
 CDW NO: 0494453
 REVISED: 19 NOV., 1998
 3-20-1995

ROCKWALL HIGH SCHOOL ADDITIONS
ROCKWALL INDEPENDENT SCHOOL DISTRICT
ROCKWALL, TEXAS

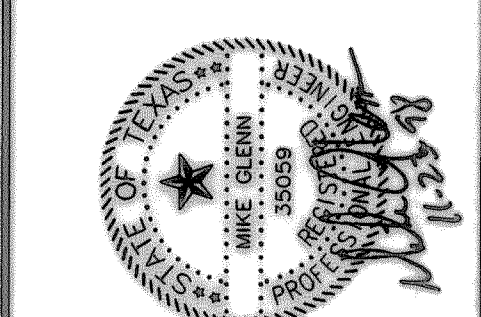

DINING ADDITION
UNDERFLOOR GRADING PLAN
 Scale 1" = 20'

GLENN ENGINEERING
 PHONE 972-717-5531 FAX 972-718-4229
 100 DECKER COURT - SUITE 200 IRVING, TEXAS 75062

SHEET NUMBER	C
27 OF 29	2.34r
SET NUMBER	