

ROCKWALL HIGH SCHOOL RENOVATIONS FOR ROCKWALL HIGH SCHOOL ROCKWALL I.S.D. 901 YELLOW JACKET LN, ROCKWALL, TX 75087


Copyright © 2016, Huckabee & Associates, Inc.

ADDENDUM #1
PC - REMOVE STORM FLUME AND PARKING
PC - REMOVED STORM SEWER

Date
11/22/2016
09/11/2017
12/04/2017

Revision /
1
2
3

Project:
ROCKWALL HIGH SCHOOL RENOVATIONS
FOR
ROCKWALL HIGH SCHOOL
ROCKWALL I.S.D.
901 YELLOW JACKET LN, ROCKWALL, TX 75087

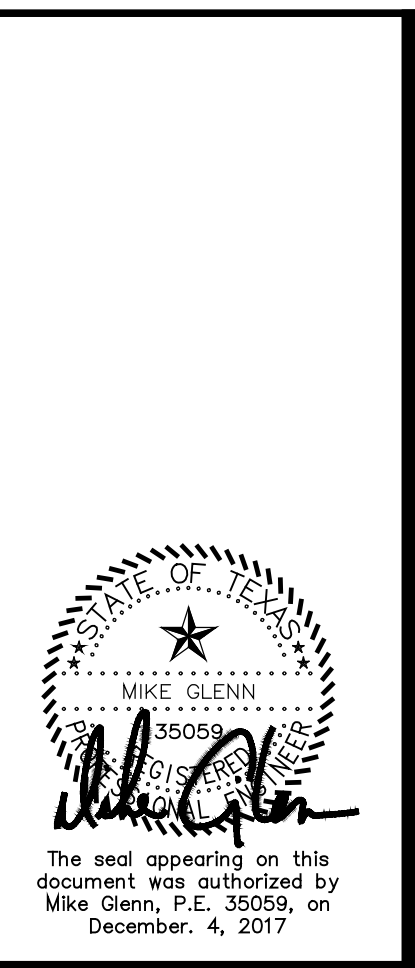

CIVIL COVER SHEET

100% CD VOLUME


Job No. 1738-02-01 Sheet No. C 1.0

Drawn By: RAH

Date: 12-03-2016

TABLE OF CONTENTS

SHEET #	TITLE
C 1.0	COVER SHEET
C 1.1	TOPOGRAPHIC SURVEY
CD 1.0	DEMOLITION PLAN
CS 1.0	OVERALL SITE PLAN
CS 1.1	WALL SITE PLAN
CS 1.2	PARKING SITE PLAN
CS 1.3	RAMP SITE PLAN
CS 1.4	RAMP DETAILS
RETAINING WALL DETAILED SHOP DRAWINGS	
R1	TITLE PAGE
R2	WALL LAYOUT PAGE
R3	WALL ELEVATIONS
R4	WALL ELEVATIONS
R5	DETAILS
R6	DETAILS (CONTINUED)
R7	COMPONENTS
R8	GENERAL NOTES
CG 1.0	RAMP GRADING PLAN
CG 1.1	EXISTING DRAINAGE AREA MAP
CG 1.1A	PROPOSED DRAINAGE AREA MAP
CG 1.2	SWPPP PLAN
CG 1.3	SWPPP DETAILS
CG 1.4	SWPPP DETAILS
CP 1.0	PAVING PLAN
CP 1.1	PAVING DETAILS 1
CP 1.2	PAVING DETAILS 2

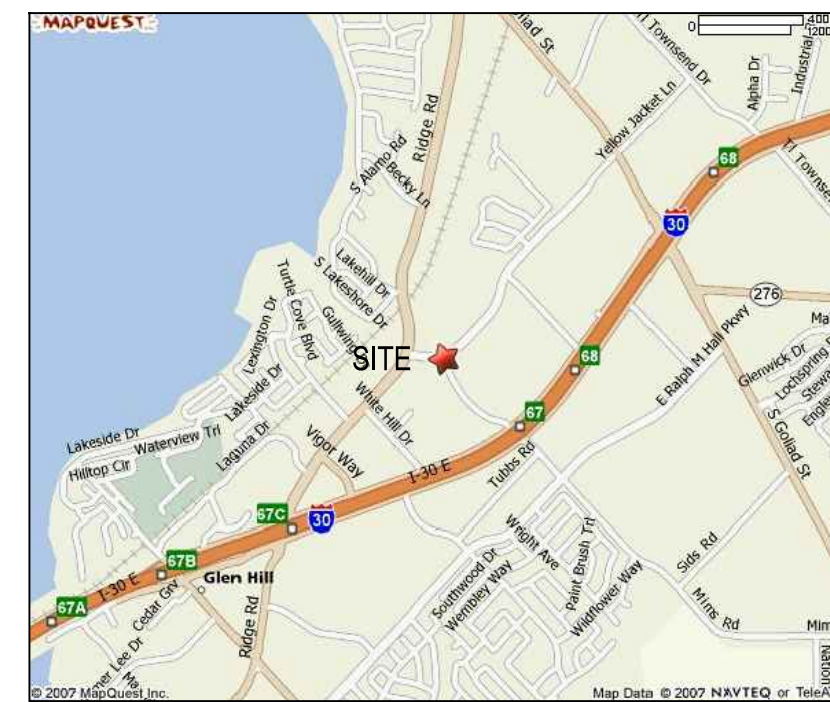

LOCATION MAP
NTS

GENERAL NOTE:

CONTRACTOR TO UTILIZE CITY APPROVED CONSTRUCTION PLANS FOR CONSTRUCTION OF ALL CIVIL RELATED FACILITIES. CONTRACTOR TO NOTIFY ARCHITECT/ENGINEER IMMEDIATELY OF ANY COST DISCREPANCIES BETWEEN THE CITY APPROVED SET AND BID SET WITH LATEST ADDENDUMS.

OWNER

ROCKWALL I.S.D.
1050 WILLIAMS STREET
ROCKWALL, TEXAS 75087
972-771-0605

ARCHITECT

HUCKABEE
4521 S HULEN STREET, SUITE 220
FORT WORTH, TEXAS 76109
(817) 377-2969

NOVEMBER 2016

ENGINEER

GLENN ENGINEERING
105 DECKER COURT, SUITE 910
IRVING, TEXAS 75062
(972) 717-5151

RECORD DRAWING

This is to certify that changes and corrections have been made to conform to the contractor's record of this project.

Signed: *Mike Glenn* Date: March 28, 2018
Glenn Engineering Corporation

GLENN ENGINEERING

TEXAS REGISTRATION NUMBER: F-303
PHONE 972-717-5151 FAX 972-717-2176
105 DECKER COURT, SUITE 910
IRVING, TEXAS 75062

Plotted: Apr 20, 2018, 8:53 AM by user: robert - Saved: 4/15/2018 by user: robert
D:\Public\Bobs Projects\ROCKSDHigh-School\2016 WALL REPAIR\BIDSET\2016 ROCKWALL-HS ENG5 REV STORM FLUME.dwg