


LEGEND

- (558.00) = PROPOSED TOP OF CURB
- (558.00 TP) = PROPOSED TOP OF PAVEMENT
- (558.00 TI) = PROPOSED TOP OF INLET
- (558.00 TR) = PROPOSED TOP OF INLET
- (558) = PROPOSED CONTOUR
- FF=558.00 = PROPOSED FINISH FLOOR
- - - = PROPOSED LANDSCAPE BERM
- = DIRECTION OF FLOW
- (558.00 GR) = EXISTING SHOT
- - - (558) = EXISTING CONTOUR

NOTE:
SEE SHEET R1- R8 DETAILED
RETAINING WALL DRAWINGS

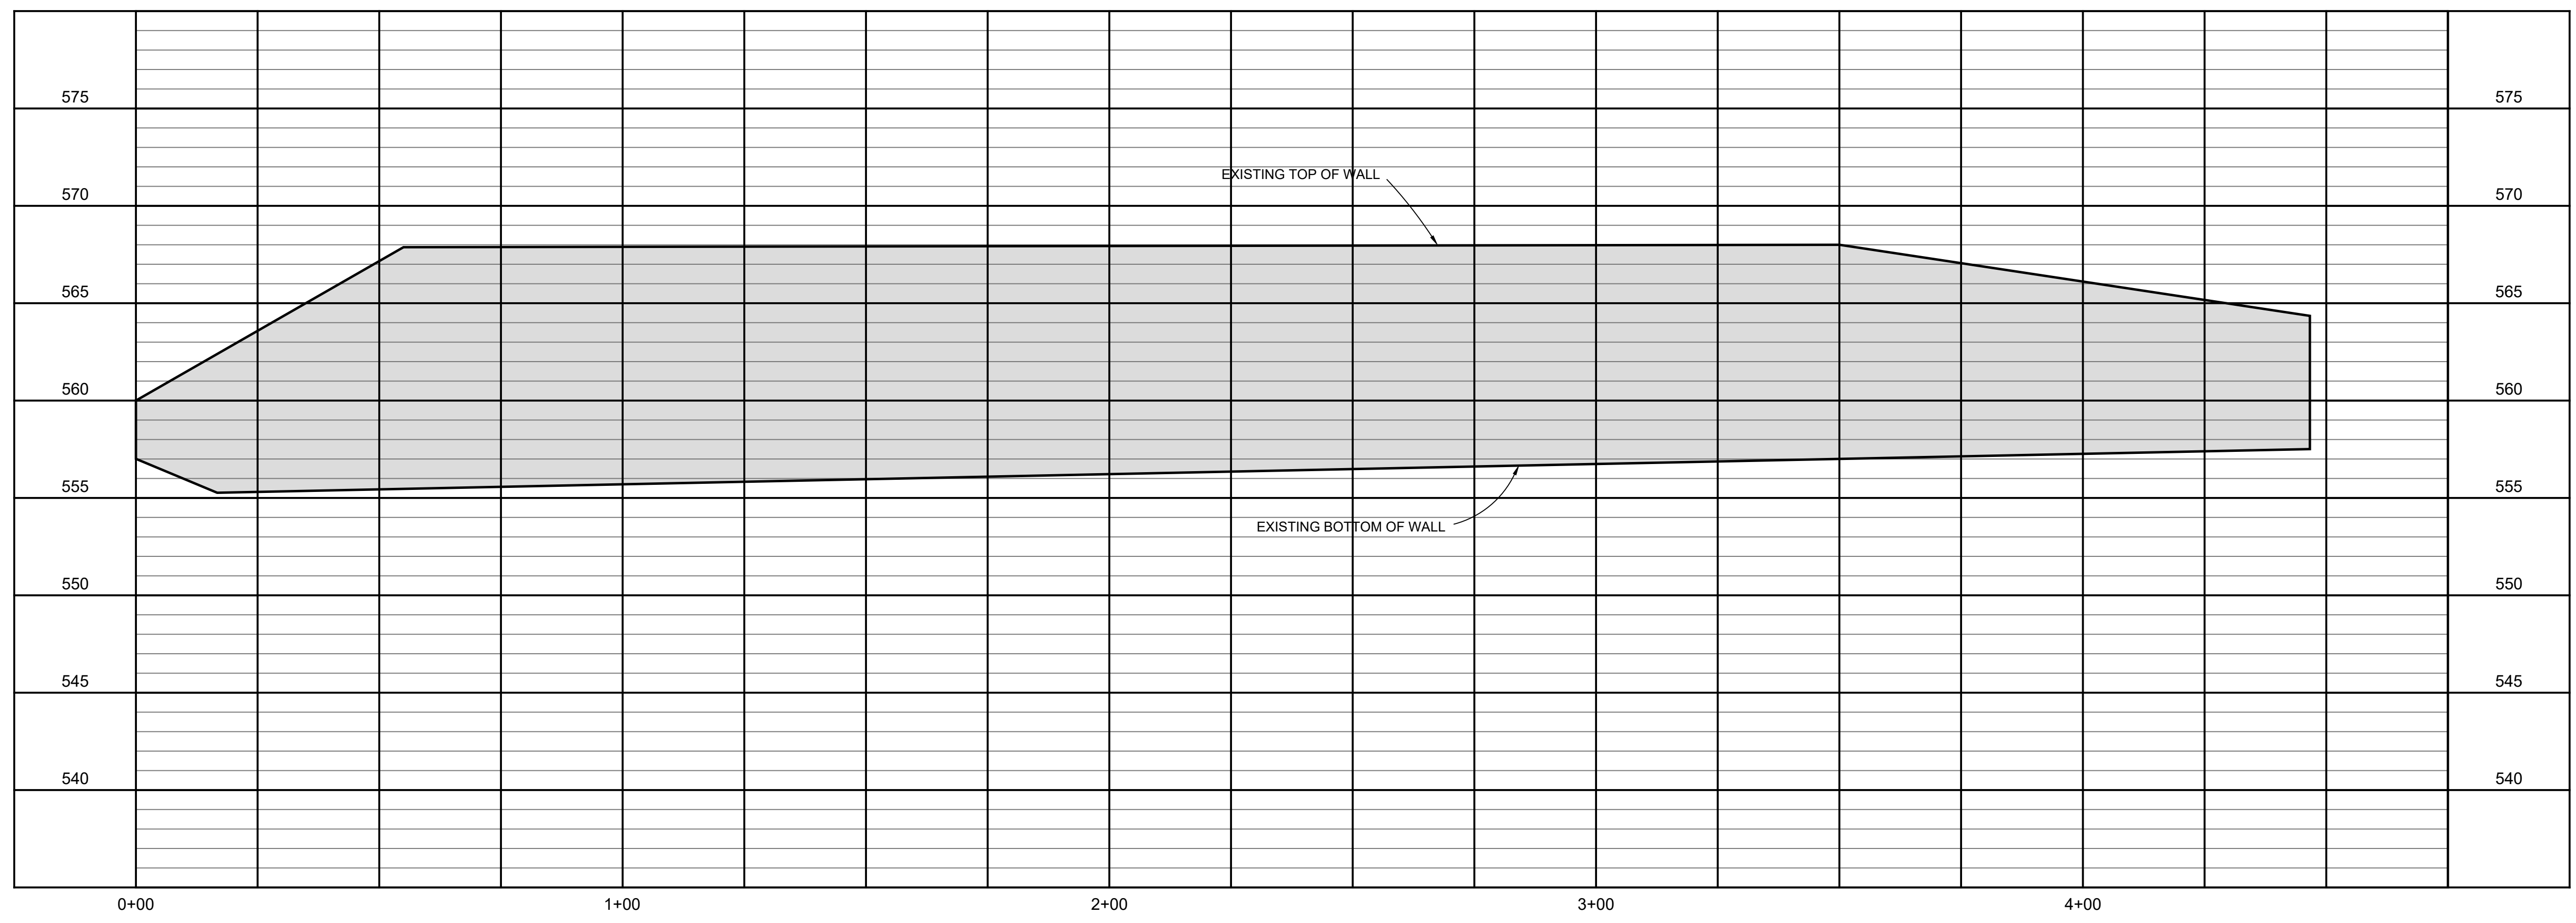

NOTE:
SEE SHEET R1- R8 DETAILED
RETAINING WALL DRAWINGS

RECORD DRAWING
This is to certify that changes and corrections have been made to conform to the contractor's record of this project.
Signed: *Mike Glenn* March 28, 2018
Date: _____
Glenn Engineering Corporation

GLENN ENGINEERING
TEXAS REGISTRATION NUMBER: F-303
PHONE 972-717-5151 FAX 972-717-2176
105 DECKER COURT, SUITE 910
IRVING, TEXAS 75062

ADDENDUM #1
PC - REMOVED STORM FLUME AND PARKING
PC - REMOVED STORM SEWER

Date
11/22/2016
09/11/2017
12/04/2017

Revision /
1
2
3

Project:
**ROCKWALL HIGH SCHOOL RENOVATIONS
FOR
ROCKWALL HIGH SCHOOL
ROCKWALL I.S.D.
901 YELLOW JACKET LN, ROCKWALL, TX 75087**

STATE OF TEXAS
MIKE GLENN
35089
Mike Glenn
The seal appearing on this document was authorized by Mike Glenn, P.E., 35089, on December 4, 2017.

Huckabee
AUSTIN • DALLAS • FORT WORTH • HOUSTON • WACO
www.huckabee-inc.com
800.687.1229

DETAILED
RETAINING WALL
SITE PLAN
100% CD VOLUME

Job No.
1738-02-01
Sheet No.
CS
1.1

Drawn By:
RAH
Date:
12-03-2016