

- GENERAL NOTES:**
1. STRIPING & SIGNAGE DIMENSIONS ARE FROM FACE OF CURB
 2. ALL FIRE LANES, PARKING STRIPING, HDOP PARKING STRIPING & SIGNAGE ARE TO BE IN ACCORDANCE WITH CITY OF ROCKWALL REQUIREMENTS, TYP.
 3. PRIOR TO ANY CONSTRUCTION THE CONTRACTOR SHALL FAMILIARIZE HIMSELF WITH THE CONTRACT DOCUMENTS AND SPECIFICATIONS, THE PLANS INCLUDING ALL NOTES, THE CITY OF ROCKWALL SPECIFICATIONS AND ANY OTHER APPLICABLE STANDARDS OR SPECIFICATIONS RELEVANT TO THE PROPER COMPLETION OF THE WORK SPECIFIED. FAILURE ON THE PART OF THE CONTRACTOR TO FAMILIARIZE HIMSELF WITH ALL STANDARDS OR SPECIFICATIONS PERTAINING TO THIS WORK SHALL IN NO WAY RELIEVE THE CONTRACTOR OF RESPONSIBILITY FOR PERFORMING THE WORK IN ACCORDANCE WITH ALL SUCH APPLICABLE STANDARDS AND SPECIFICATIONS.
 4. CONTRACTOR SHALL HAVE IN HIS POSSESSION, PRIOR TO CONSTRUCTION, ALL NECESSARY PERMITS, LICENSES, ETC. CONTRACTOR SHALL HAVE AT LEAST ONE SET OF APPROVED ENGINEERING PLANS AND SPECIFICATIONS ON-SITE AT ALL TIMES.
 5. ALL WORK SHALL CONFORM TO THE CITY OF ROCKWALL SPECIFICATIONS, STANDARDS, AND DETAILS.
 6. IF UNFORESEEN PROBLEMS OR CONFLICTS ARE ENCOUNTERED IN THE CONSTRUCTION, FOR WHICH AN IMMEDIATE SOLUTION IS NOT APPARENT, THE ENGINEER AND OWNER SHALL BE NOTIFIED IMMEDIATELY.
 7. IT WILL BE THE RESPONSIBILITY OF EACH CONTRACTOR TO PROTECT ALL EXISTING PUBLIC AND PRIVATE UTILITIES THROUGHOUT THE CONSTRUCTION OF THIS PROJECT. CONTRACTOR SHALL CONTACT THE APPROPRIATE UTILITY COMPANIES FOR LINE LOCATIONS, PRIOR TO COMMENCEMENT OF CONSTRUCTION AND SHALL ASSUME FULL LIABILITY TO THOSE COMPANIES FOR ANY DAMAGES CAUSED TO THEIR FACILITIES.
 8. CONTRACTORS SHALL BE RESPONSIBLE FOR FIELD LOCATING EXISTING UTILITIES AND IMPROVEMENTS PRIOR TO CONSTRUCTION.
 9. TRENCH SAFETY DESIGN WILL BE THE RESPONSIBILITY OF THE UTILITY CONTRACTOR, CONTRACTOR SHALL SUBMIT DESIGN TO THE CITY OF ROCKWALL ENGINEERING DEPARTMENT FOR REVIEW.
 10. MARK FIRE LANES TO CITY SPECIFICATION, "NO PARKING FIRE LANE" EVERY 25' WHITE 4" LETTERS ON A 6" RED STRIPED BACKGROUND.

ADDENDUM #1
PC - REMOVE STORM FLUME AND PARKING
PC - REMOVED STORM SEWER

Date / Revision /

11/22/2016	1
09/11/2017	2
12/04/2017	3



Project:
**ROCKWALL HIGH SCHOOL RENOVATIONS
FOR
ROCKWALL HIGH SCHOOL
ROCKWALL I.S.D.
901 YELLOW JACKET LN, ROCKWALL, TX 75087**



Huckabee
ASSIST - DALLAS - FORT WORTH - HOUSTON - WACO
www.huckabee-inc.com
800.687.1229


DETAILED ENTRY RAMP PLAN

100% CD	VOLUME
Job. No. 1738-02-01	Sheet No. CS
Drawn By: RAH	Date: 12-03-2016
1.3	

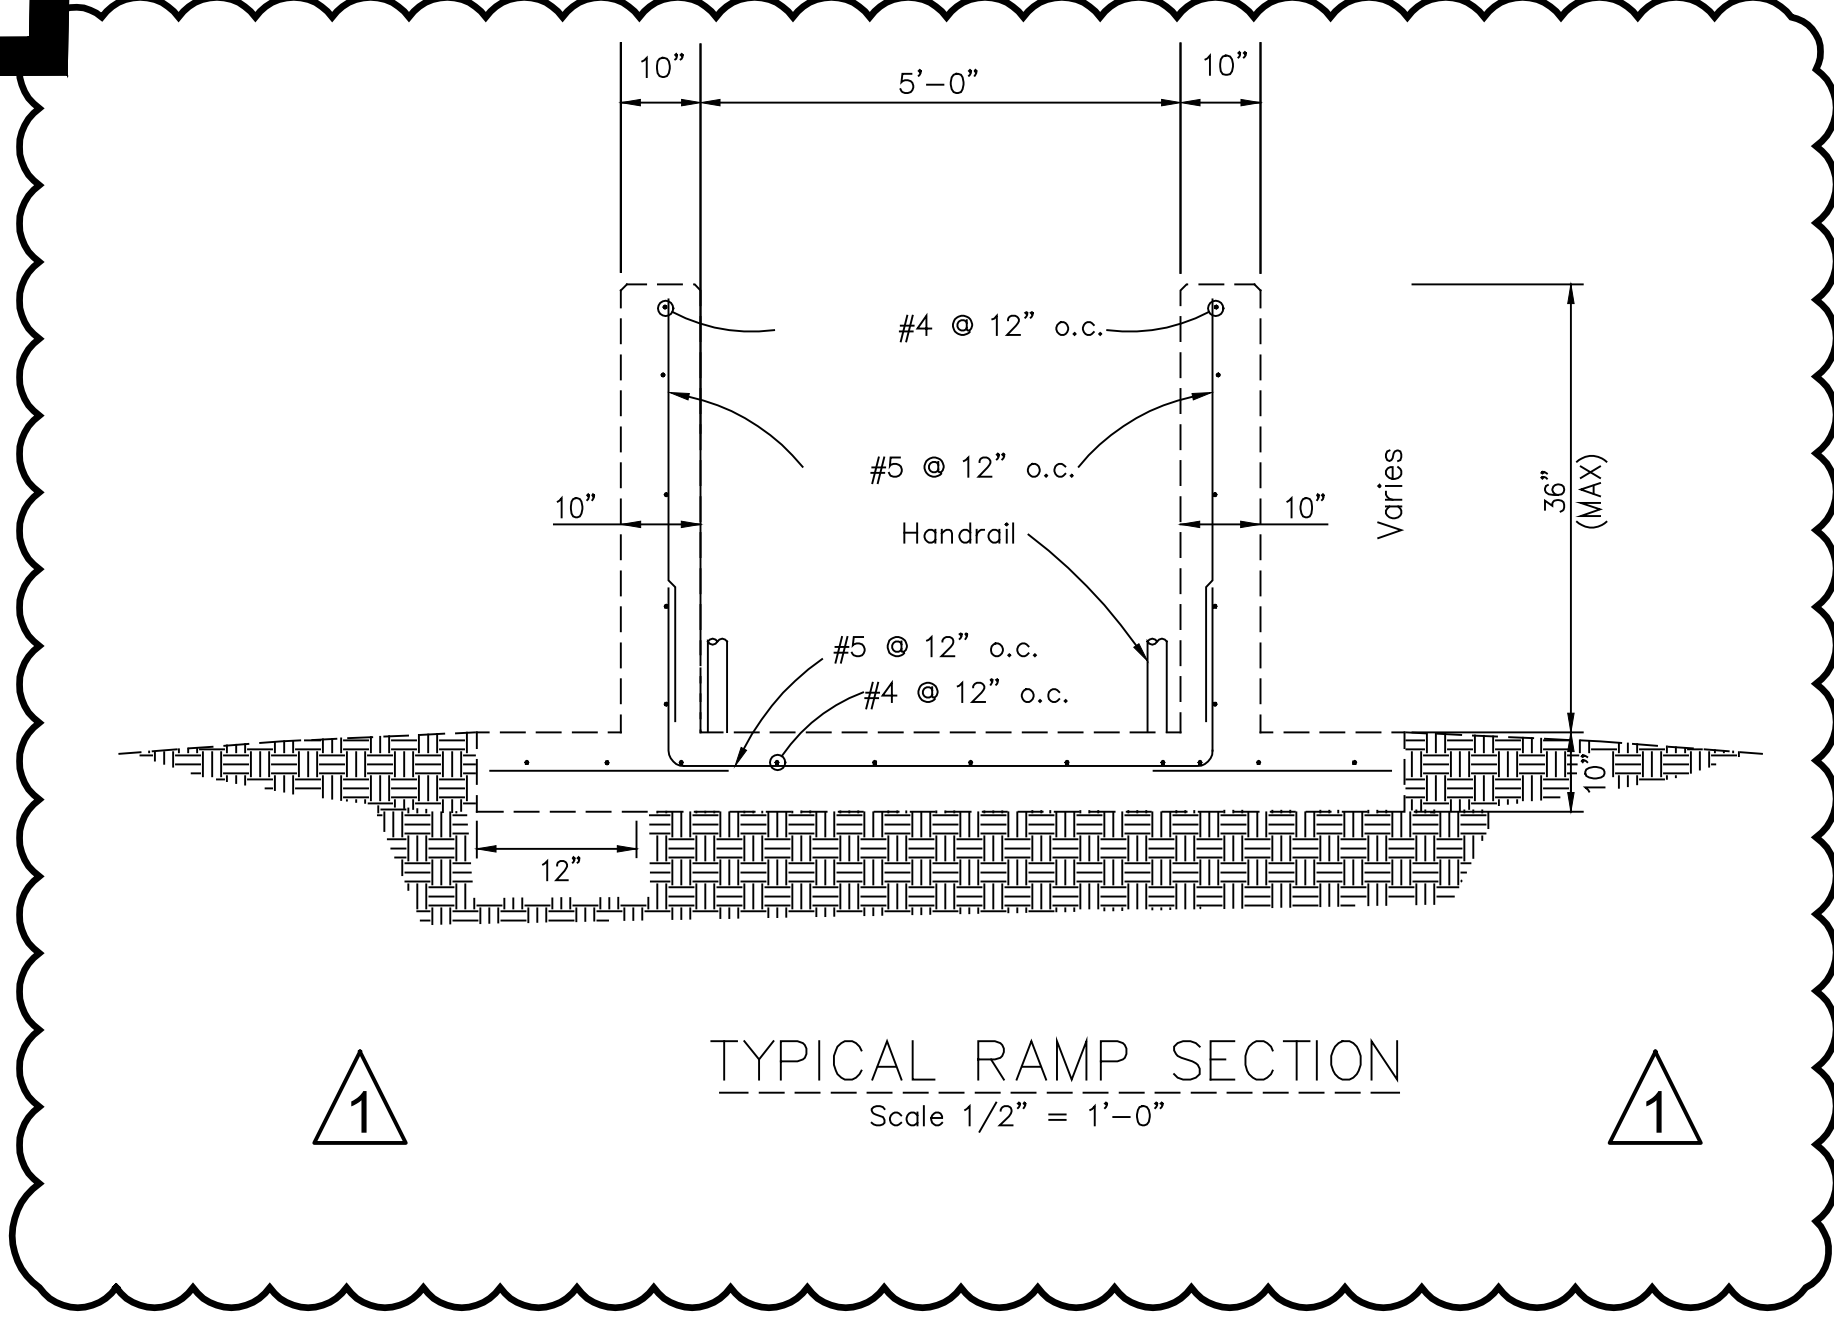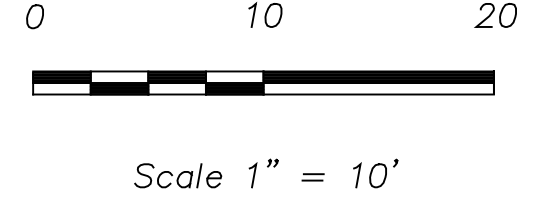

RECORD DRAWING
This is to certify that changes and corrections have been made to conform to the contractor's record of this project.
Signed: *Mike Glenn* Date: March 28, 2018
Glenn Engineering Corporation

GLENN ENGINEERING
TEXAS REGISTRATION NUMBER: F-303
PHONE 972-717-5151 FAX 972-717-2176
105 DECKER COURT, SUITE 910
IRVING, TEXAS 75062

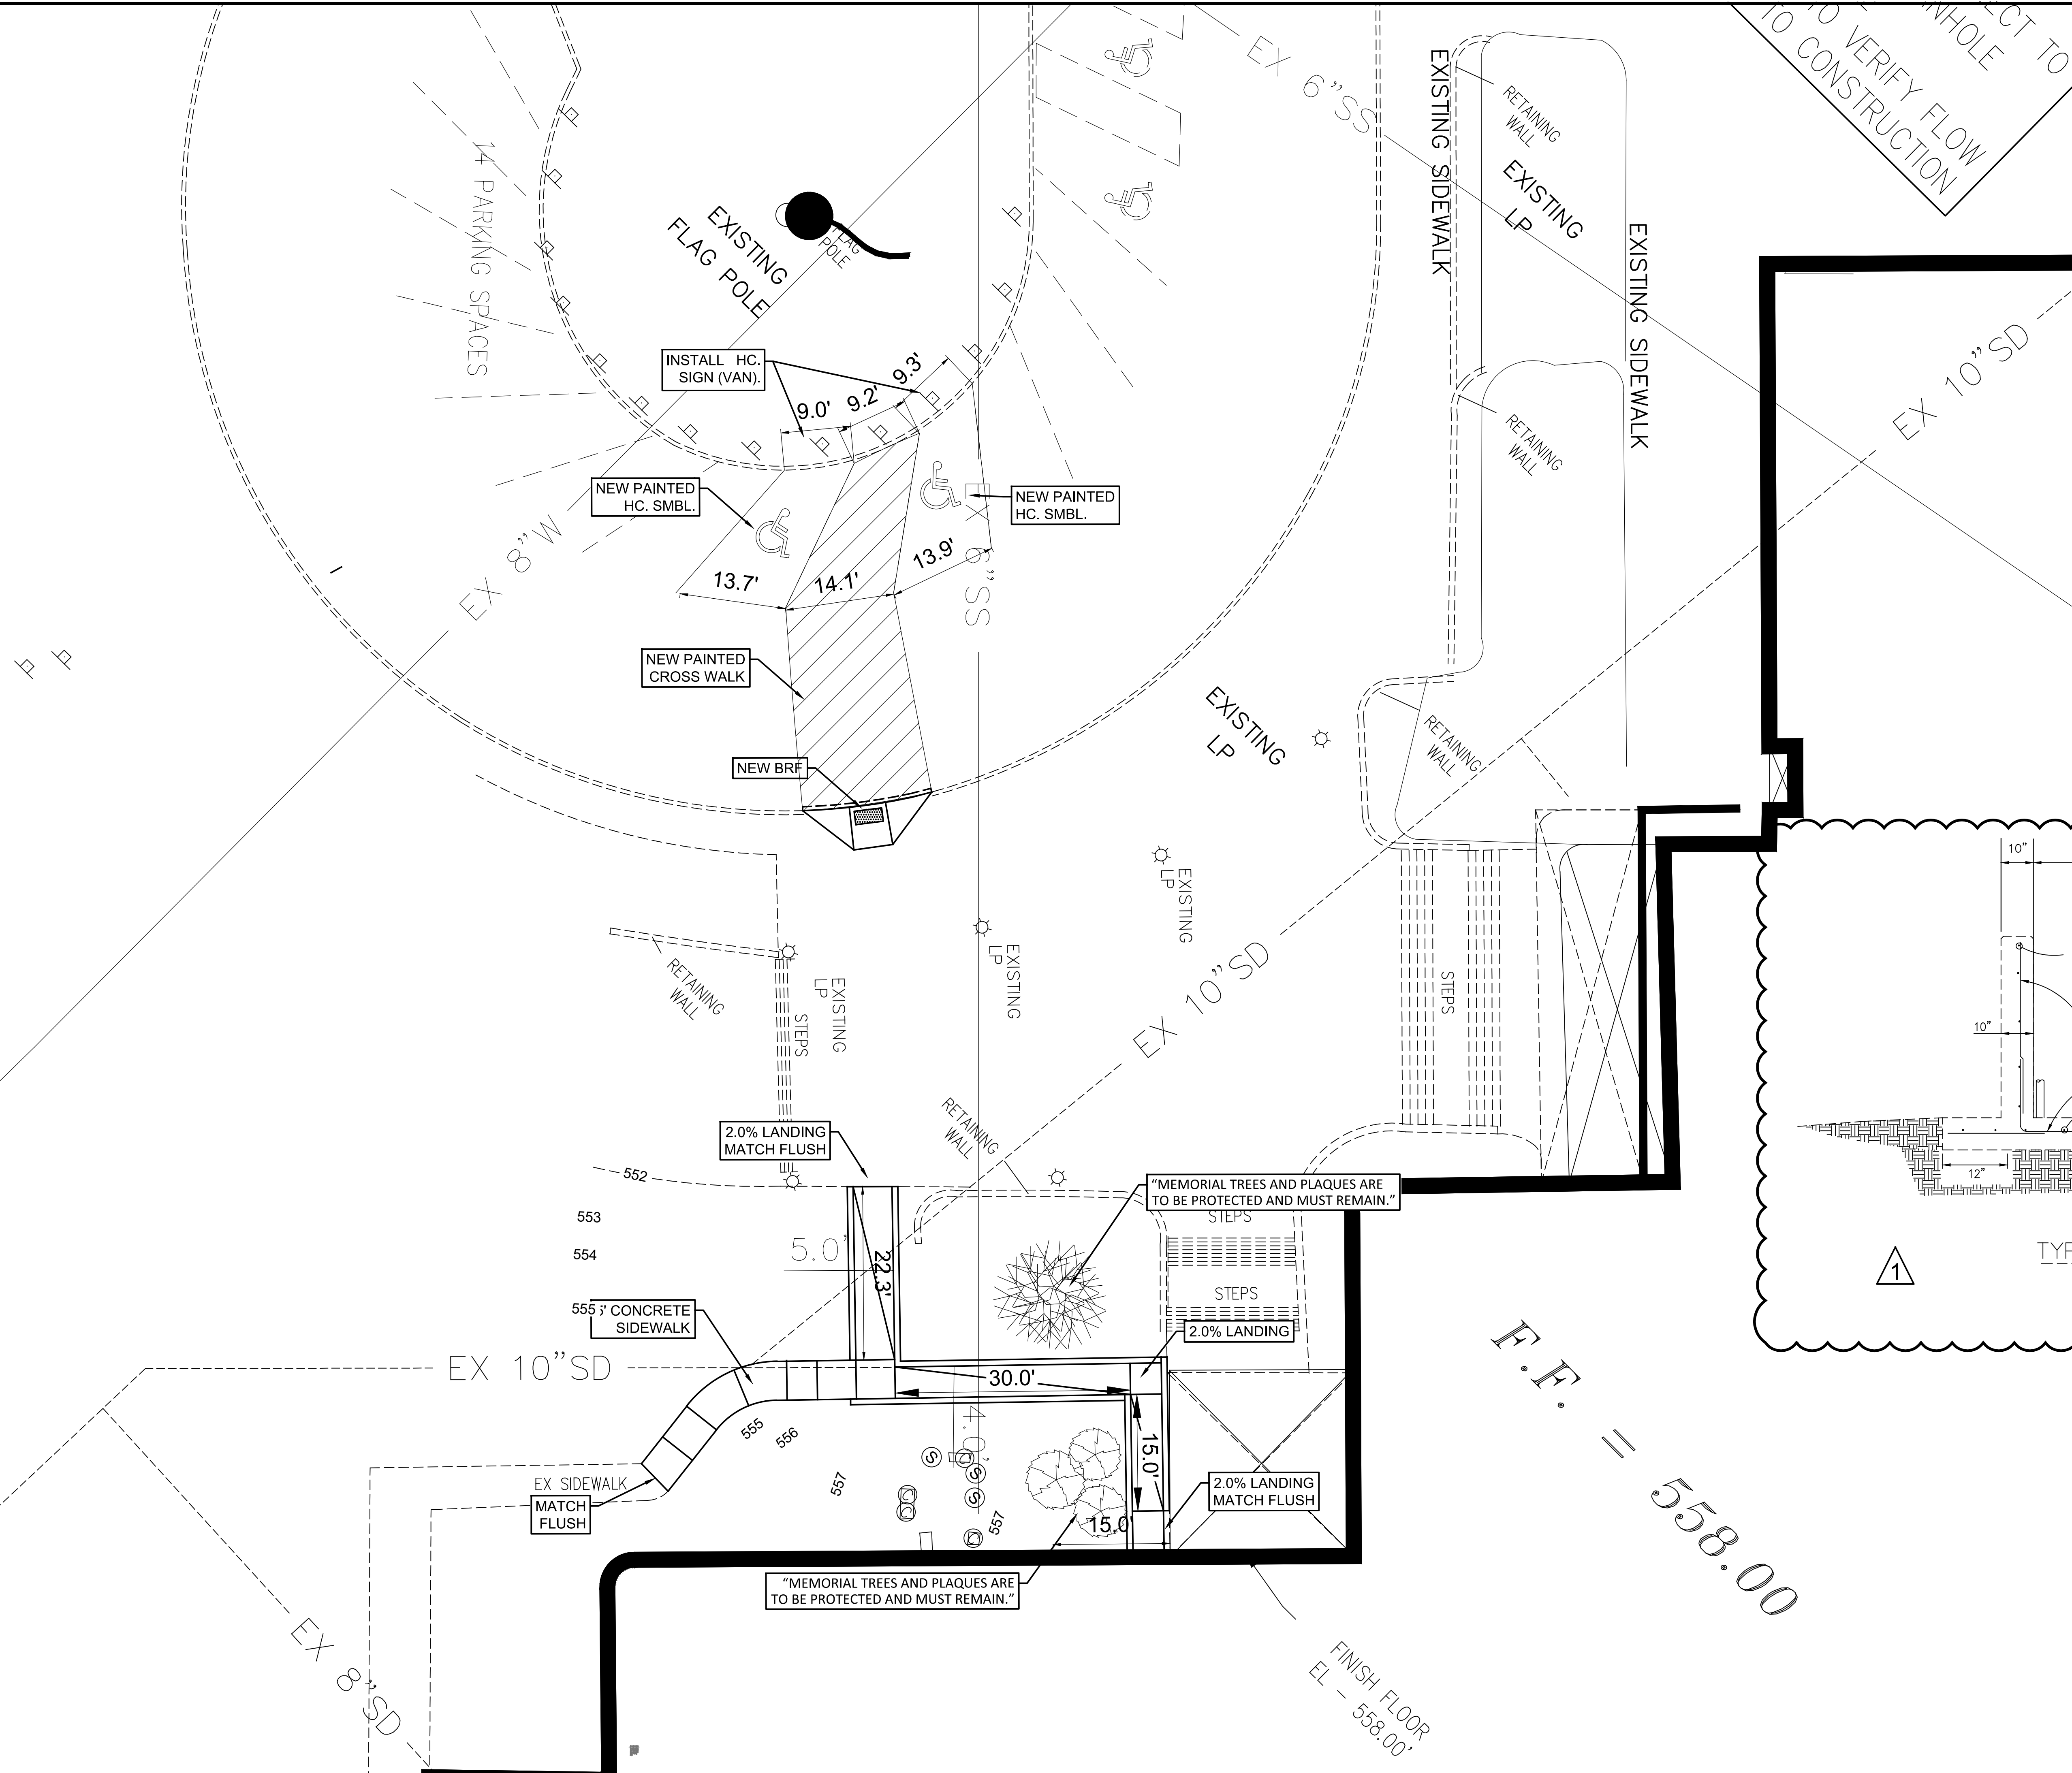

Plotted: Apr 20, 2018, 9:55 AM by user: robert. Saved: 4/20/2018 by user: robert. D:\Public\Bob's Projects\ROCKSDHigh-School\2016 WALL REPAIR\BIDSET\2016 ROCKWALL-HS ENGS REV STORM FLUME.dwg