


ROCKWALL ISD 1998 PAVING IMPROVEMENTS ROCKWALL HIGH SCHOOL PAVING IMPROVEMENTS ROCKWALL ISD ROCKWALL, TEXAS

ABBREVIATIONS


AA	ARCHITECTURAL WOODWORK ASSEMBLY
AB	ARCHITECTURAL
AC	ARCHITECTURAL
AD	ARCHITECTURAL
AE	ARCHITECTURAL
AF	ARCHITECTURAL
AG	ARCHITECTURAL
AH	ARCHITECTURAL
AI	ARCHITECTURAL
AM	ARCHITECTURAL
AN	ARCHITECTURAL
AO	ARCHITECTURAL
AP	ARCHITECTURAL
AQ	ARCHITECTURAL
AR	ARCHITECTURAL
AS	ARCHITECTURAL
AT	ARCHITECTURAL
AV	ARCHITECTURAL
AW	ARCHITECTURAL
AX	ARCHITECTURAL
AY	ARCHITECTURAL
AZ	ARCHITECTURAL
BA	ARCHITECTURAL
BB	ARCHITECTURAL
BC	ARCHITECTURAL
BD	ARCHITECTURAL
BE	ARCHITECTURAL
BF	ARCHITECTURAL
BG	ARCHITECTURAL
BH	ARCHITECTURAL
BI	ARCHITECTURAL
BJ	ARCHITECTURAL
BK	ARCHITECTURAL
BL	ARCHITECTURAL
BM	ARCHITECTURAL
BN	ARCHITECTURAL
BO	ARCHITECTURAL
BP	ARCHITECTURAL
BQ	ARCHITECTURAL
BR	ARCHITECTURAL
BS	ARCHITECTURAL
BT	ARCHITECTURAL
BV	ARCHITECTURAL
BW	ARCHITECTURAL
BX	ARCHITECTURAL
BY	ARCHITECTURAL
BZ	ARCHITECTURAL
CA	ARCHITECTURAL
CB	ARCHITECTURAL
CC	ARCHITECTURAL
CD	ARCHITECTURAL
CE	ARCHITECTURAL
CF	ARCHITECTURAL
CG	ARCHITECTURAL
CH	ARCHITECTURAL
CI	ARCHITECTURAL
CJ	ARCHITECTURAL
CK	ARCHITECTURAL
CL	ARCHITECTURAL
CM	ARCHITECTURAL
CN	ARCHITECTURAL
CO	ARCHITECTURAL
CP	ARCHITECTURAL
CQ	ARCHITECTURAL
CR	ARCHITECTURAL
CS	ARCHITECTURAL
CT	ARCHITECTURAL
CV	ARCHITECTURAL
CW	ARCHITECTURAL
CX	ARCHITECTURAL
CY	ARCHITECTURAL
CZ	ARCHITECTURAL
DA	ARCHITECTURAL
DB	ARCHITECTURAL
DC	ARCHITECTURAL
DD	ARCHITECTURAL
DE	ARCHITECTURAL
DF	ARCHITECTURAL
DG	ARCHITECTURAL
DH	ARCHITECTURAL
DI	ARCHITECTURAL
DJ	ARCHITECTURAL
DK	ARCHITECTURAL
DL	ARCHITECTURAL
DM	ARCHITECTURAL
DN	ARCHITECTURAL
DO	ARCHITECTURAL
ZT	ARCHITECTURAL
ZV	ARCHITECTURAL
ZW	ARCHITECTURAL
ZX	ARCHITECTURAL
ZY	ARCHITECTURAL
ZZ	ARCHITECTURAL



PLAN SYMBOLS

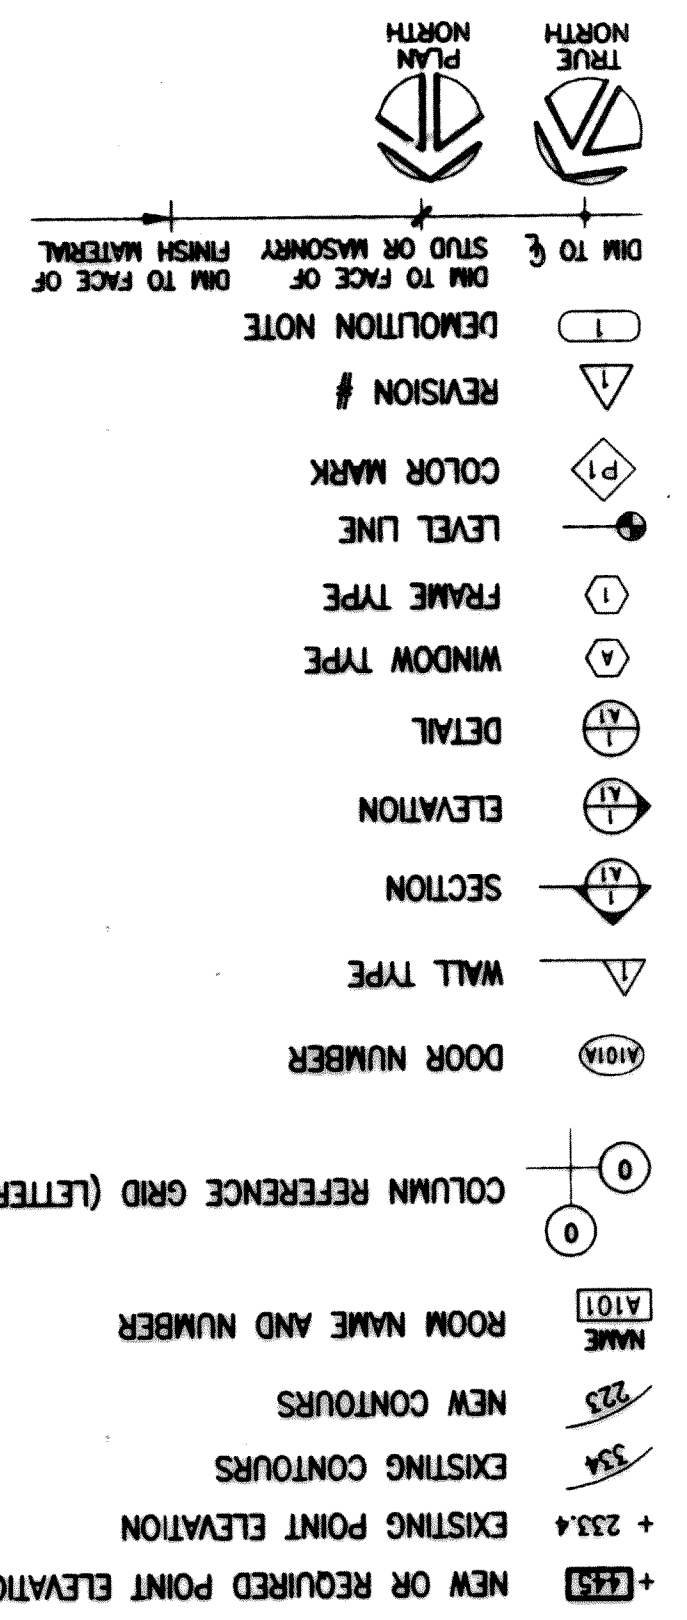

MATERIAL LEGEND

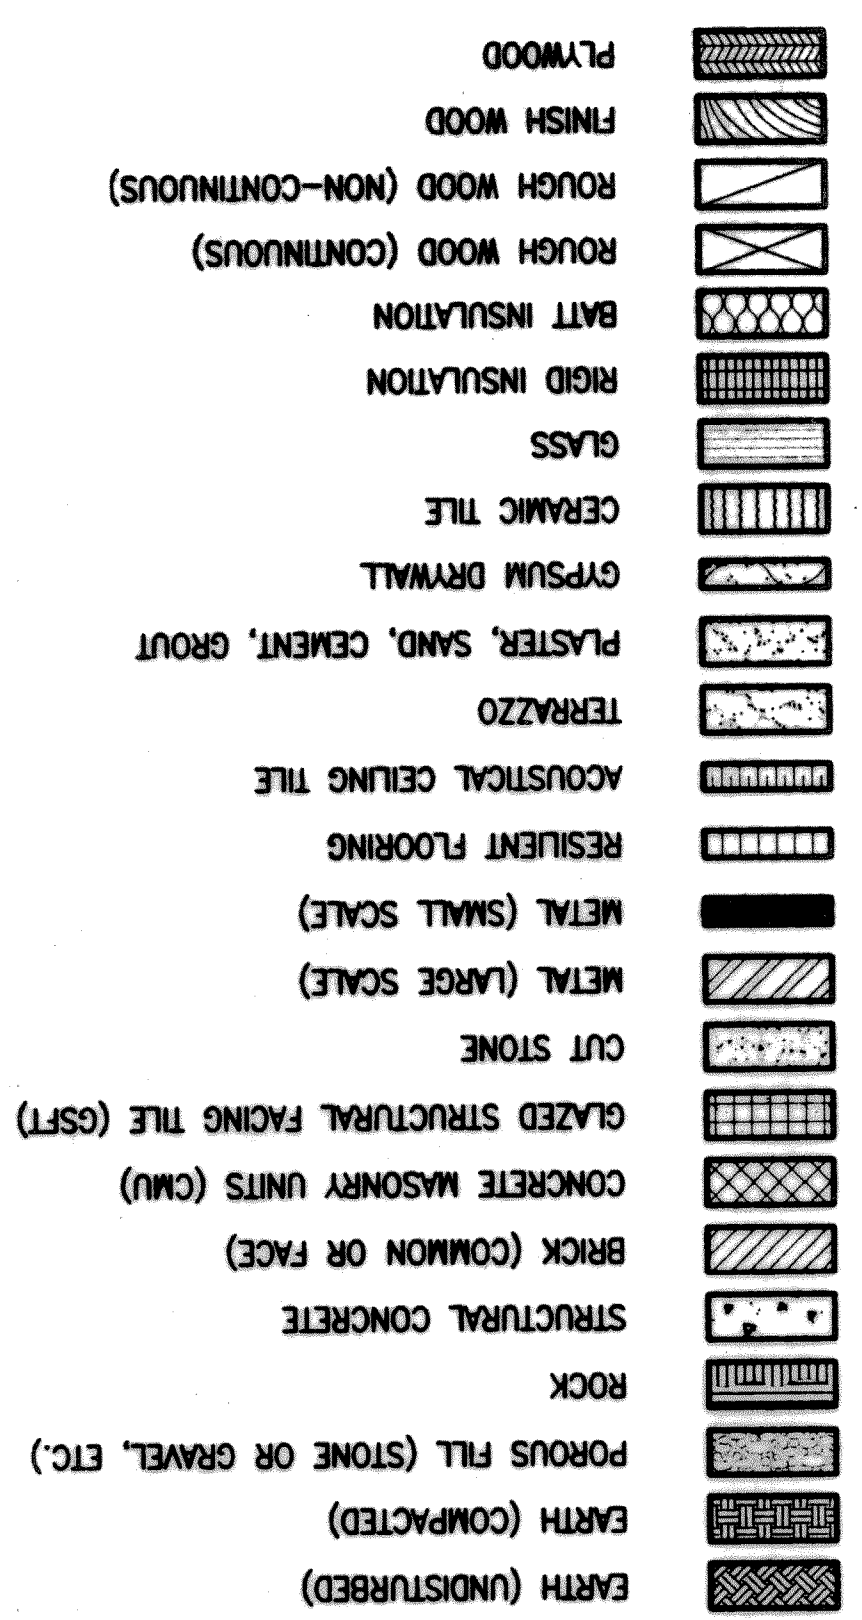

INDEX OF DRAWINGS

01.1	GENERAL	COVER SHEET
02.0	TOPOGRAPHIC SURVEY	
02.1	THREE SURVEY	
02.2	SITE, STRIPING AND DIMENSIONAL CONTROL PLAN	
02.2A	SITE, STRIPING AND DIMENSIONAL CONTROL PLAN	
02.3	PAVING PLAN	
02.4	SITE GRADING PLAN	
02.4A	ON SITE GRADING PLAN	
02.6	DRAINAGE AREA MAP	
02.6A	DRAINAGE AREA MAP	
02.7	STORM SEWER PROFILES	
02.8	STORM SEWER PROFILES	
02.9	PAVING DETAIL SHEET	
02.10	PAVING DETAIL SHEET	
02.11	STORM SEWER DETAIL	
02.12	SEDIMENT CONTROL PLAN	
02.13	SEDIMENT CONTROL DETAILS	
03.0	ELECTRICAL	LIGHTING SITE PLAN

© 1988 SHW Group, Inc.

SET NUMBER

OF 1

SHEET NUMBER G

SHW Group Inc. Architects - Engineers

FINAL PLANS FOR BIDDING AND CONSTRUCTION

ROCKWALL ISD 1998 PAVING IMPROVEMENTS

ROCKWALL HIGH SCHOOL PAVING IMPROVEMENTS

ROCKWALL ISD ROCKWALL, TEXAS

DATE AUGUST 19, 1998

DRAWN BY

CHECKED

CUDA NO. 1498433

REVISED