


- GENERAL NOTES**
1. THE GENERAL CONTRACTOR MUST VERIFY ALL EXISTING CONDITIONS AND REPORT ANY DISCREPANCIES TO THE ARCHITECT BEFORE BEGINNING WORK.
 2. REPAIR AND REPLACE ALL EXISTING SIDEWALKS AND PAVING TO REMAIN THAT ARE DAMAGED DUE TO CONSTRUCTION.
 3. PROTECT ALL PLANTING FROM DAMAGE DUE TO CONSTRUCTION. EXISTING TREES & SHRUBS WILL BE RELOCATED BY G.C.
 4. ALL AREAS OF CONSTRUCTION SHALL BE FENCED AND SECURED THROUGHOUT THE PROJECT. THE CONTRACTOR SHALL VERIFY EXTENT OF FENCING REQUIRED DUE TO STAGING AREAS, JOBSITE TRAILER LOCATIONS, ETC.
 5. THE CONTRACTOR SHALL COORDINATE WITH THE OWNER TO DETERMINE ACCESSIBLE WALKING ROUTES FROM THE PARKING AREAS TO THE SCHOOL. ACCESSIBLE WALKING ROUTES TO KEEP SCHOOL PERSONNEL SEPARATED FROM ACCESS ROUTES IF REQUIRED.

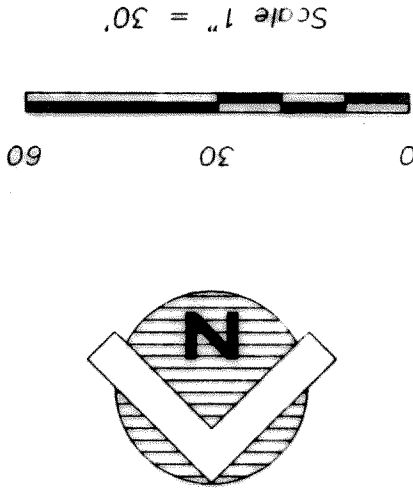

NOTE:
 Contractor shall remove all splitter heads and equipment in the areas shown on this drawing. At the completion of the construction project, the contractor is responsible for installation of irrigation system throughout the area shown on this drawing. Owner will provide the equipment. On the same as that which was removed. Any additional equipment required will be by the contractor.

- LEGEND**
- EXISTING ASPHALT PAVEMENT
 - PROPOSED CONCRETE PAVEMENT
 - PROPOSED 6' WIDE SIDEWALK
 - 2-4" PVC SLEEVES
 - SEE SHEET 29 FOR PAVING DETAILS

GLENN ENGINEERING

PHONE 944-77-8511
 100 DECKER COURT - SUITE 200
 ROCKWALL, TEXAS 75087

SET NUMBER
2.2A

OF
2.2A

SHEET NUMBER
C

ON SITE, STRIPING AND DIMENSIONAL CONTROL PLAN

SCALE: 1" = 30'

STATE OF TEXAS
 ENGINEER
 M. J. [Signature]
 10/13/98

ROCKWALL, TEXAS
 ENGINEER
 M. J. [Signature]
 10/13/98

DATE: JULY 7, 1998
 DRAWN BY: R. HOFFMAN
 CHECKED: R.A.H.
 COMM. NO. 0494453
 REVISED: OCTOBER 9, 1998

ROCKWALL I.S.D. 1998 PAVING IMPROVEMENTS
 ROCKWALL HIGH SCHOOL PAVING IMPROVEMENTS
 ROCKWALL I.S.D. ROCKWALL, TEXAS

