

# STORM SEWER PROFILES




SCALE: 1"=40'



PHONE 214-771-9151  
500 BUCKNER COURT - SUITE 200  
IRVING, TEXAS 75038

SET NUMBER  
OF  
2.8

SHEET NUMBER  
C

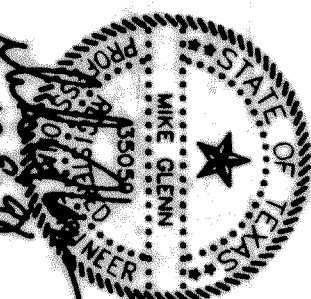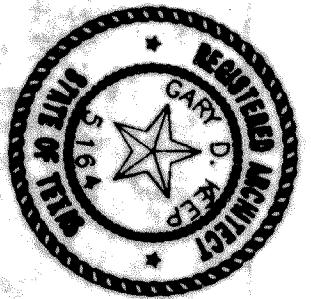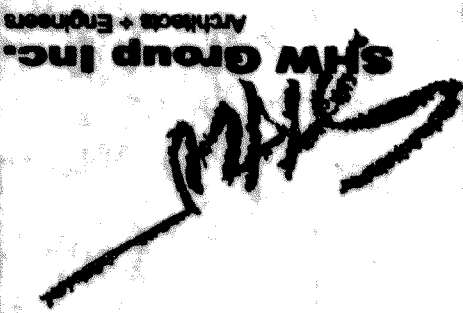

ROCKWALL I.S.D. 1998 PAVING IMPROVEMENTS  
ROCKWALL HIGH SCHOOL PAVING IMPROVEMENTS  
ROCKWALL I.S.D. ROCKWALL, TEXAS

DATE: JULY 7, 1998  
DRAWN BY: R. HOWMAN  
CHECKED: R.A.H.  
CONTRACT NO: 0494453  
REVISED: OCTOBER 9, 1998

