



GATE INLET  
SCALE: 1" = 1'

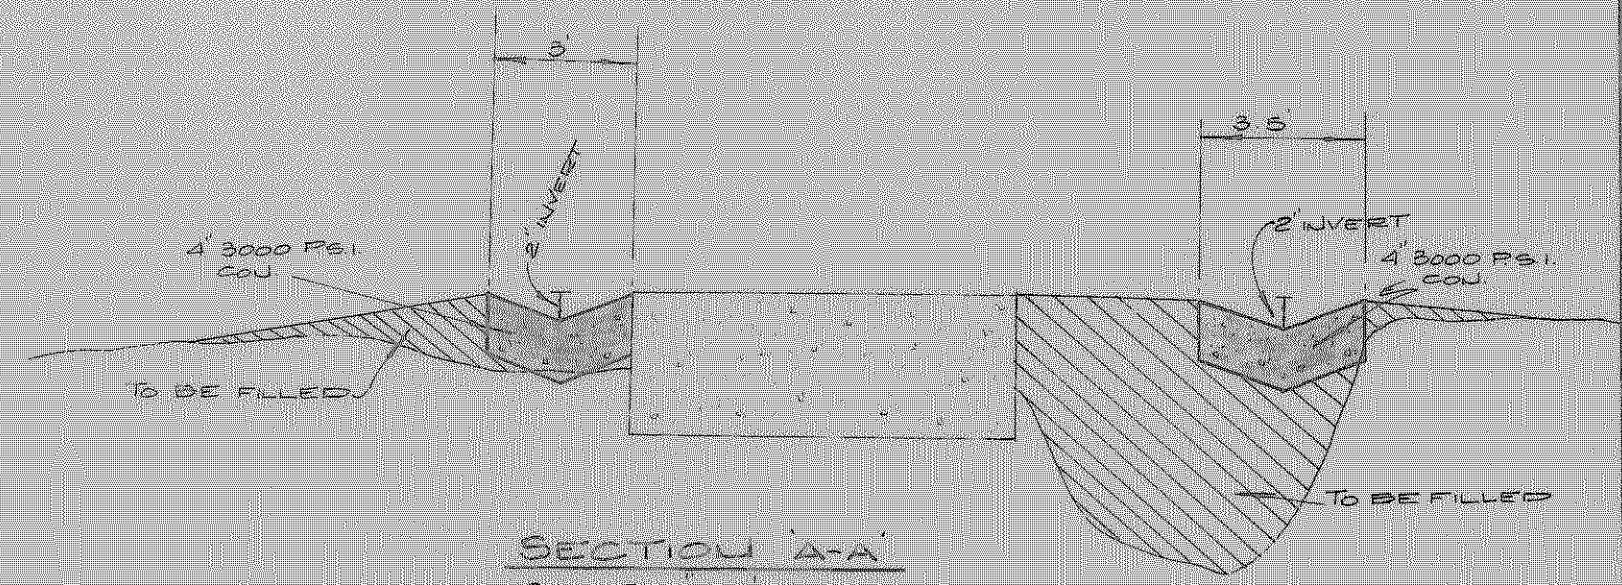

SECTION A-A  
SCALE: 1" = 4' H  
1" = 1' V

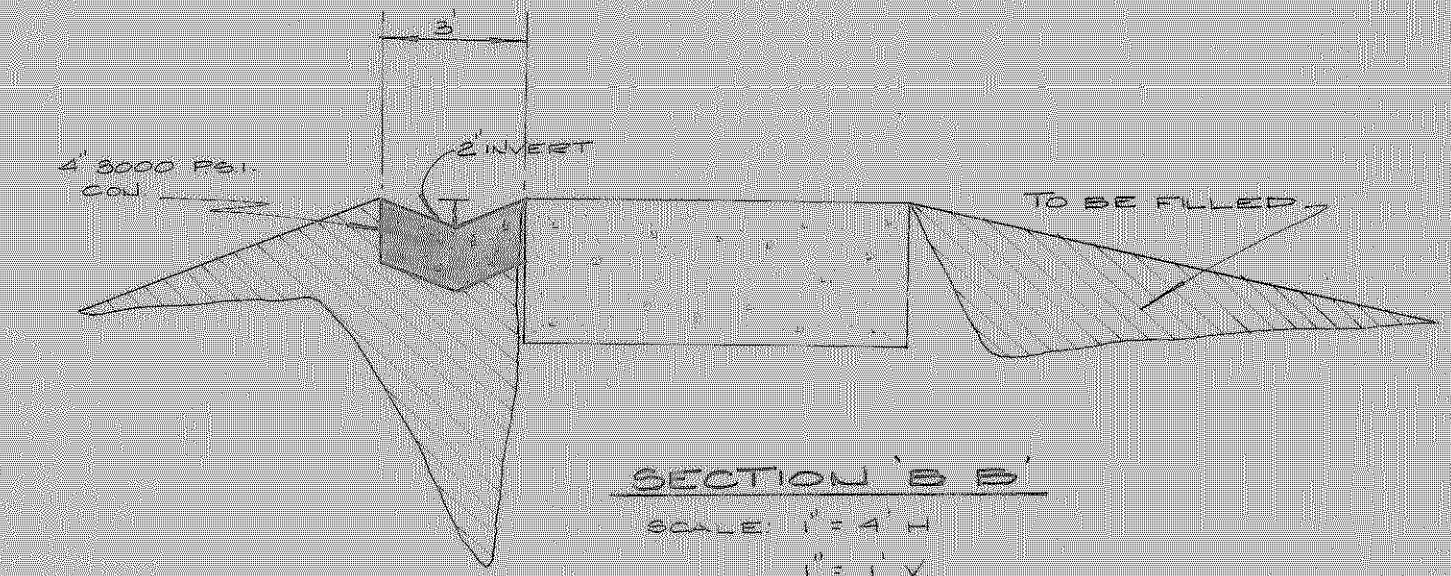

SECTION B-B  
SCALE: 1" = 4' H  
1" = 1' V

C (RUNOFF FACTOR) = 0.60  
I 10 min. TC = 7.8  
CI = G(TB) = 4.68

BENCH MARK:  
FINISH FLOOR OF MIDDLE  
SCHOOL CLASS ROOMS.  
ELEV. 127.67



AS BUILT

DRAINAGE IMPROVEMENTS				ROCKWALL TEXAS	
ROCKWALL MIDDLE SCHOOL					
DESIGN H.L.E.	DRAWN D.E.O. D.M.	SCALE 1" = 30'	DATE 5.25-73	DES-BIB HAROLD L. EVANS, CONSULTING ENGINEER, DALLAS	